
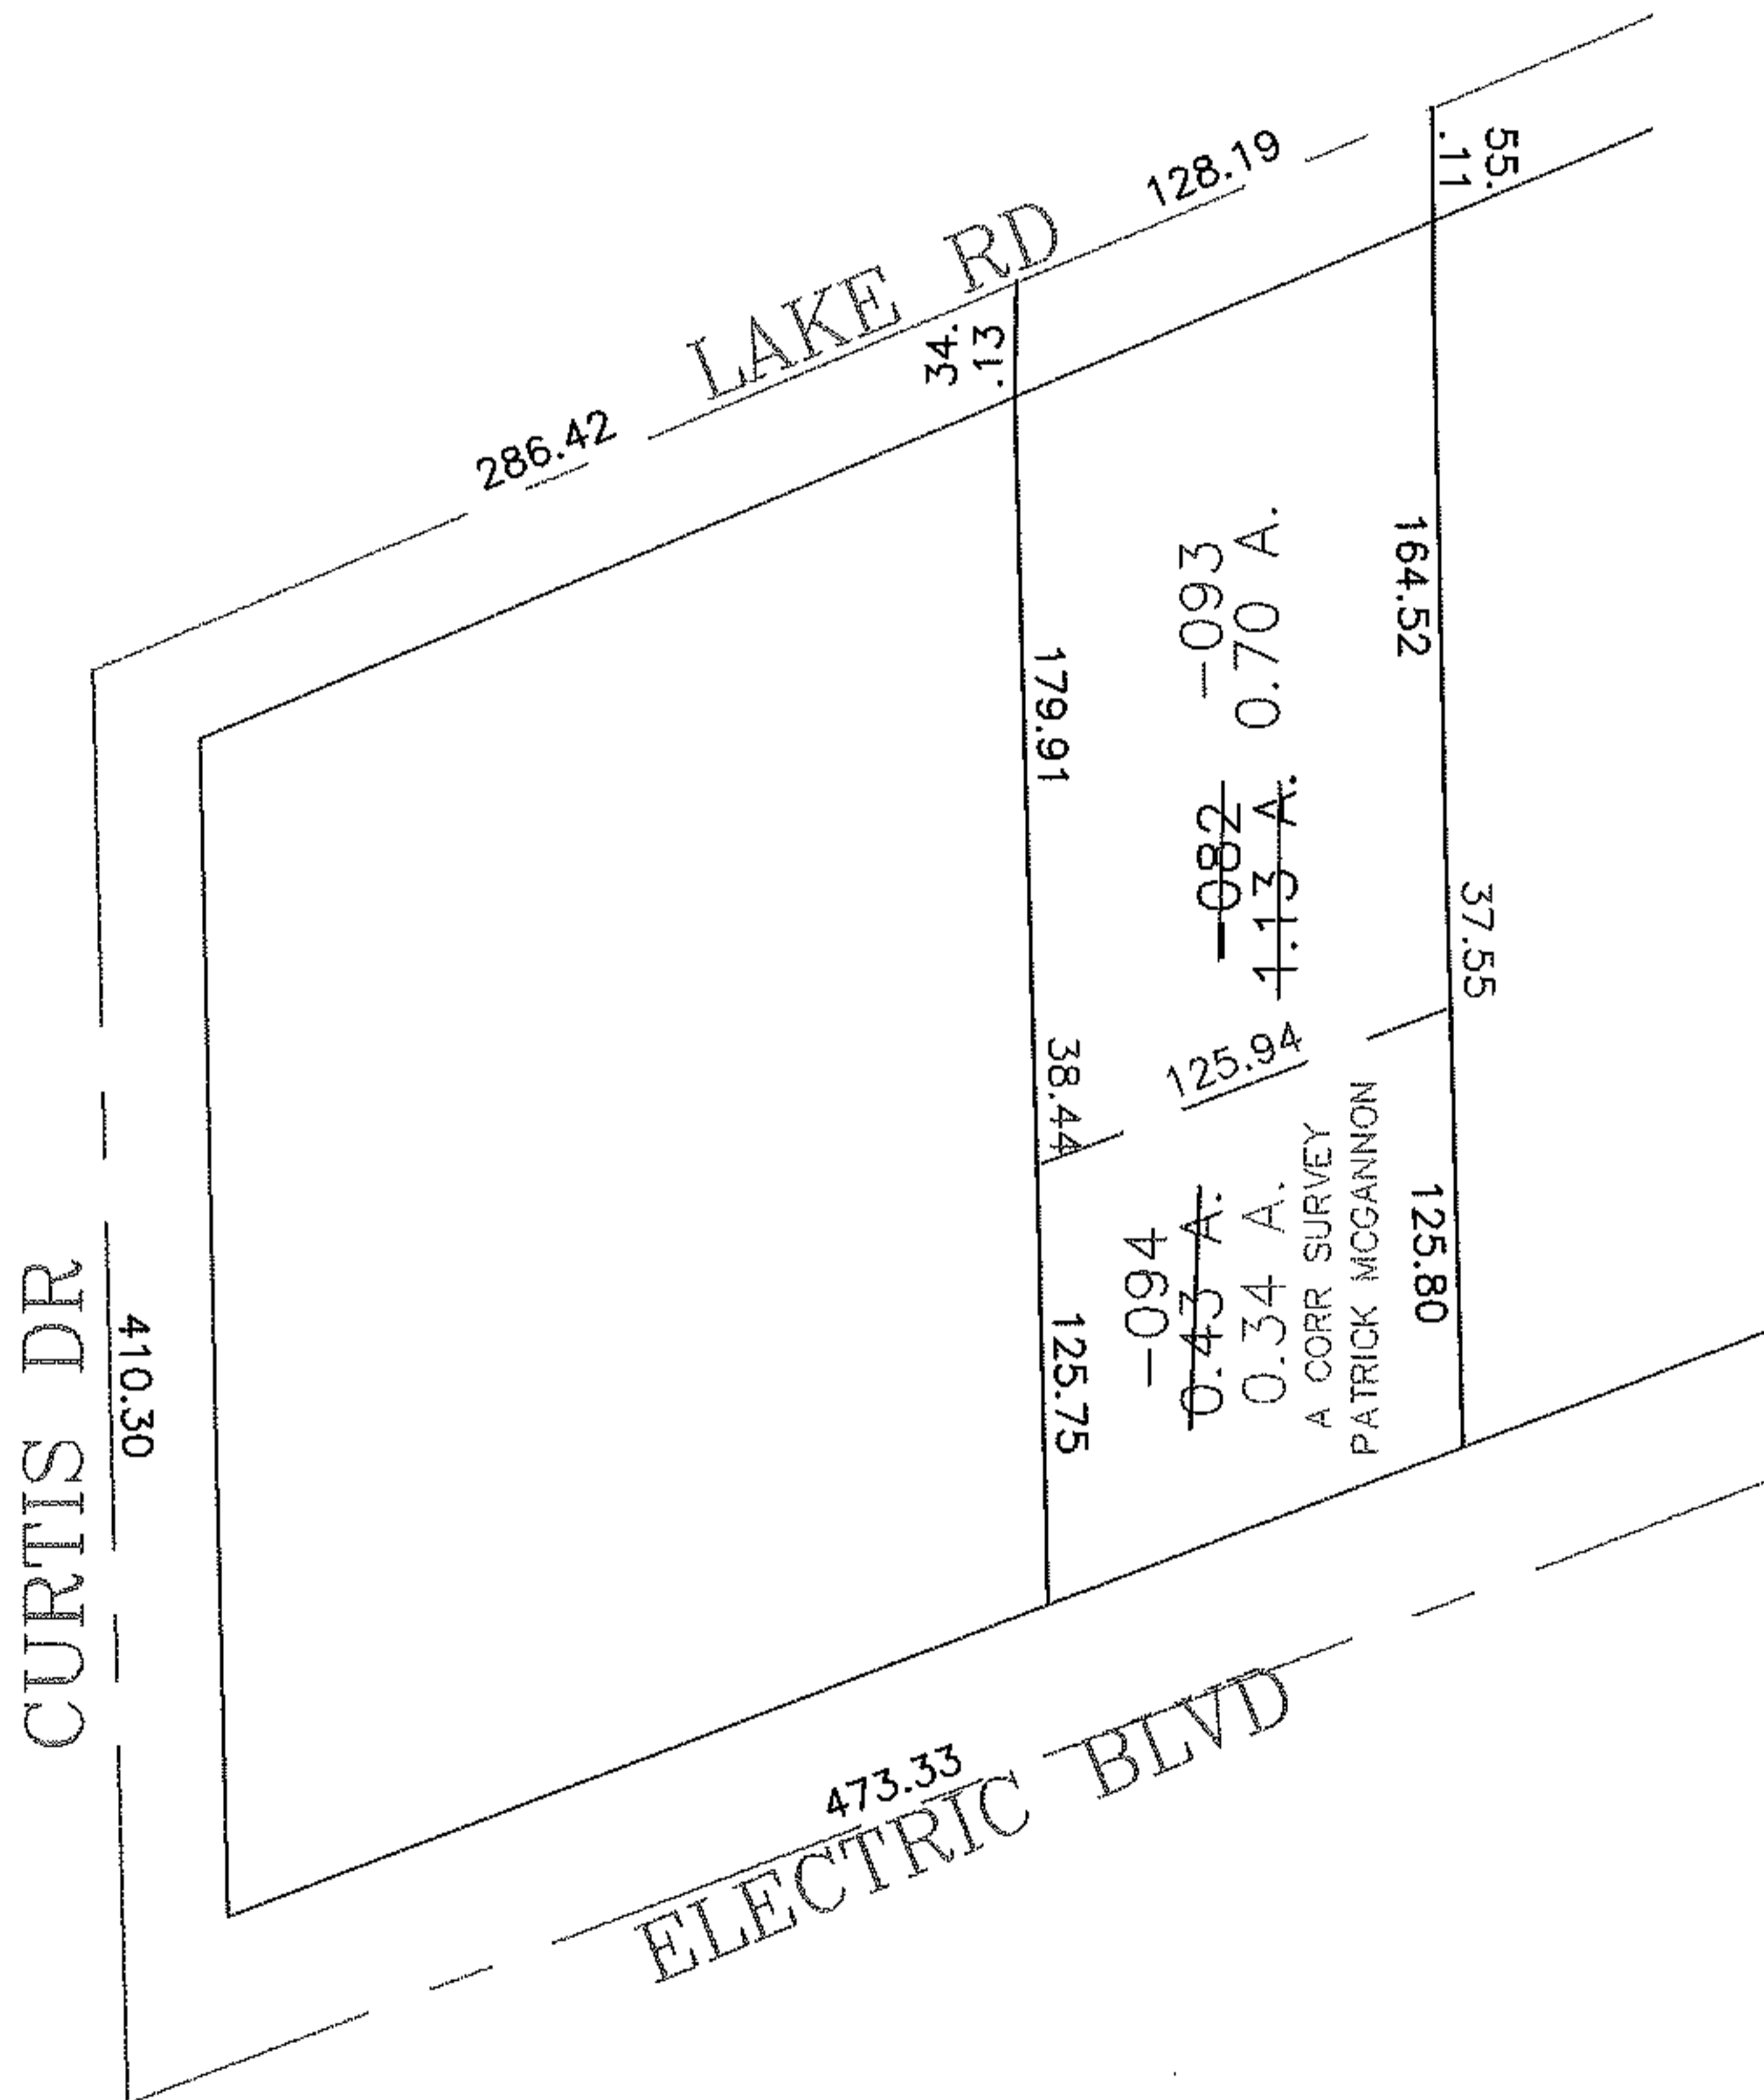


PARENT PARCEL: 04-00-007-107-082

CHILD PARCEL: 04-00-007-107-093, -094

STARTING POINT: CENTERLINE OF CURTIS DR & LAKE RD

08-02642

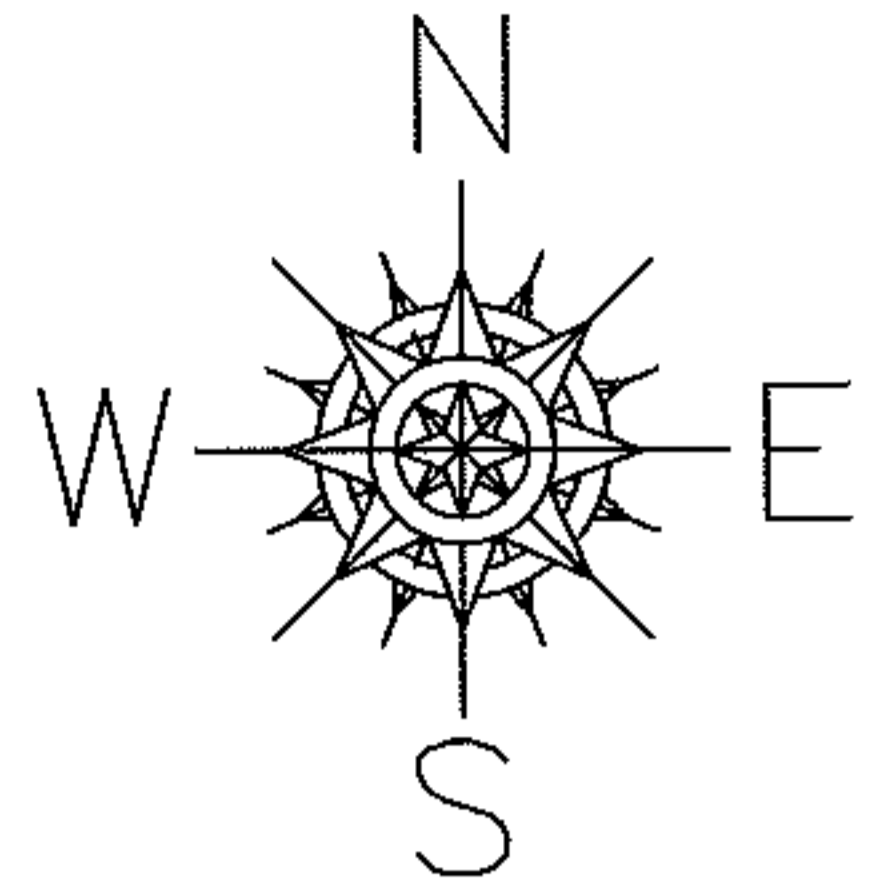

SPLITS/DEEDS PROCESSED

LORAIN COUNTY TAX MAP DEPARTMENT
226 MIDDLE AVE. ELYRIA, OHIO

SURVEYED BY: PATRICK MCGANNON

CLOSURE: 0.00 : 10.000

MAP PAGE(S): 04-00-007-C

APPROVED BY: JAH DATE: 11-25-08

SCALE: 1" = 100' PRIOR INSTRUMENT: PL VL 84/76