
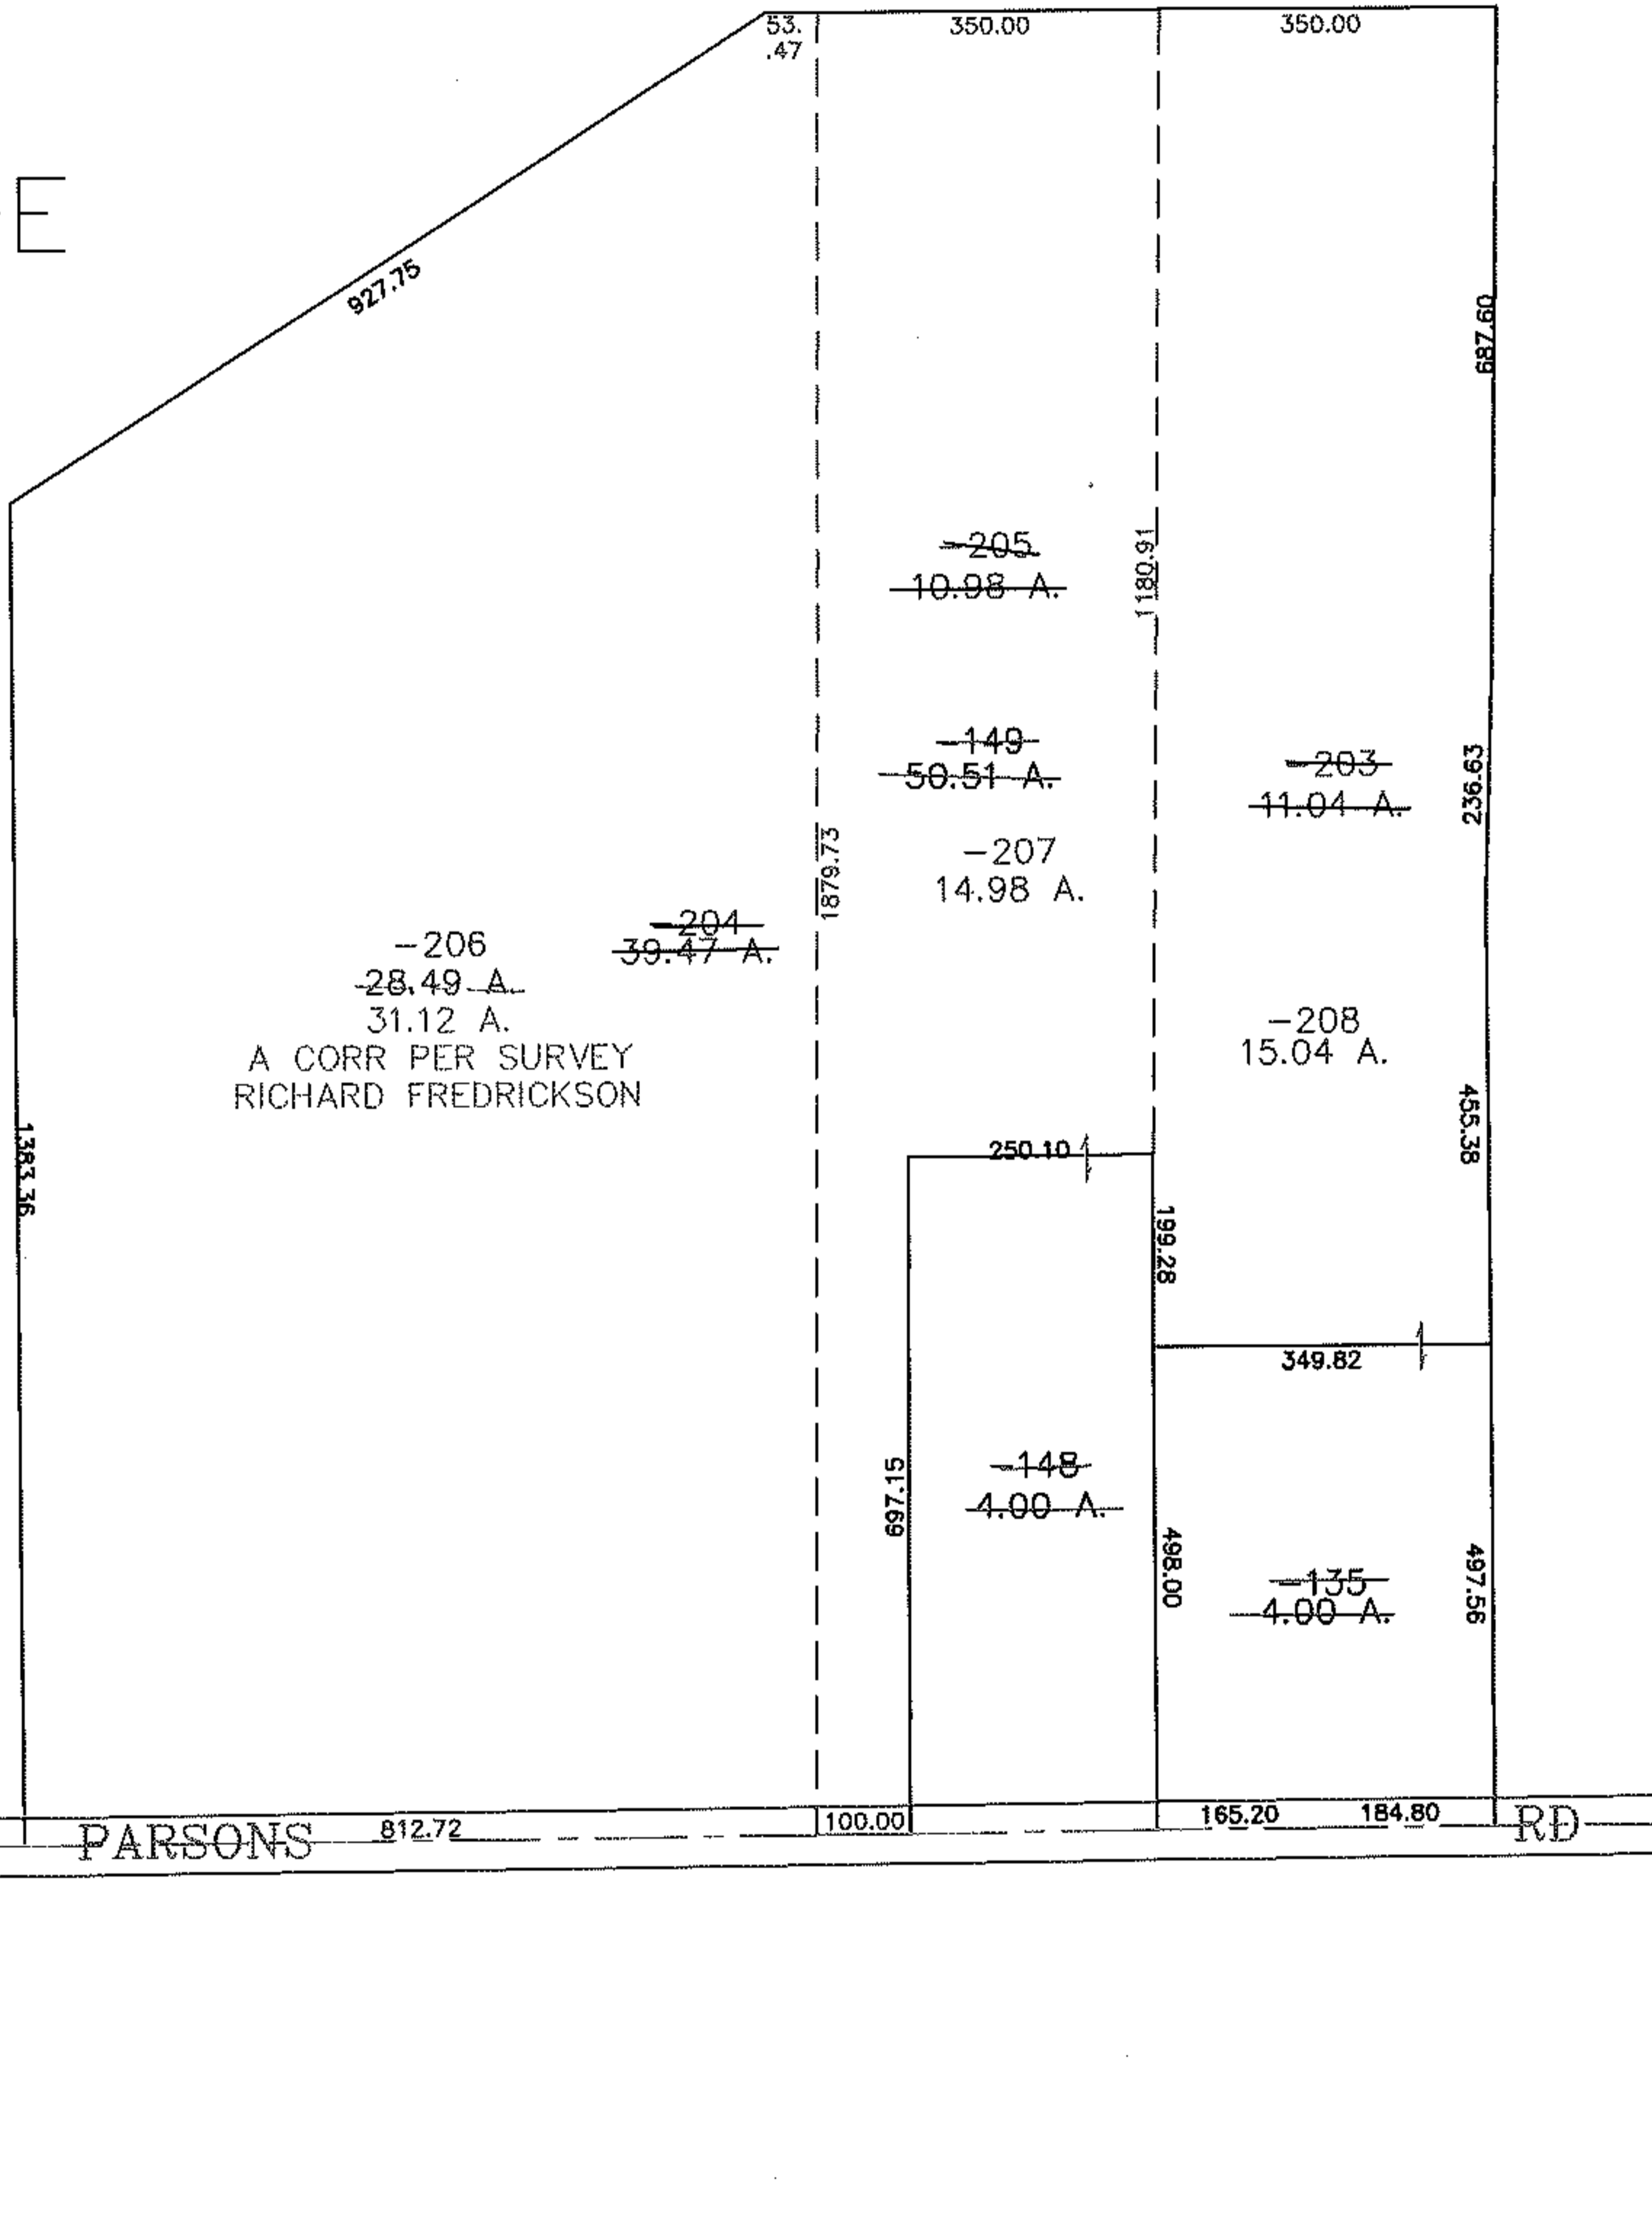


PARENT PARCEL: 10-00-024-000-149, 148, -135
CHILD PARCEL: 10-00-024-000-203 THRU -208
STARTING POINT: CENTERLINE OF PARSONS RD & WHEELER RD

08-02643

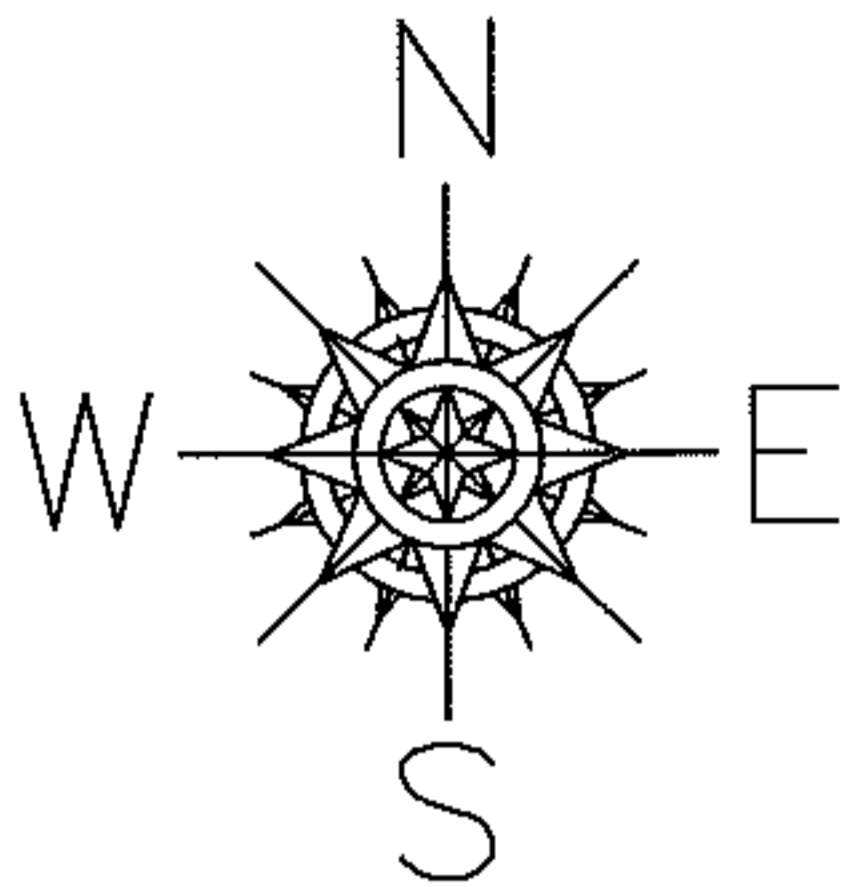

-206
28.49 A.
31.12 A.
A CORR PER SURVEY
RICHARD FREDRICKSON

~~-204~~
39.47 A.

~~-205~~
10.98 A.

~~-149~~
50.51 A.


-207
14.98 A.

~~-203~~
11.04 A.

-208
15.04 A.

~~-148~~
4.00 A.

~~-135~~
4.00 A.

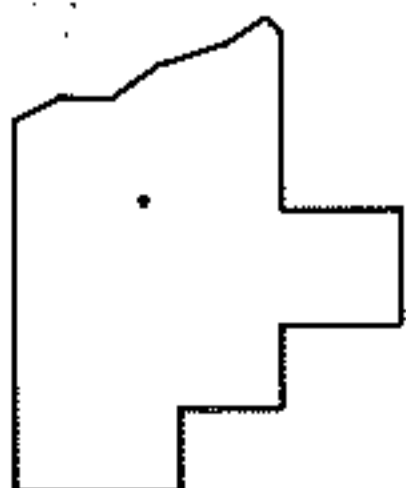

SPLITS/DEEDS PROCESSED
LORAIN COUNTY TAX MAP DEPARTMENT
226 MIDDLE AVE. ELYRIA, OHIO

SURVEYED BY: RICHARD FREDRICKSON
CLOSURE: 0.00 : 10.000
MAP PAGE(S): 10-00-024-H
APPROVED BY: JAH DATE: 12-3-08
SCALE: 1" = 300 PRIOR INSTRUMENT: DV 1361/175