




RASTER

PARENT PARCEL: 04-00-015-103-083

CHILD PARCEL: 04-00-015-103-085 THRU -089

STARTING POINT: MAG. NAIL, CL OF MIDDLETON & CL OF DETROIT RD. (S.R. 254)

NO. 08-02644

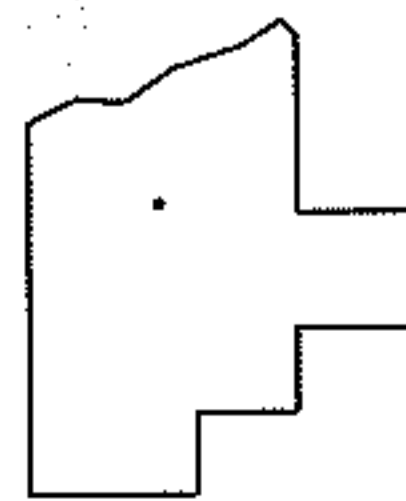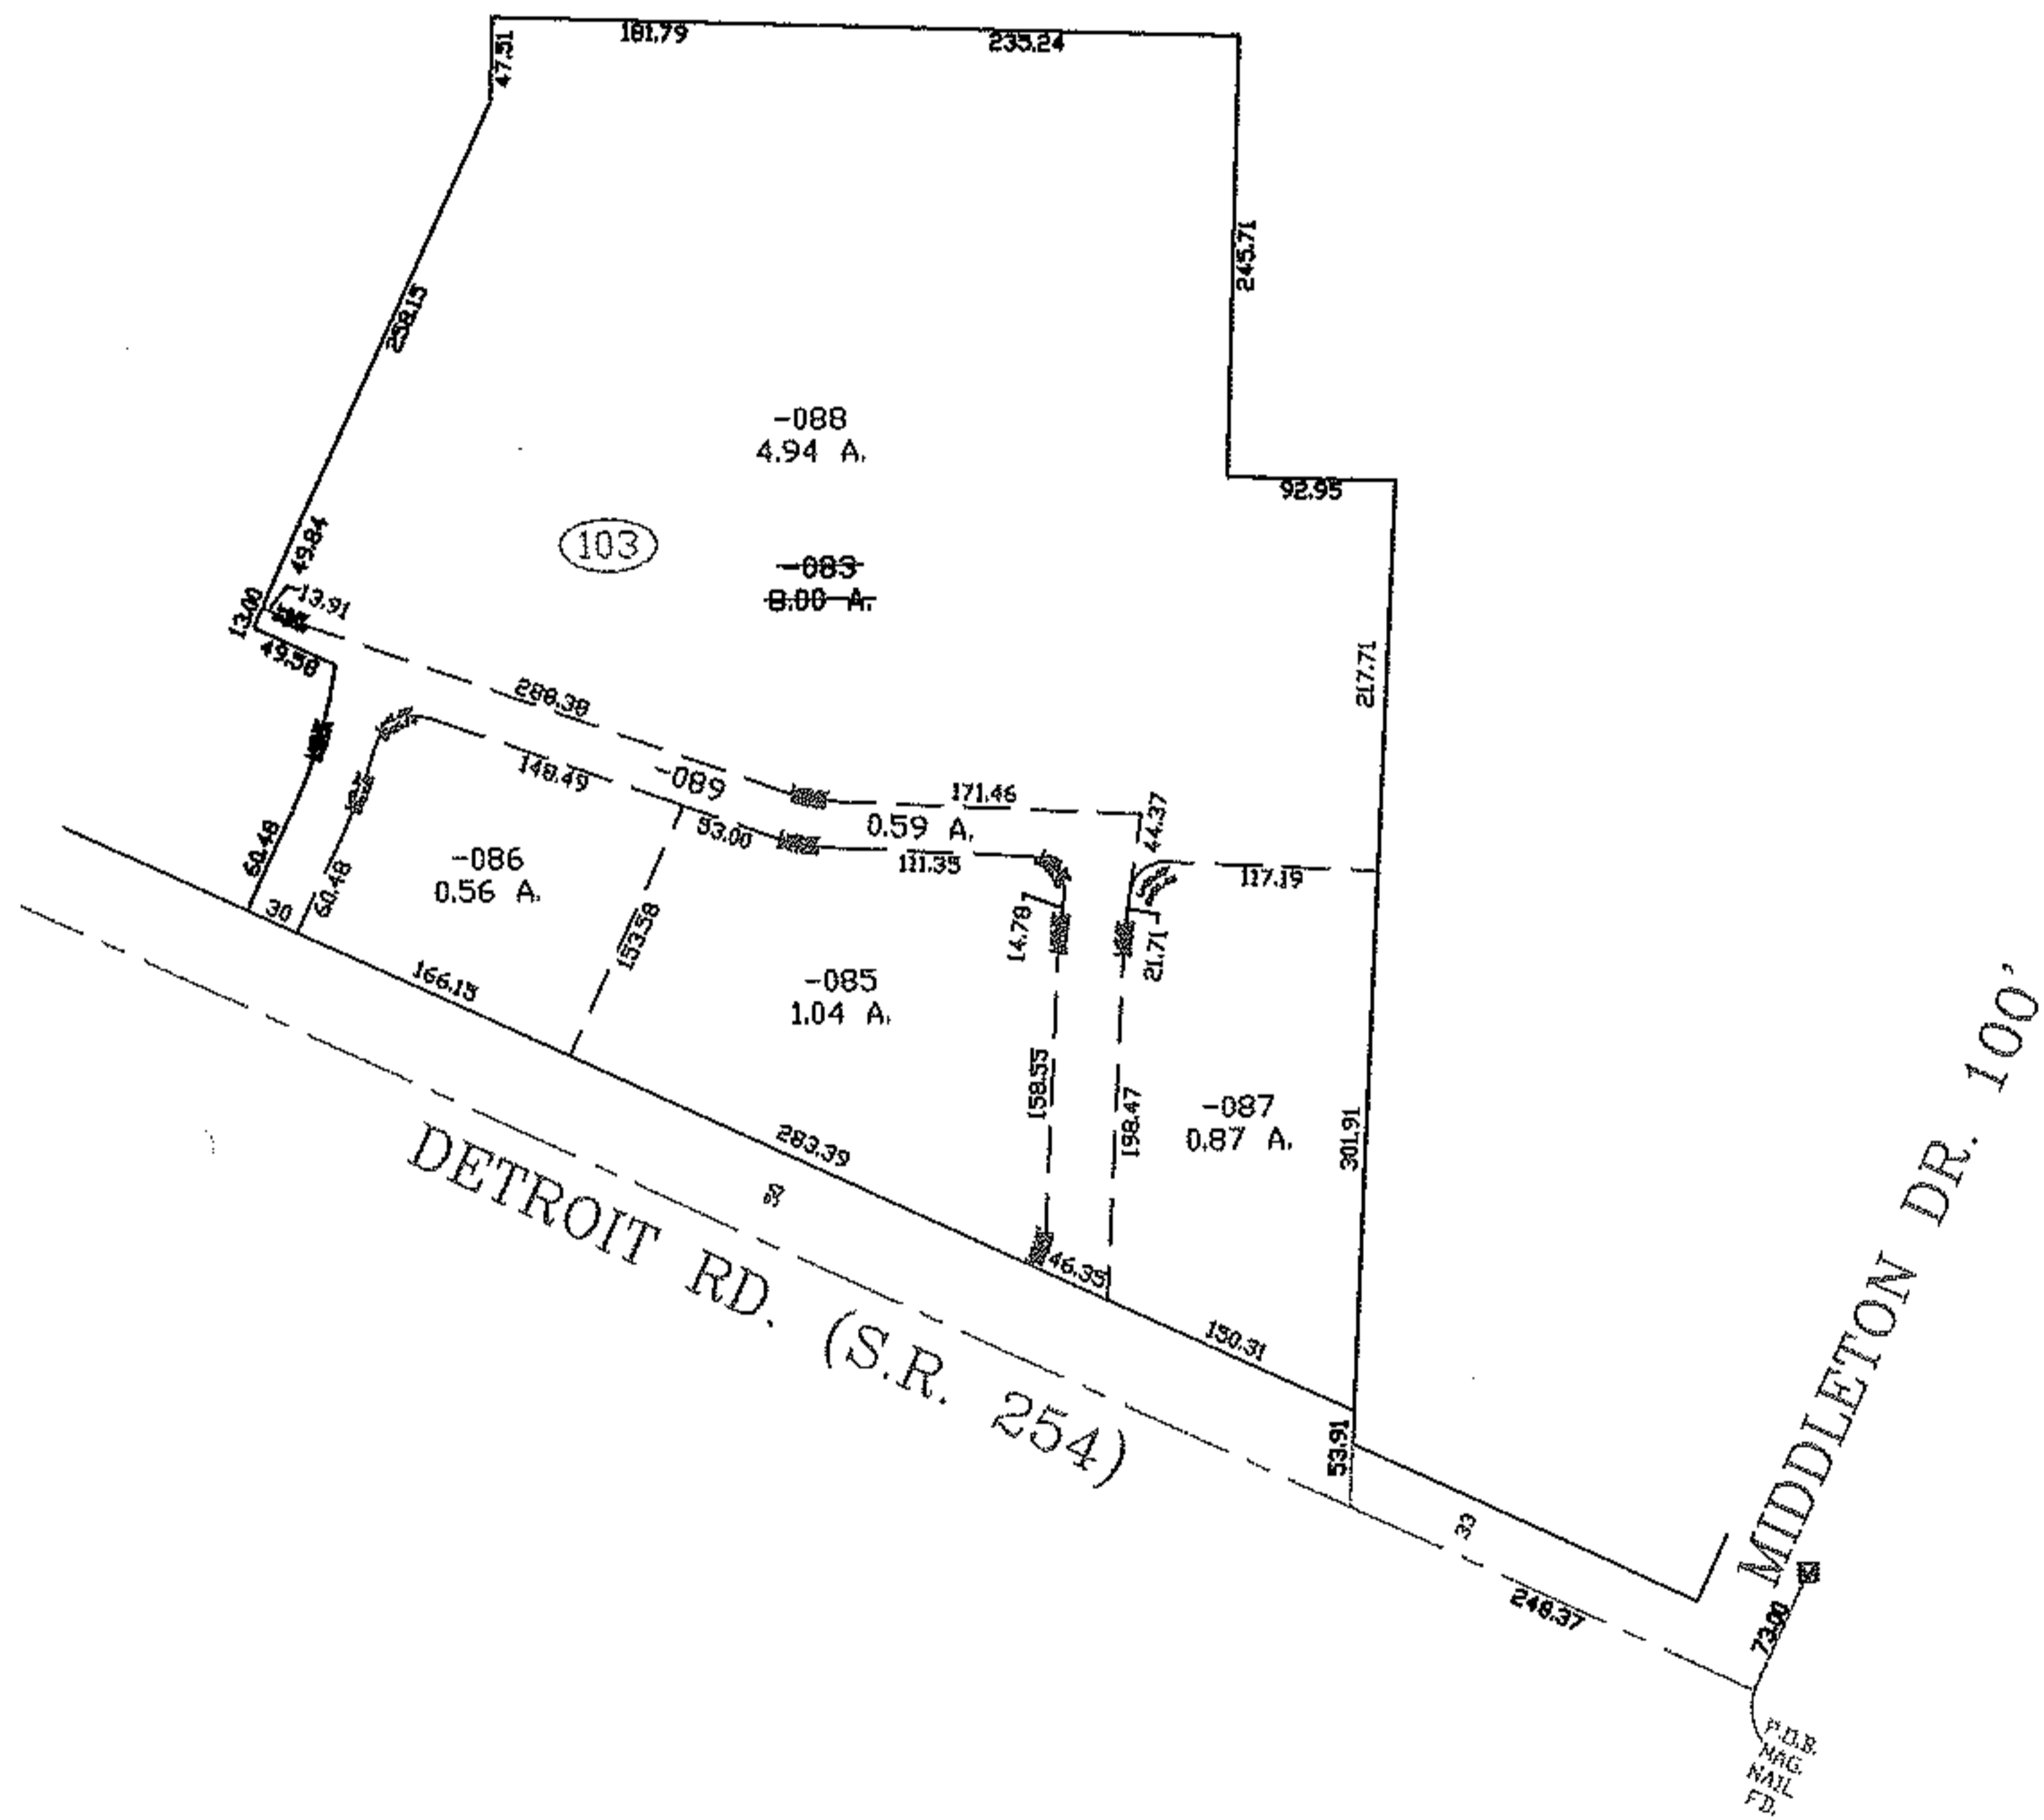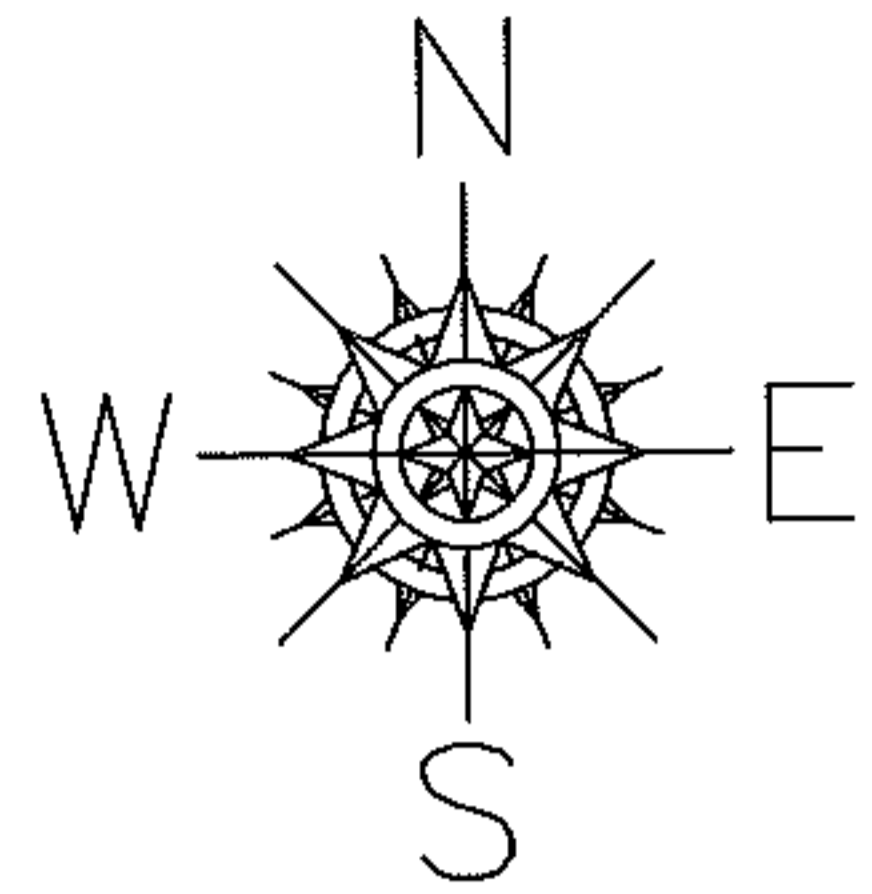

SPLITS/DEEDS PROCESSED
LORAIN COUNTY TAX MAP DEPARTMENT
226 MIDDLE AVE. ELYRIA, OHIO

SURVEYED BY: DAVID L. ELWELL
CLOSURE: 1 : 10,000
MAP PAGE(S): 4-00-015-A
APPROVED BY: TJS DATE: 12/3/08
SCALE: 1" = 200' PRIOR INSTRUMENT: DV XXXX/XXX