
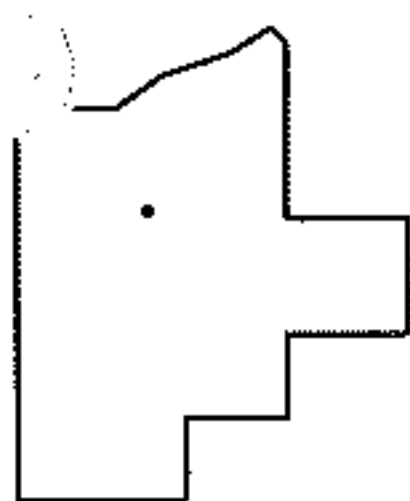
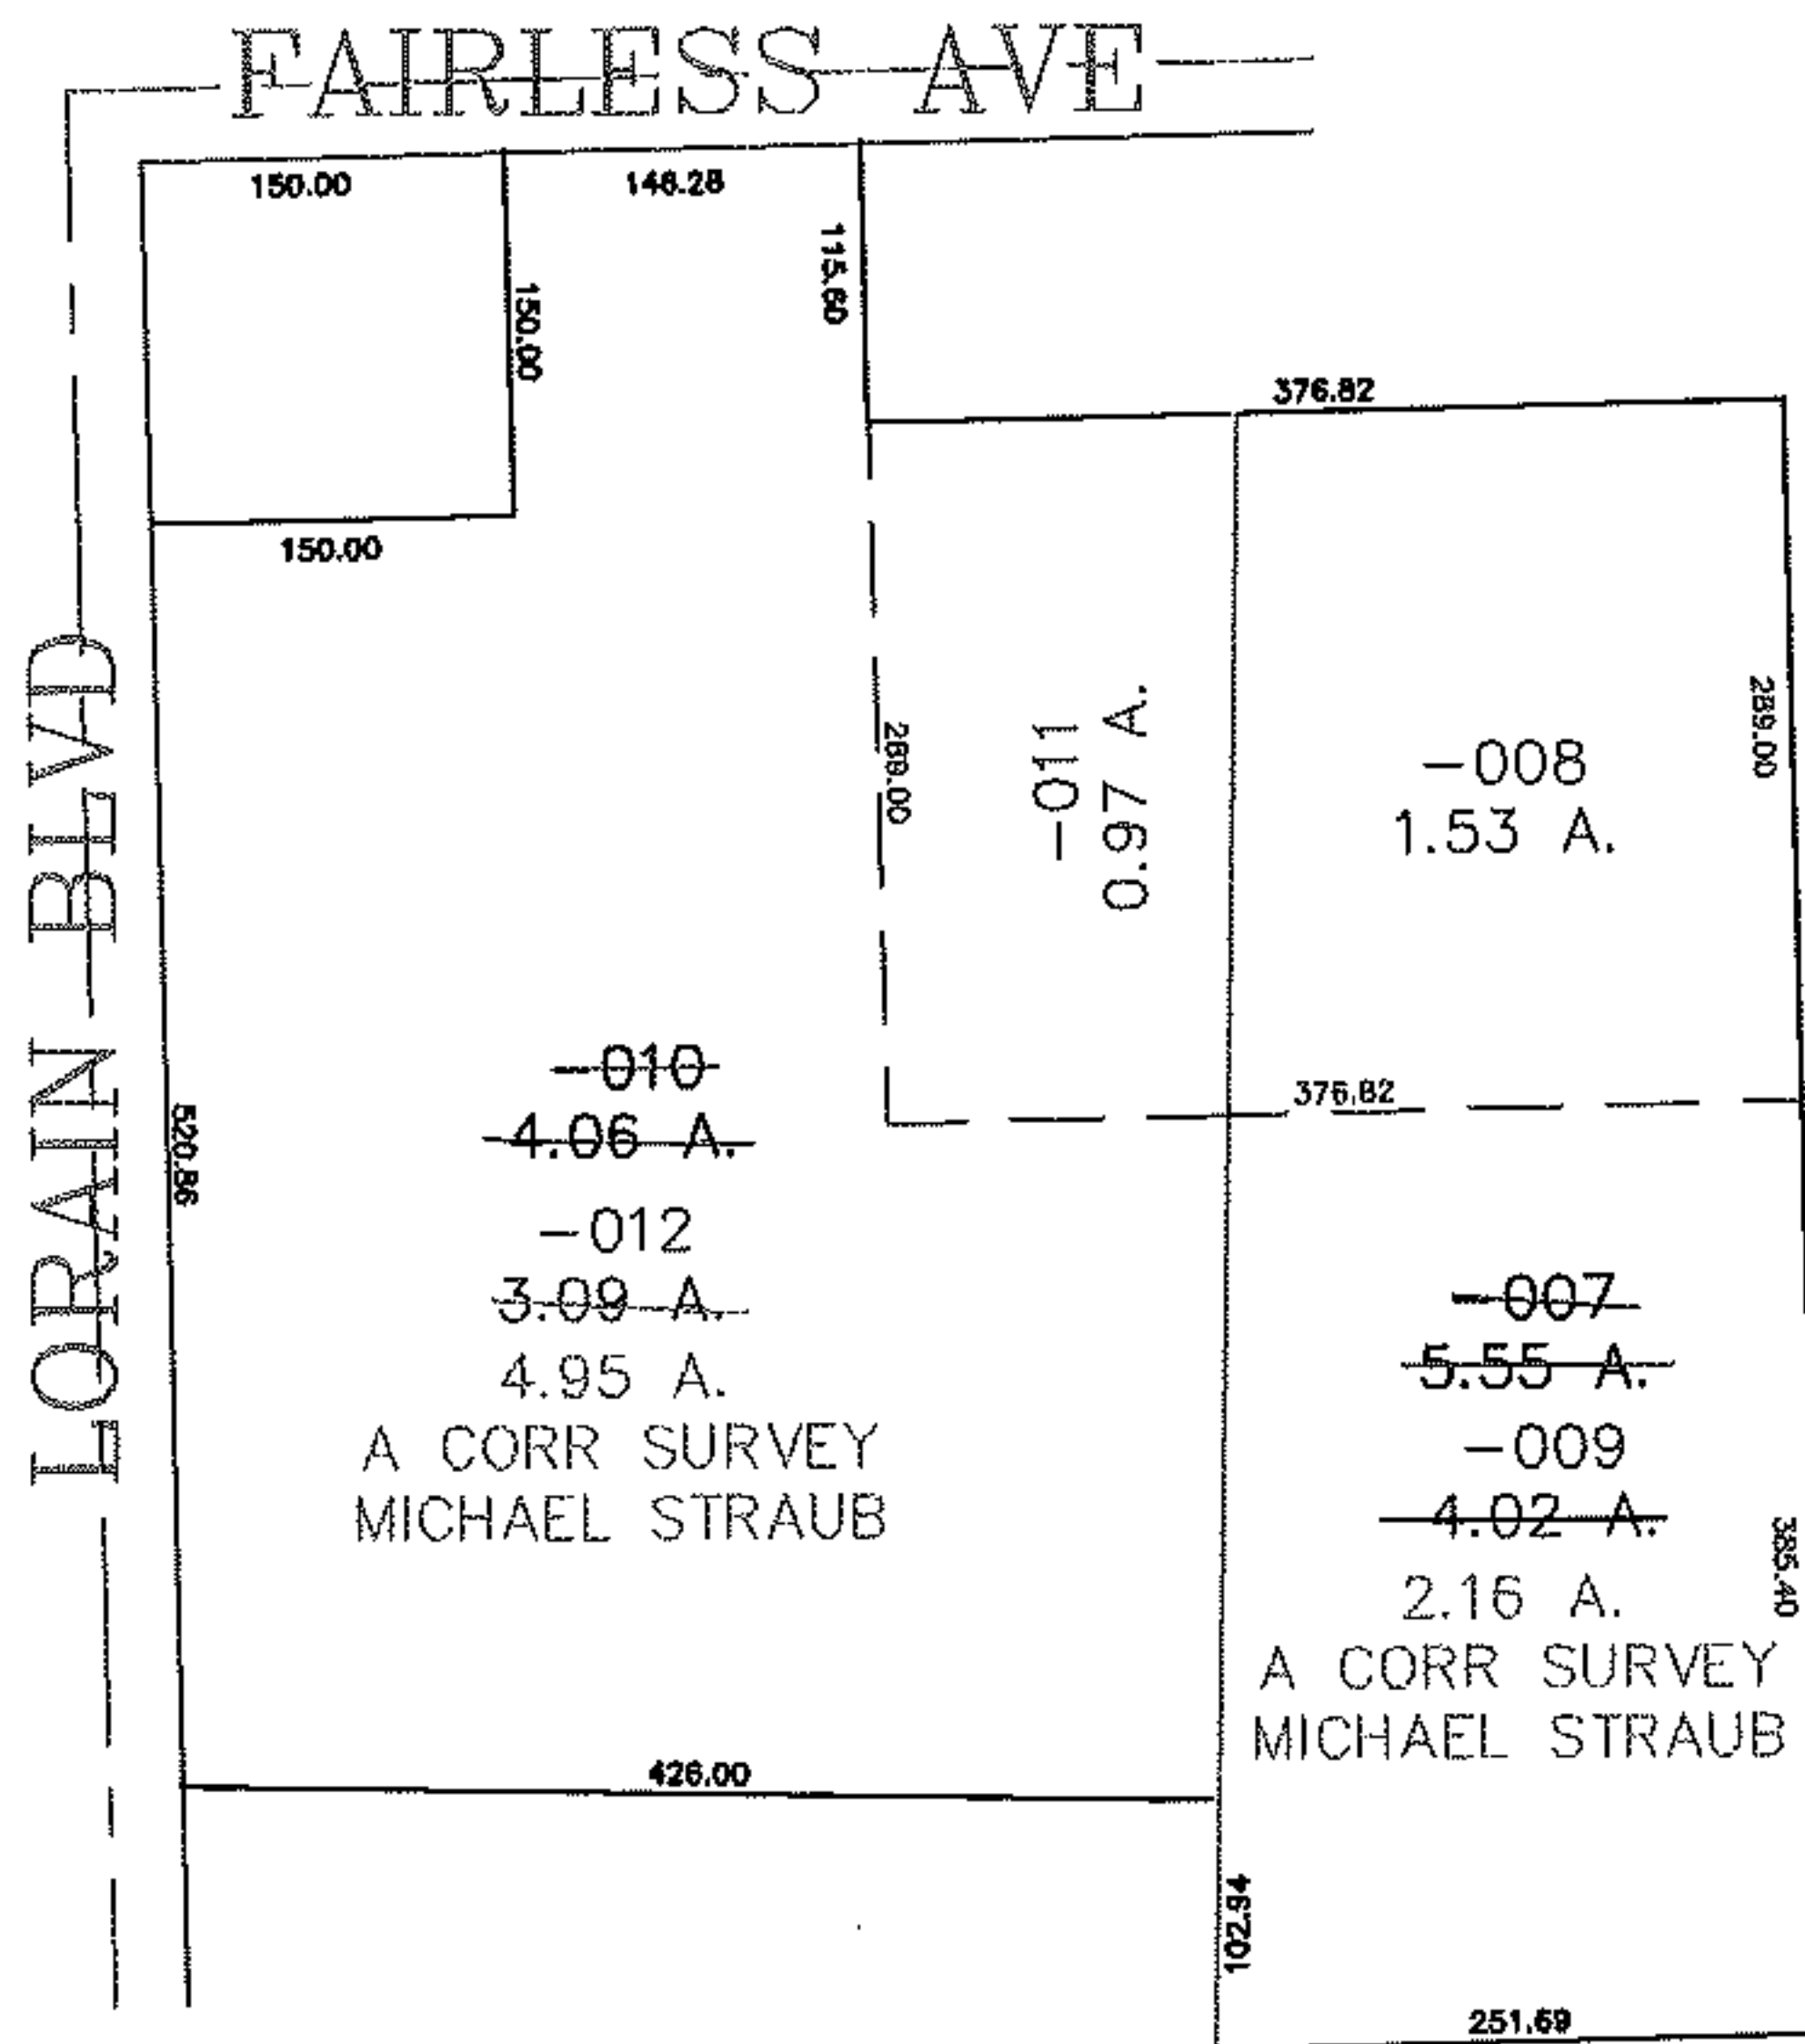


RASTER

PARENT PARCEL: 03-00-104-103-010 03-00-077-101-007
CHILD PARCEL: 03-00-104-103-011, -012 03-00-077-101-008, -009
STARTING POINT: SIDELINE OF FAIRLESS AVE & LORAIN BLVD

08-02646

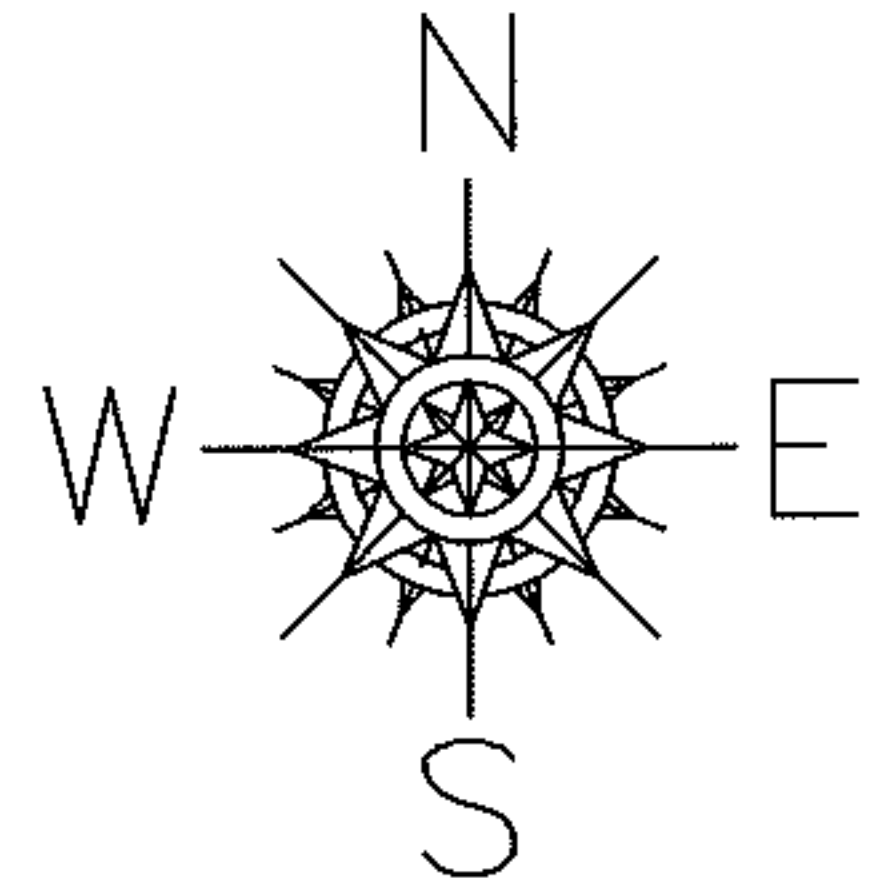

SPLITS/DEEDS PROCESSED
LORAIN COUNTY TAX MAP DEPARTMENT
226 MIDDLE AVE. ELYRIA, OHIO

SURVEYED BY: MICHAEL STRAUB
CLOSURE: 0.00 : 10.000
MAP PAGE(S): 03-00-104-B
APPROVED BY: JAH DATE: 12-4-08
SCALE: 1" = 200 PRIOR INSTRUMENT: 20080263491