




RASTER

PARENT PARCEL: 04-00-022-103-040

CHILD PARCEL: 04-00-022-103-078, -079

STARTING POINT: CENTERLINE OF DETROIT RD & JAYCOX RD

08-02647

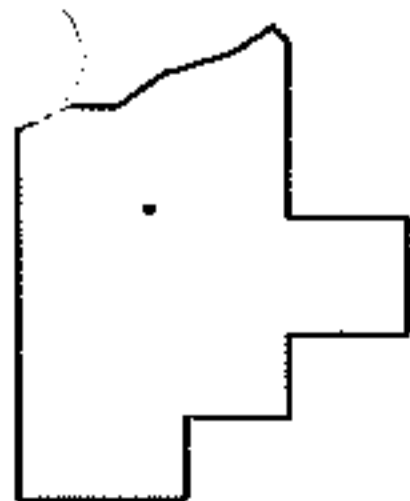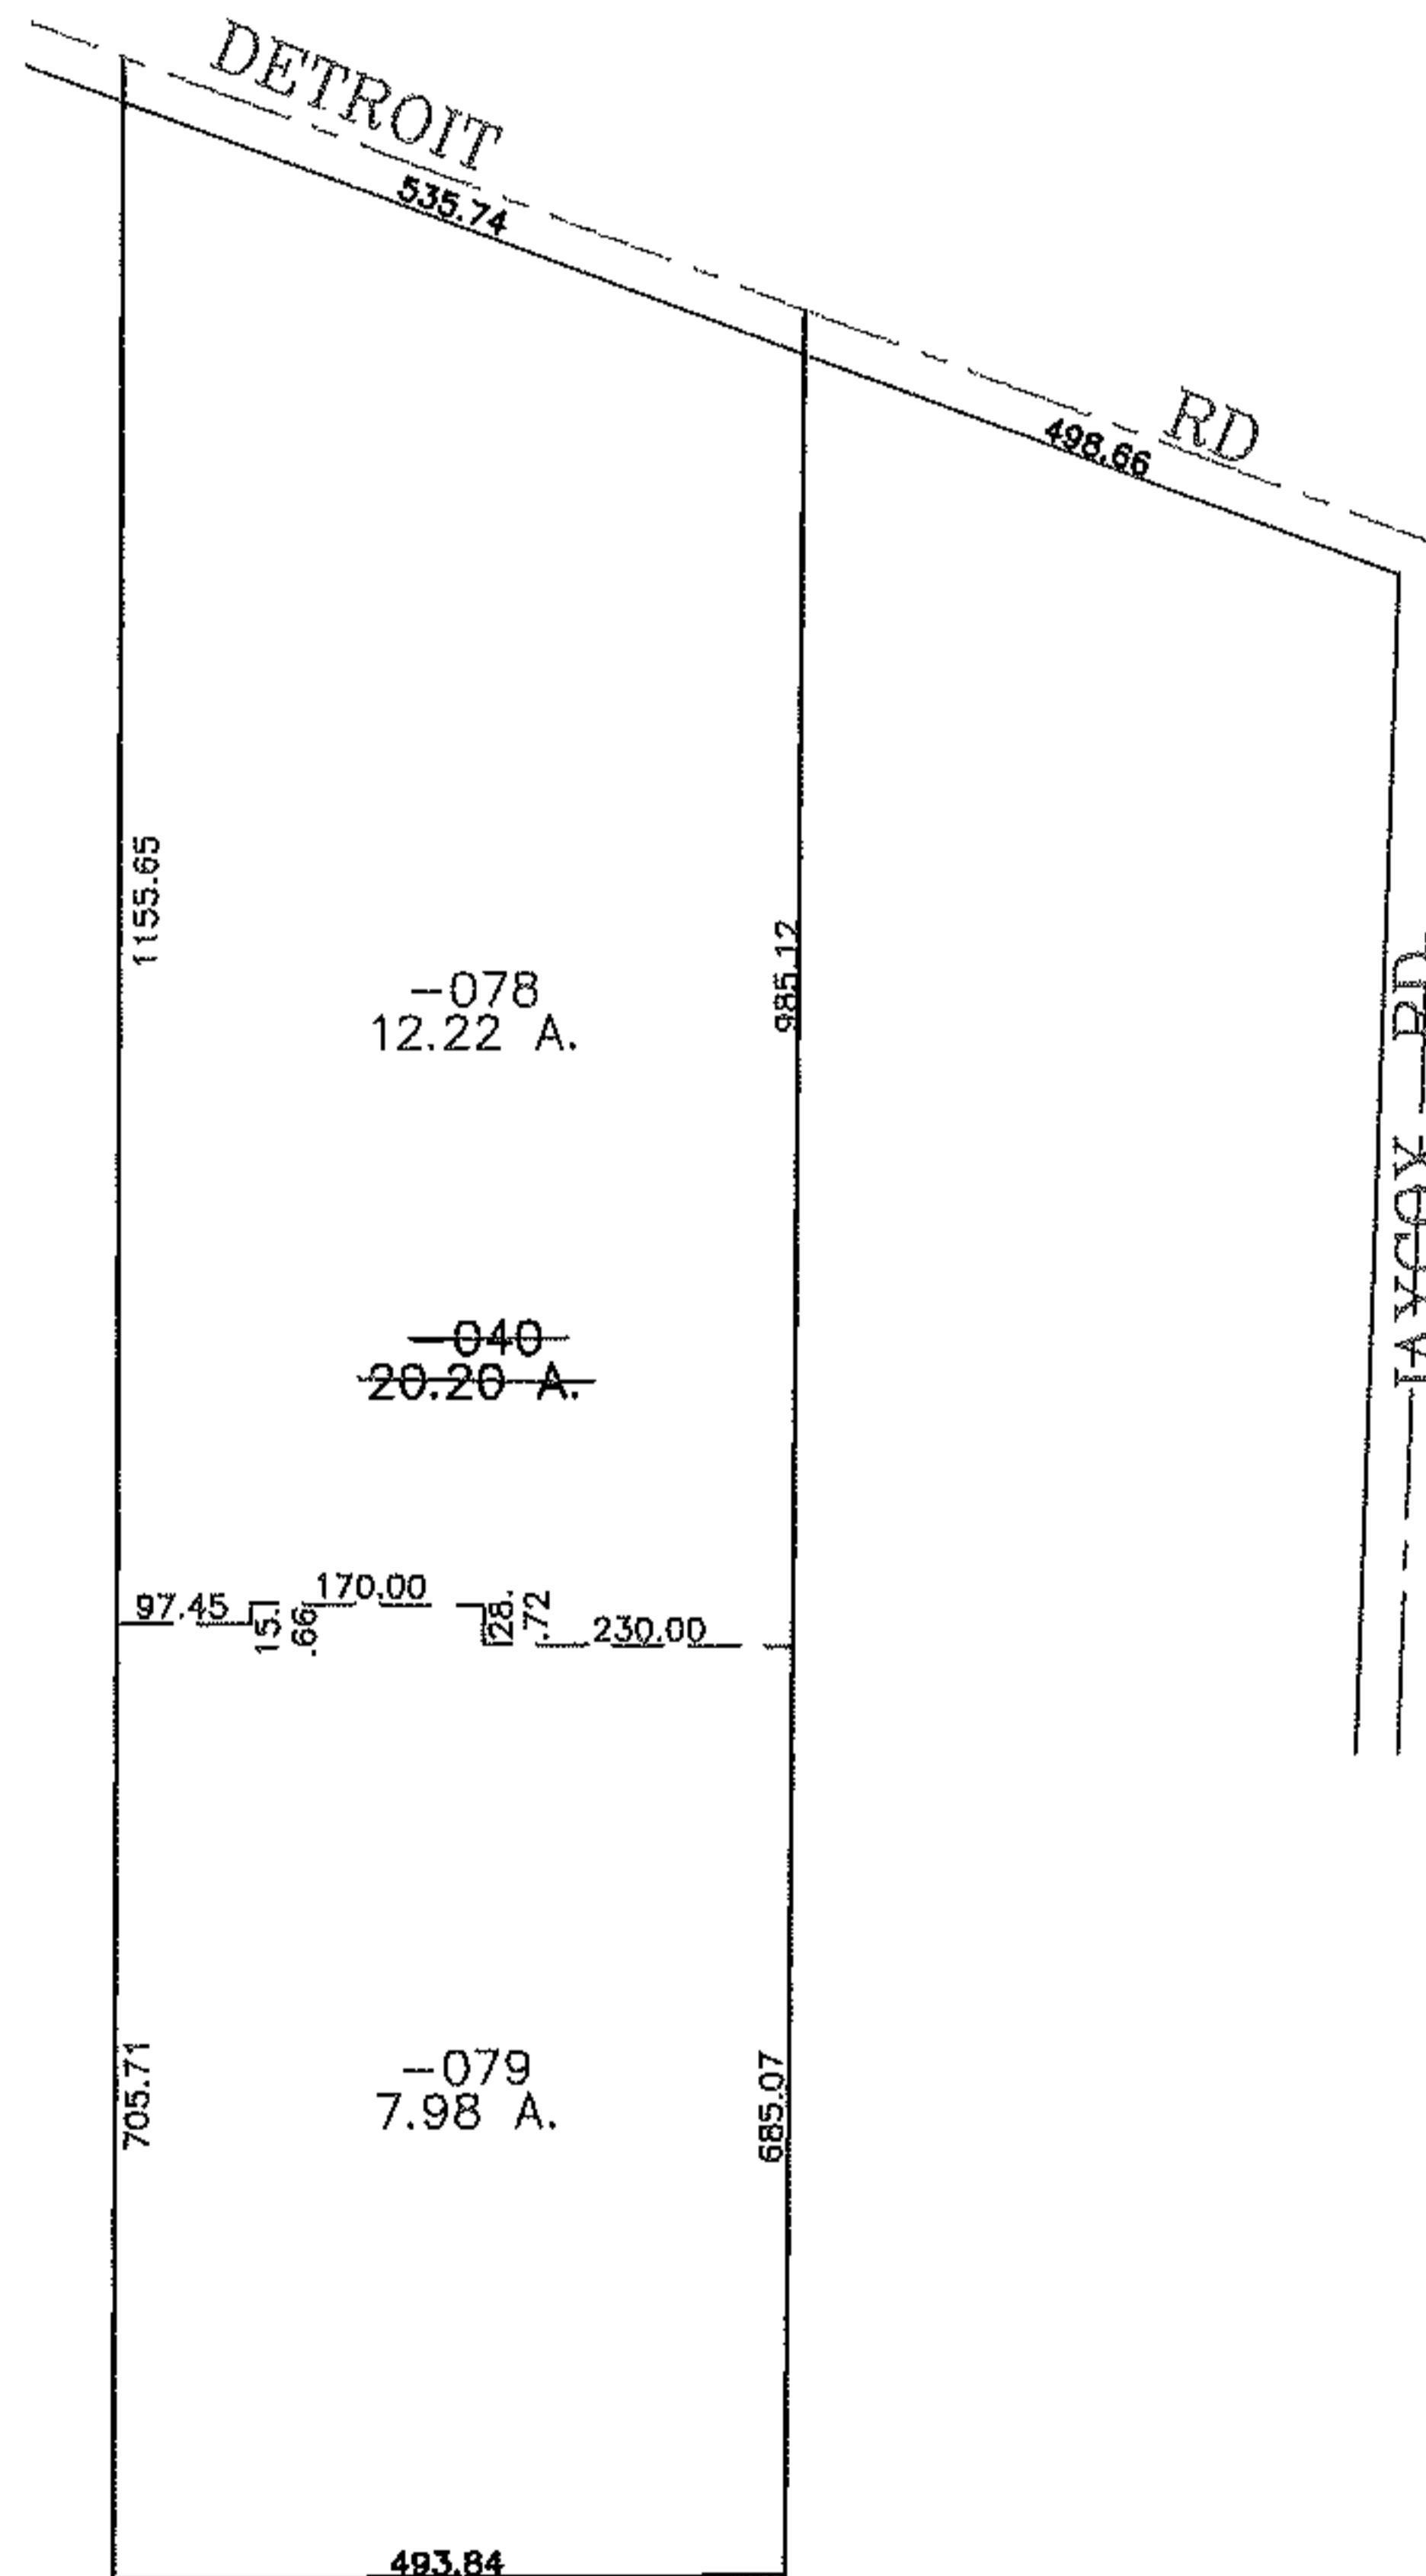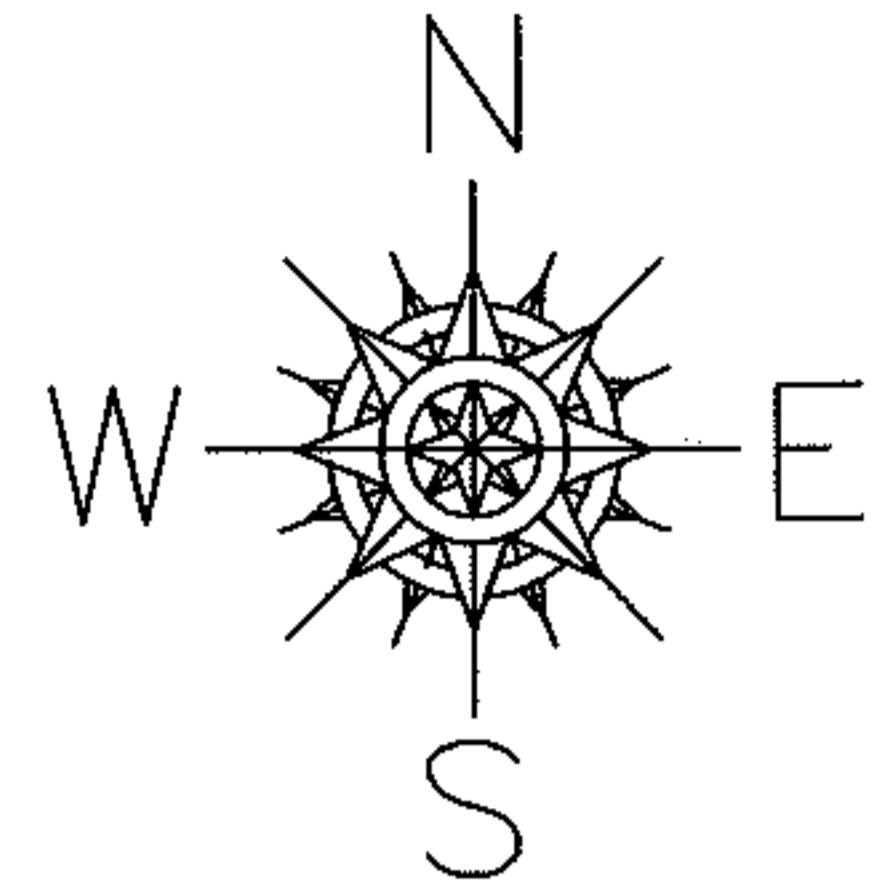

SPLITS/DEEDS PROCESSED
LORAIN COUNTY TAX MAP DEPARTMENT
 226 MIDDLE AVE. ELYRIA, OHIO

SURVEYED BY: MIKE SPELLACY
 CLOSURE: 0.00 : 10.000
 MAP PAGE(S): 04-00-022-F
 APPROVED BY: JAH DATE: 12-8-08
 SCALE: 1" = 300 PRIOR INSTRUMENT: OR 91/143