




RASTER

PARENT PARCEL: 01-00-044-000-022, -002

CHILD PARCEL: 01-00-044-051, -052, -053

STARTING POINT: CENTERLINE OF NORTH RIDGE RD & SUNNYSIDE RD

08-02648

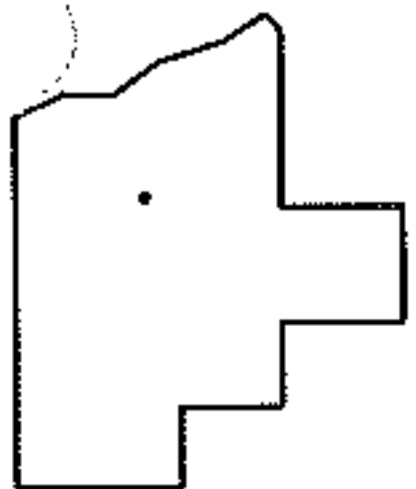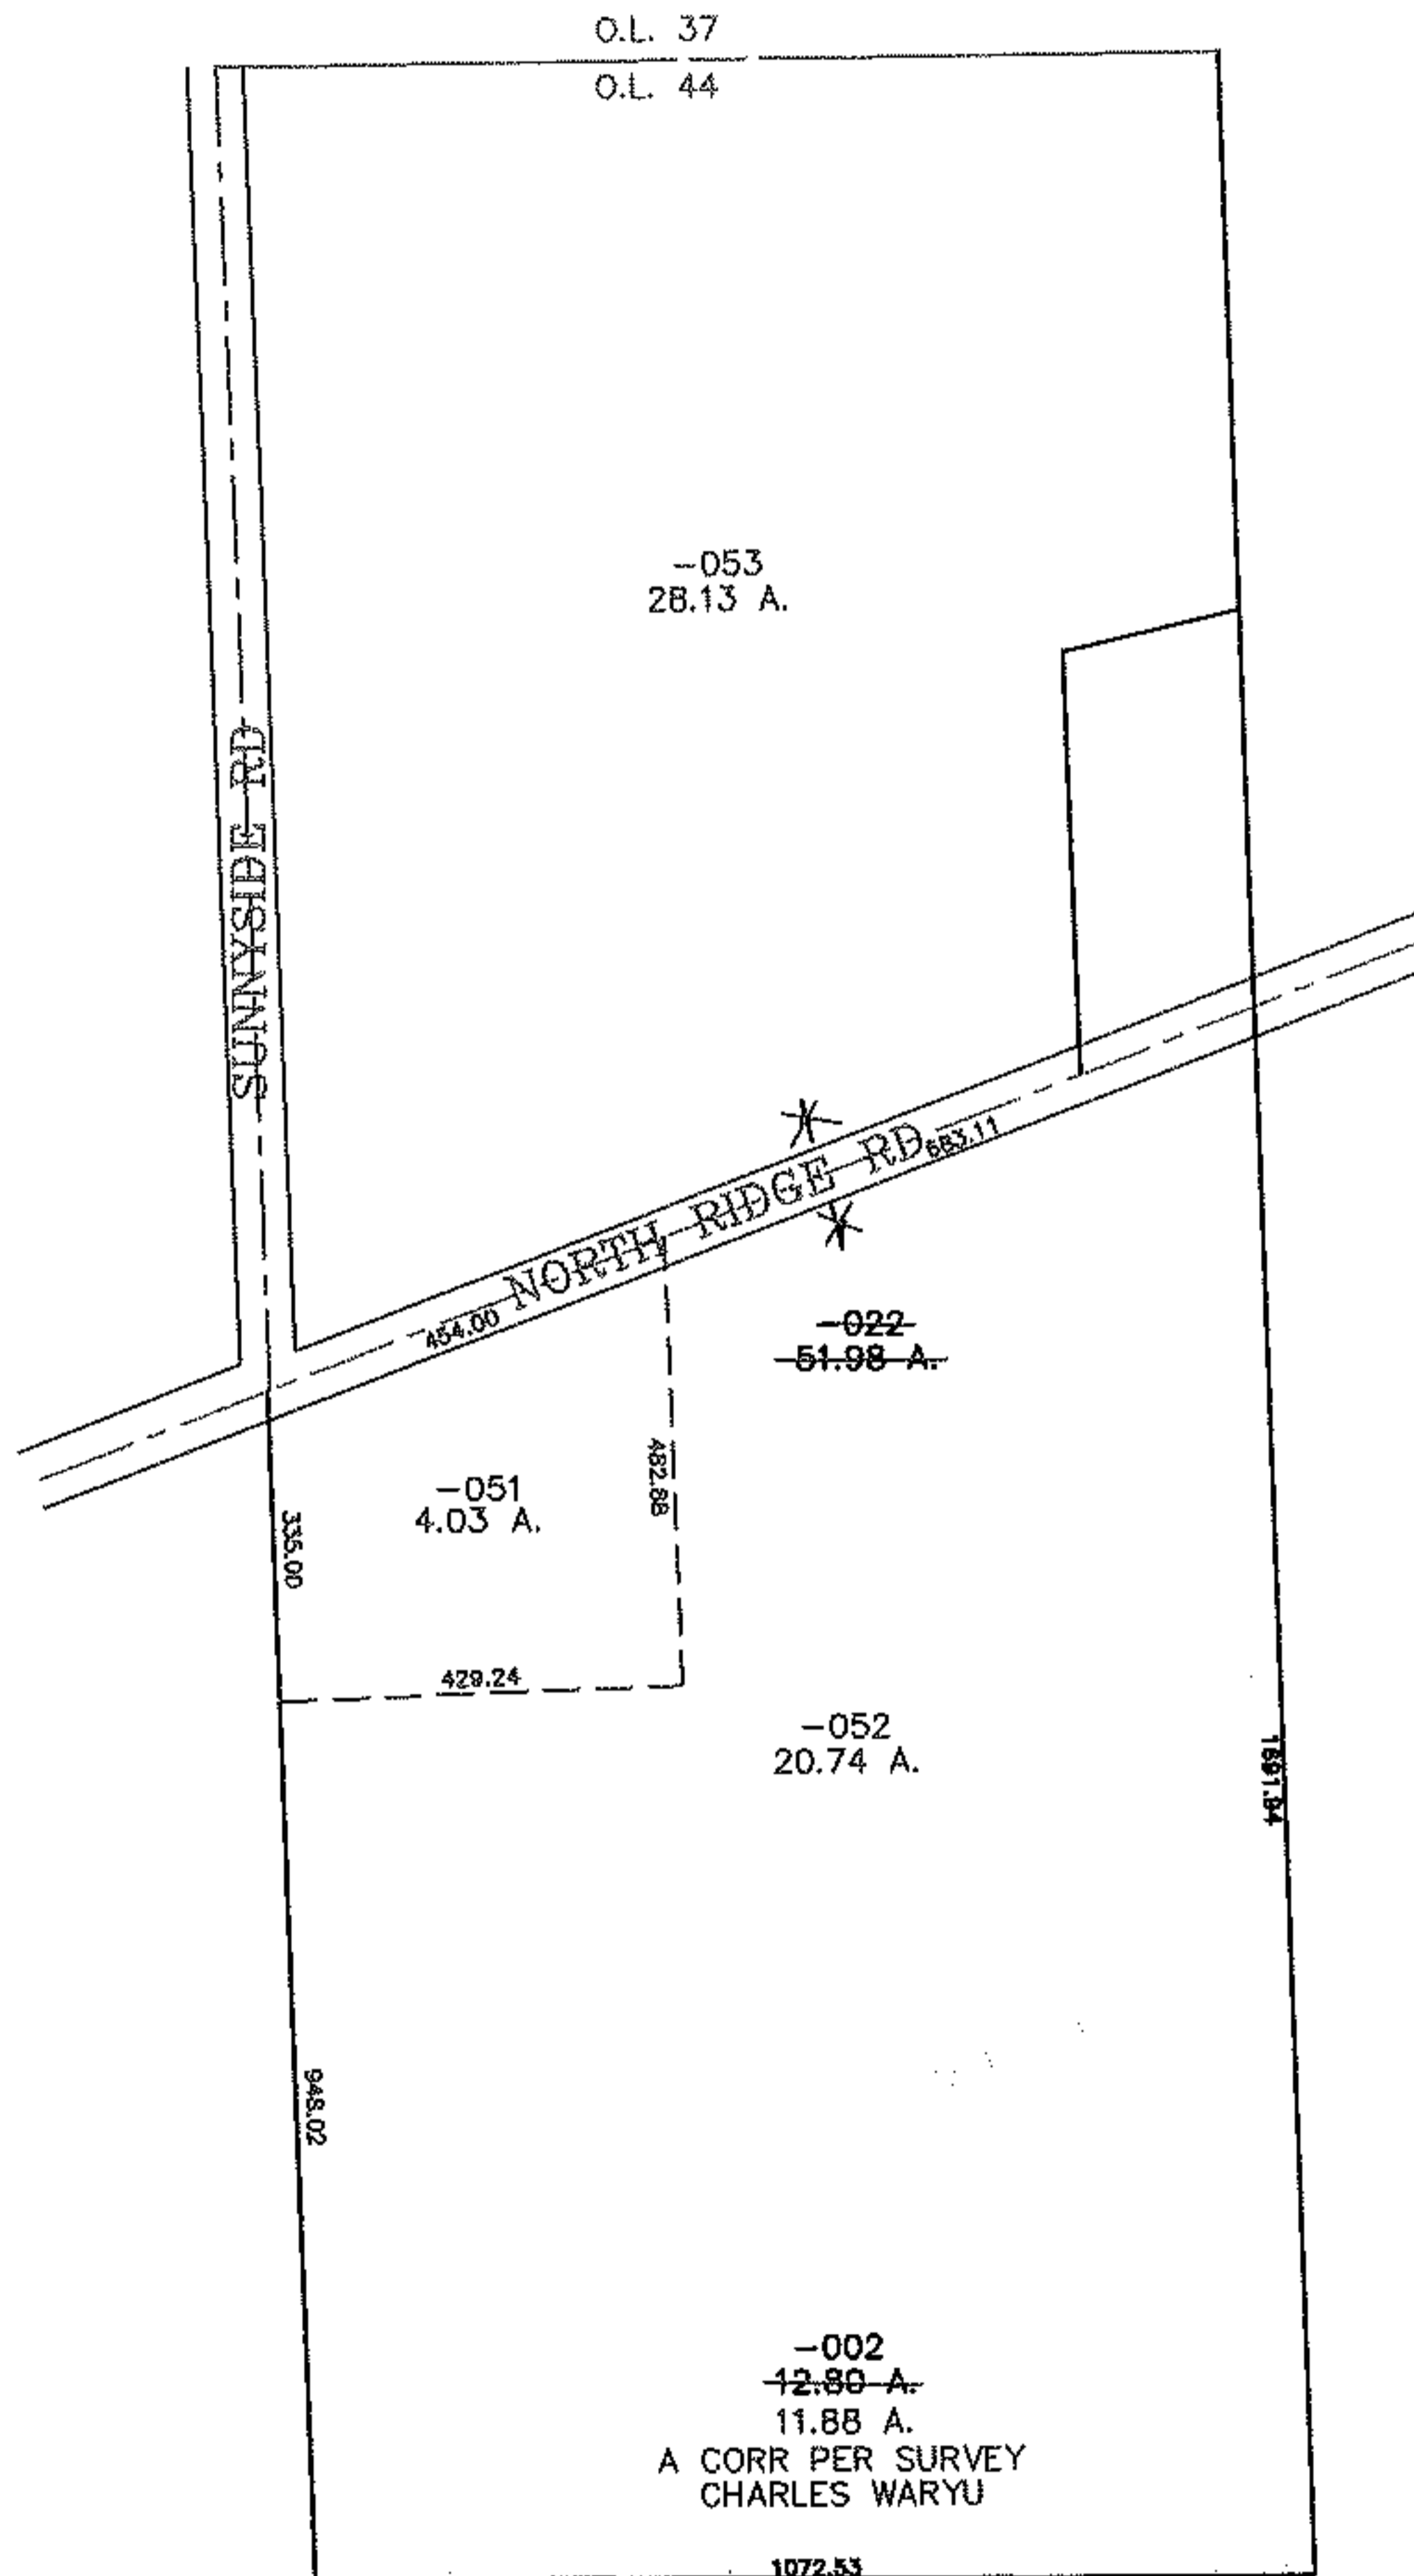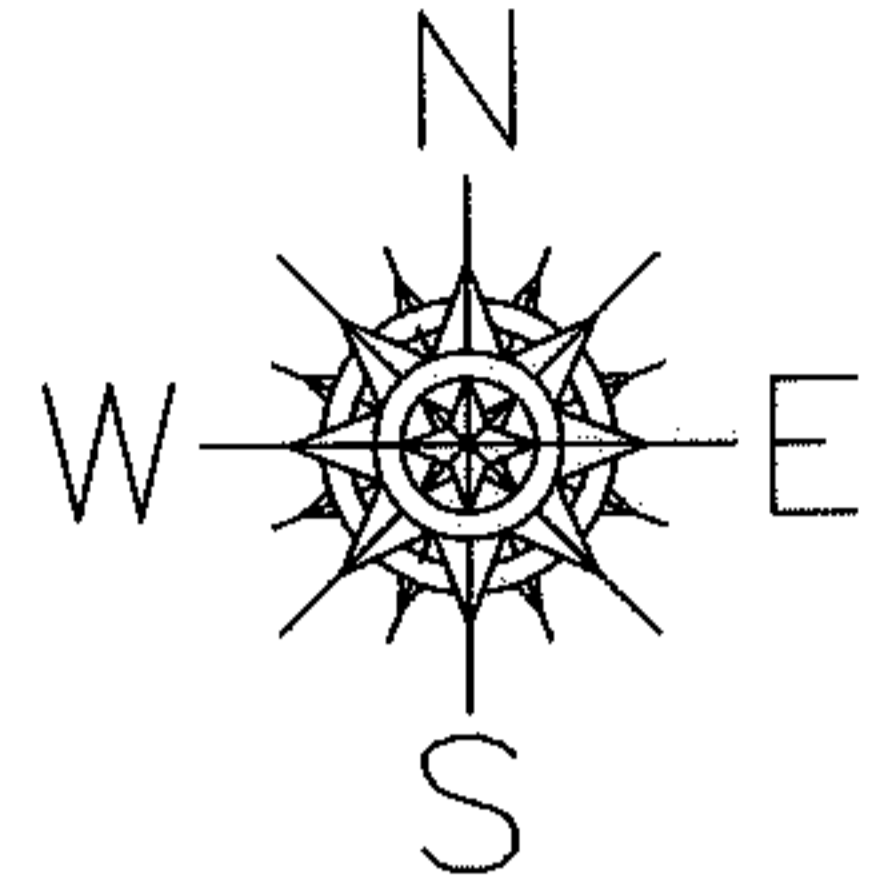

SPLITS/DEEDS PROCESSED

LORAIN COUNTY TAX MAP DEPARTMENT
226 MIDDLE AVE. ELYRIA, OHIO

SURVEYED BY: CHARLES WARYU

CLOSURE: 0.00 : 10,000

MAP PAGE(S): 01-00-044-A

APPROVED BY: JAH DATE: 12-8-08

SCALE: 1" = 400 PRIOR INST.: 20080252267