
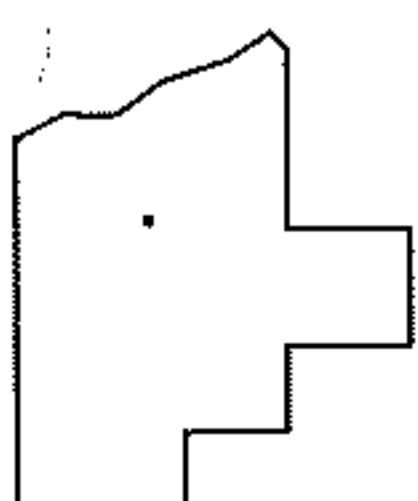
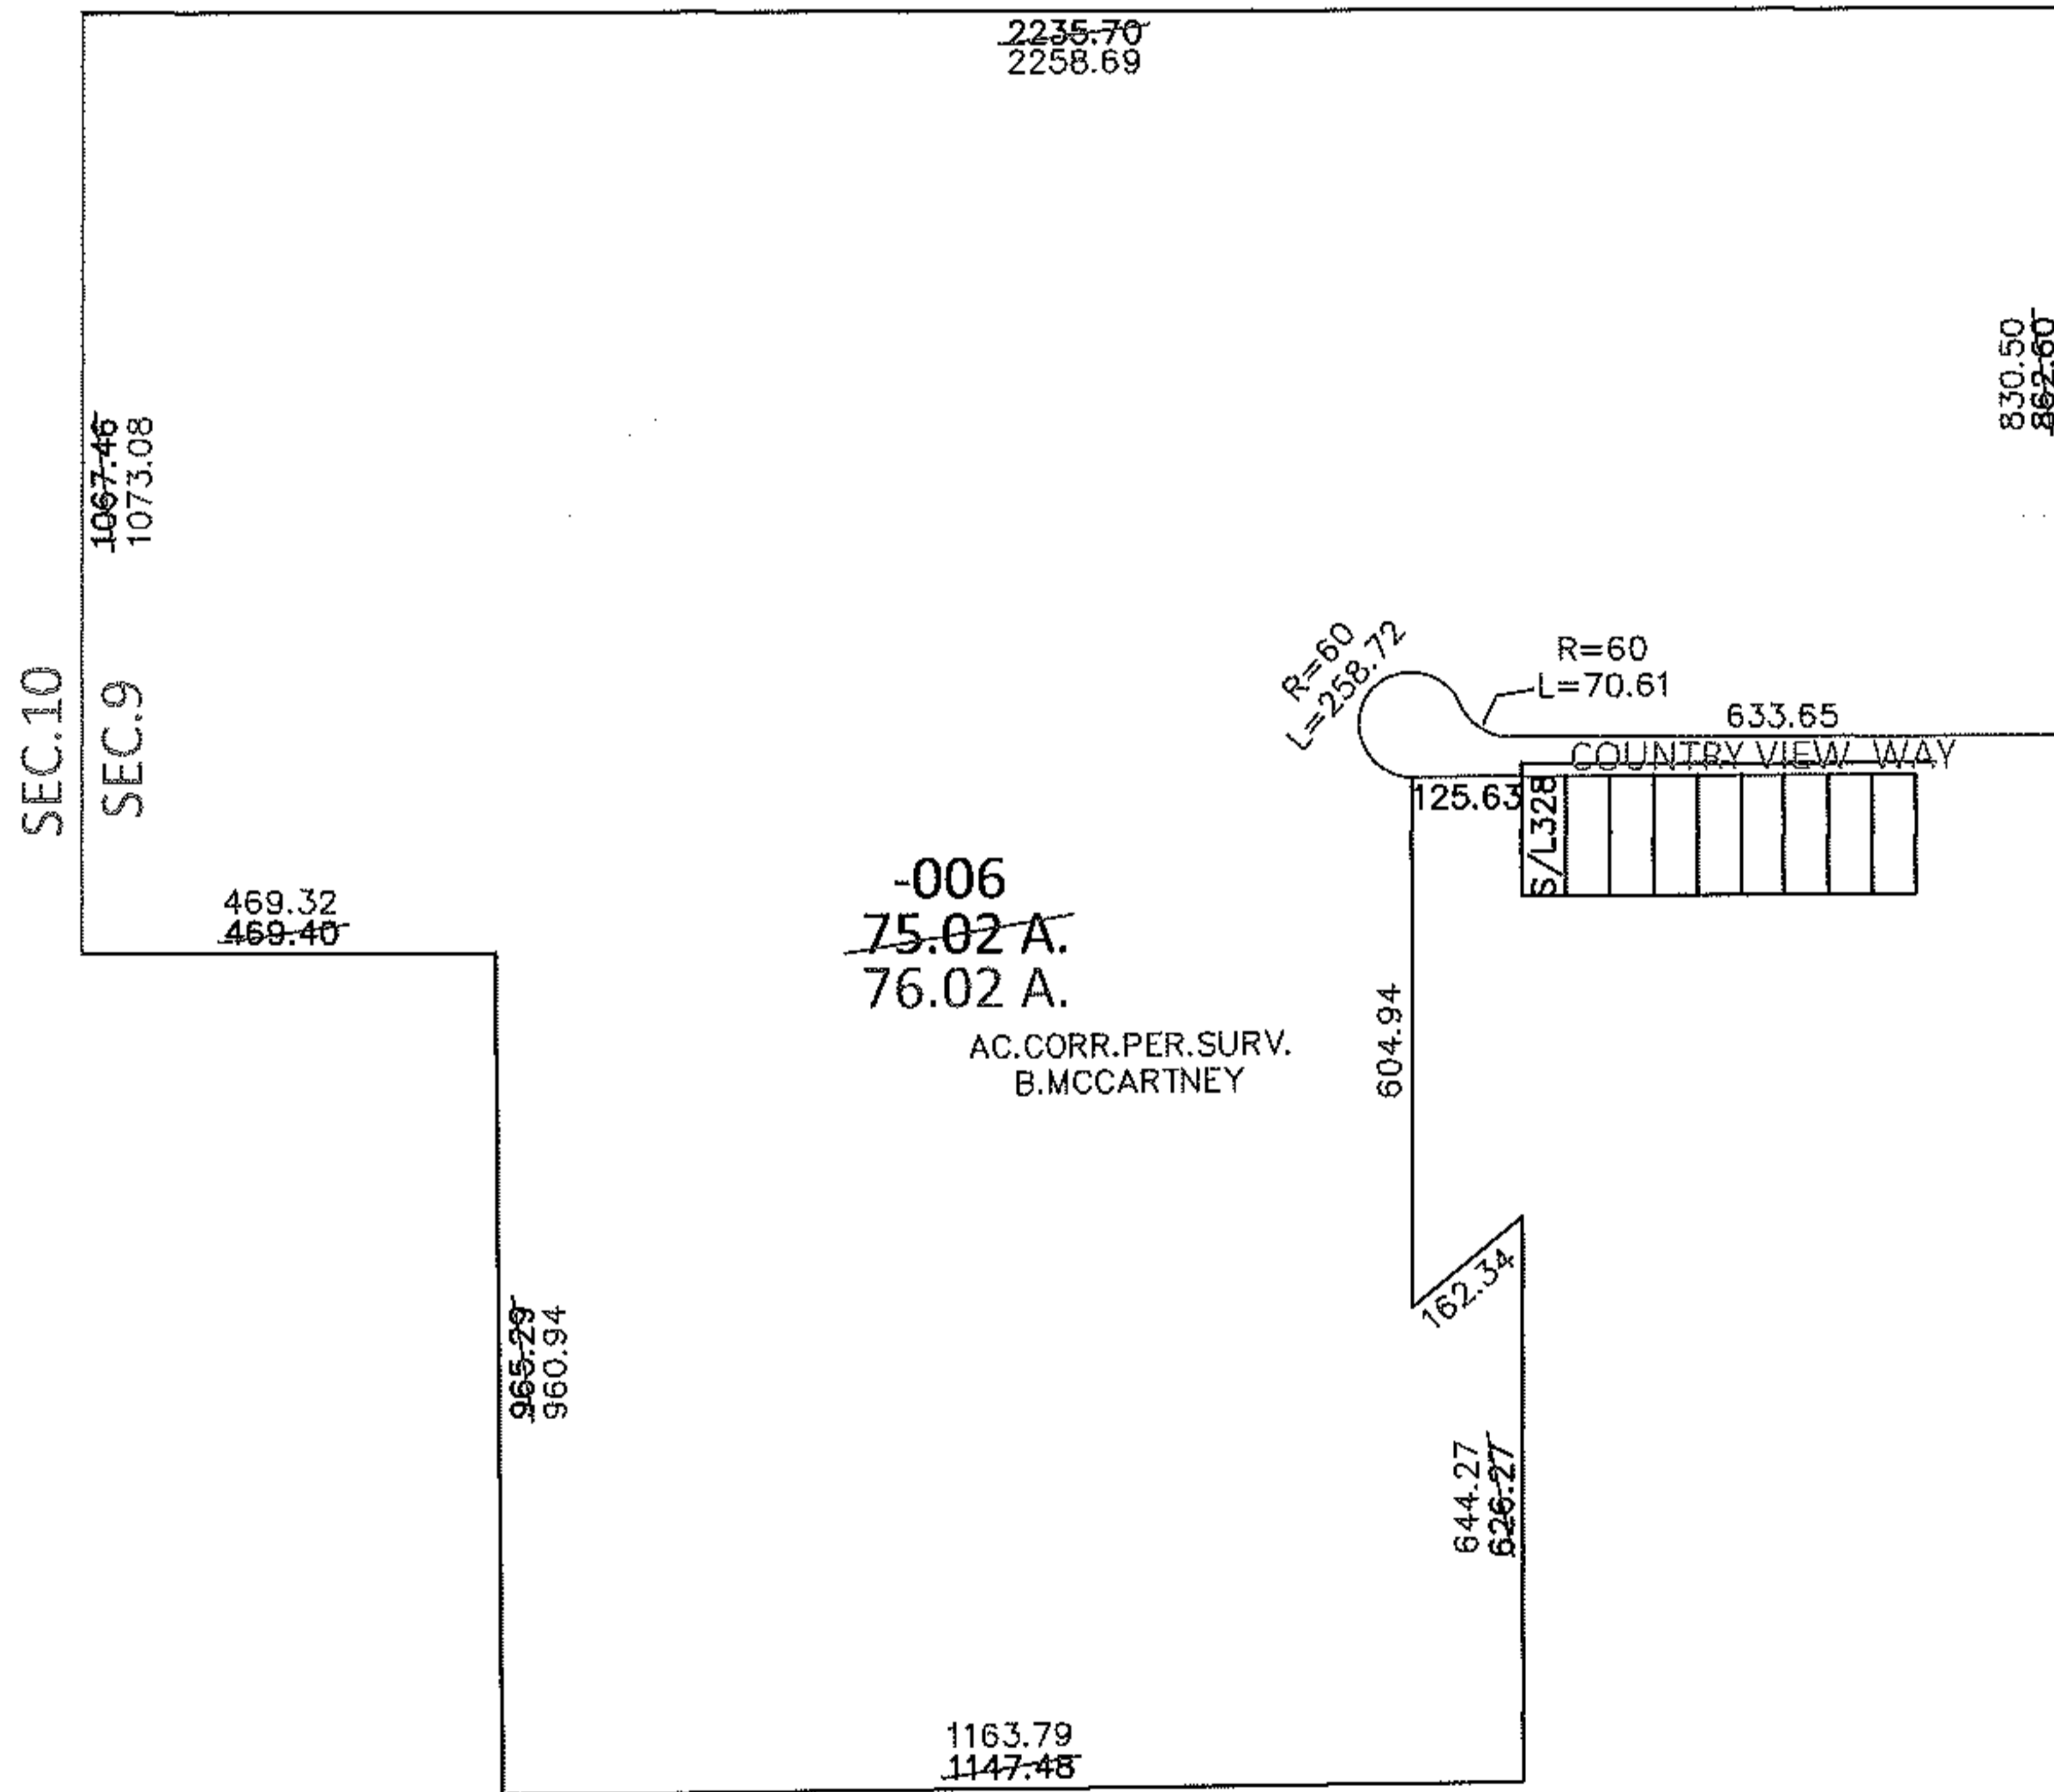


PARENT PARCEL: 10-00-009-118-006

CHILD PARCEL: \_\_\_\_\_

13-02649-A

STARTING POINT: NORTHWEST CORNER OF S/L 328 IN CARLISLE ESTATES NO.1(VOL.12 PG.34)

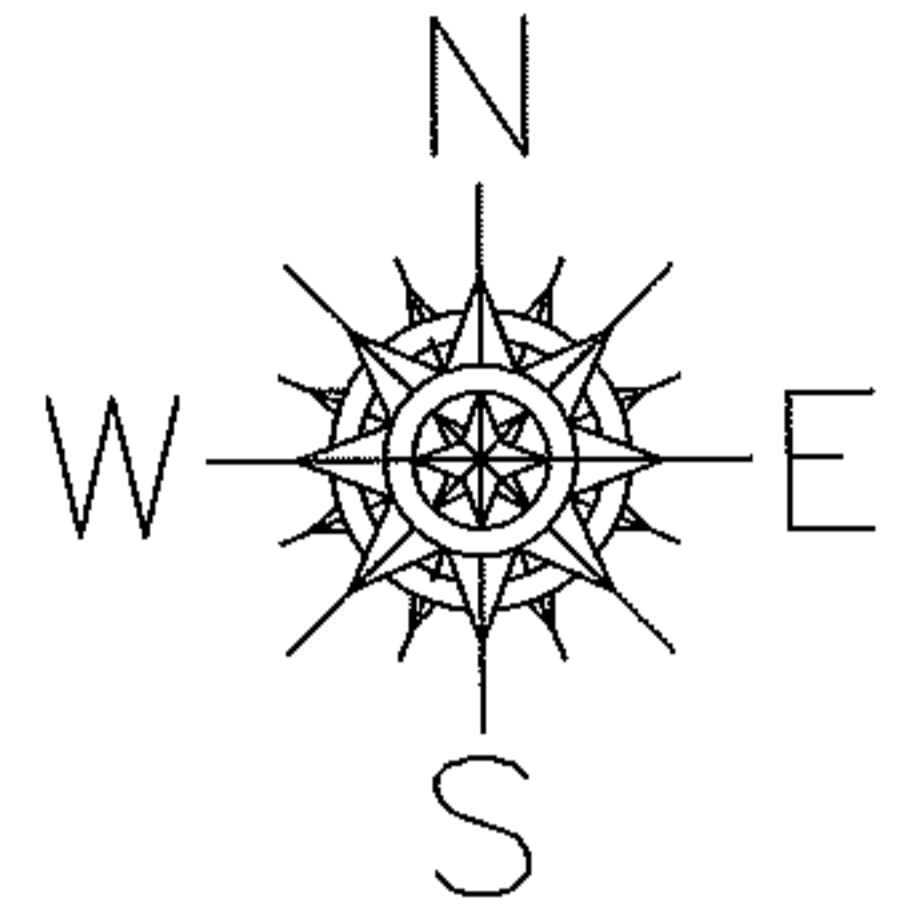

SPLITS/DEEDS PROCESSED

LORAIN COUNTY TAX MAP DEPARTMENT  
226 MIDDLE AVE. ELYRIA, OHIO

SURVEYED BY: BRIAN P. MCCARTNEY  
 CLOSURE: .01:10,000  
 MAP PAGE(S): 10-00-009-E  
 APPROVED BY: RRM DATE: 1-11-13  
 SCALE: 1"= 400 PRIOR INST.: 20110394165