


PARENT PARCEL: 06-26-026-000-013

CHILD PARCEL: XX-XX-XXX-XXX-XXX

STARTING POINT: XXXXXX

13-02651-C

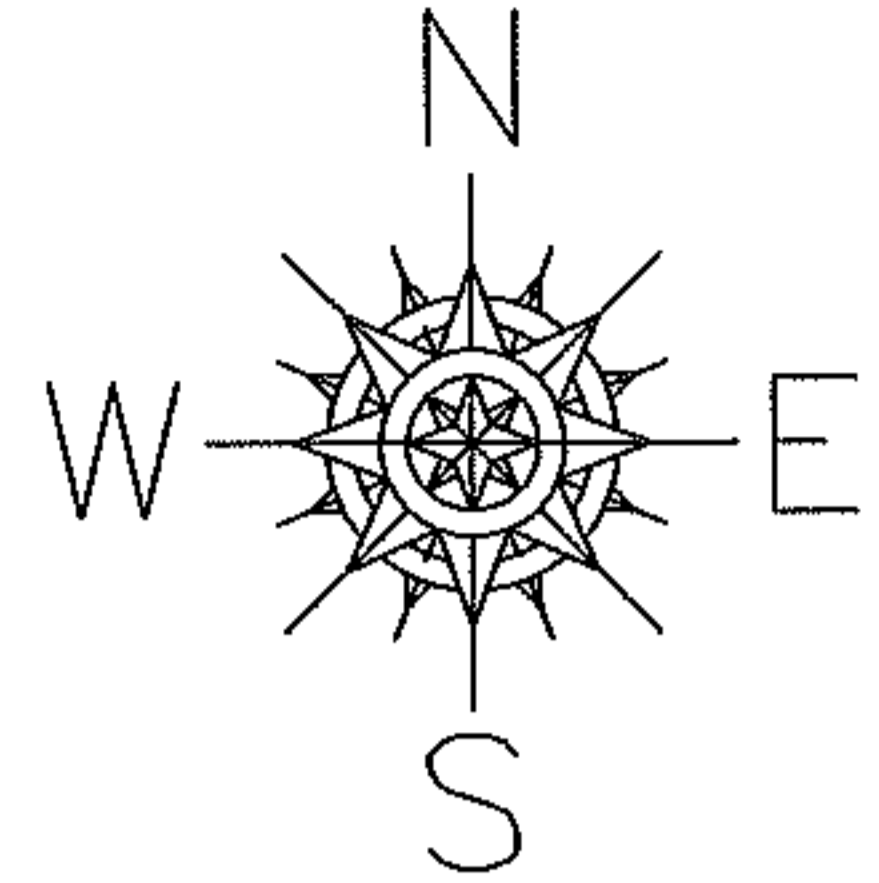

DEPTH CORRECTION


06-26-026-000-013

~~66 X 112~~

66 X 112.50

CORR. PER DEED  
DV 408/600

VIC JANOWICZ 66'

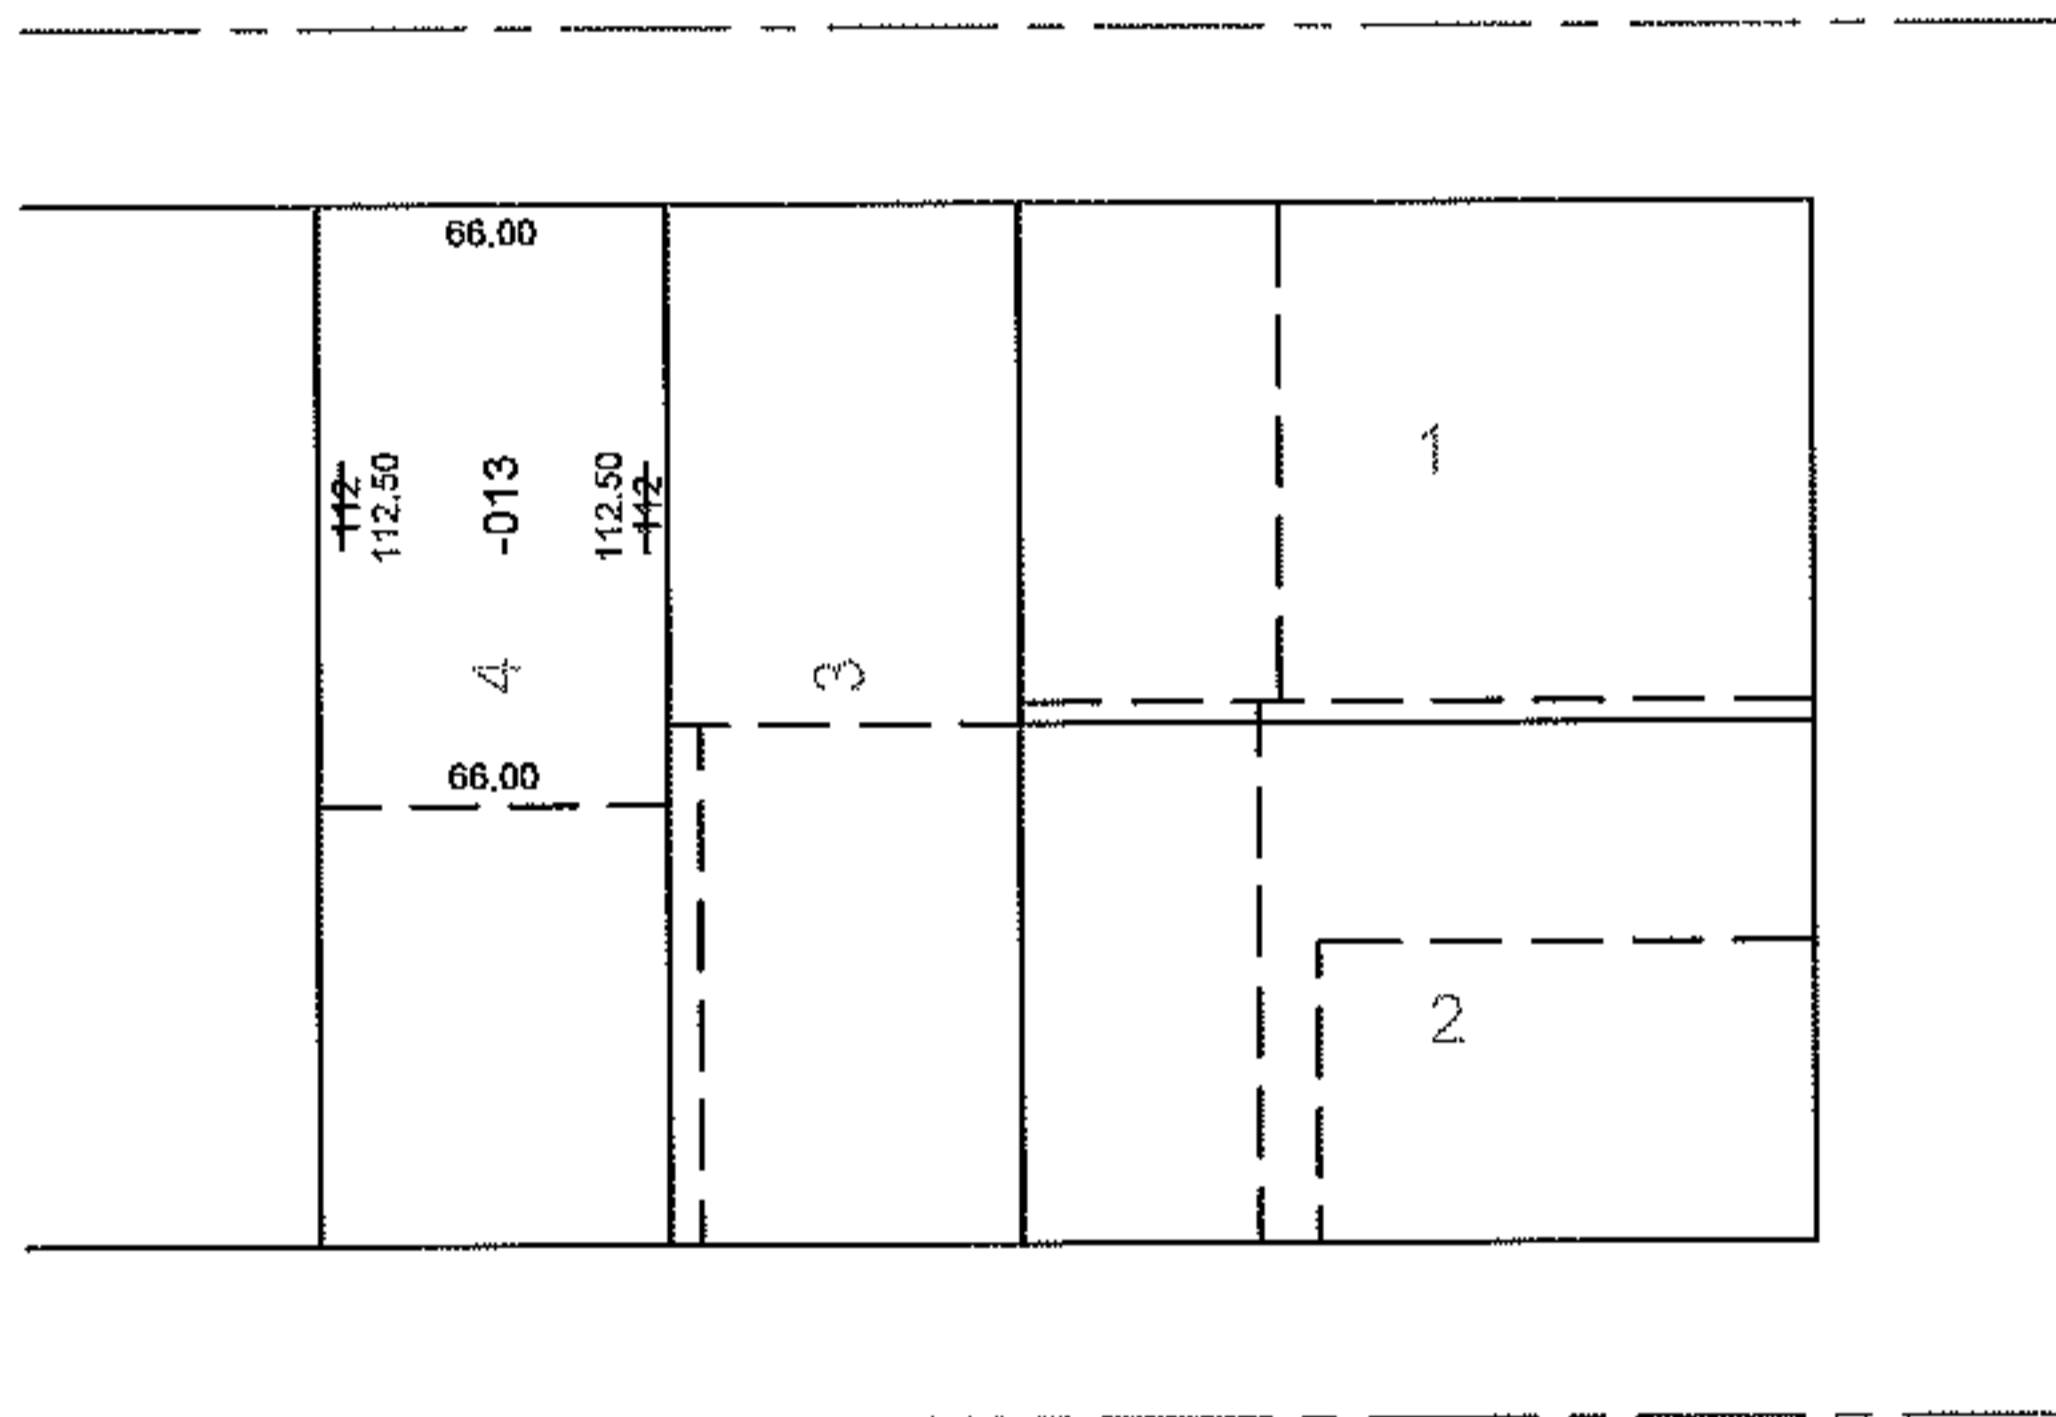

MIDDLE AVE. 99'

8TH ST. 66'

SPLITS/DEEDS PROCESSED

LORAIN COUNTY TAX MAP DEPARTMENT  
226 MIDDLE AVE. ELYRIA, OHIO

SURVEYED BY: NONE

CLOSURE: NONE

MAP PAGE(S): 6-137

APPROVED BY: TJS DATE: 1/16/13

SCALE: 1"=100 PRIOR INST.: DV 408/600