


PARENT PARCEL: 02-02-015-109-062

CHILD PARCEL: 02-02-015-109-069, -070



13-02652-U

STARTING POINT: INTERSECTION OF C/L OF OBERLIN AVE. AND SOUTH LINE OF WILLOW CREEK SUB NO.2

WILLOW CREEK SUB. NO.2
VOL.15 PG.5

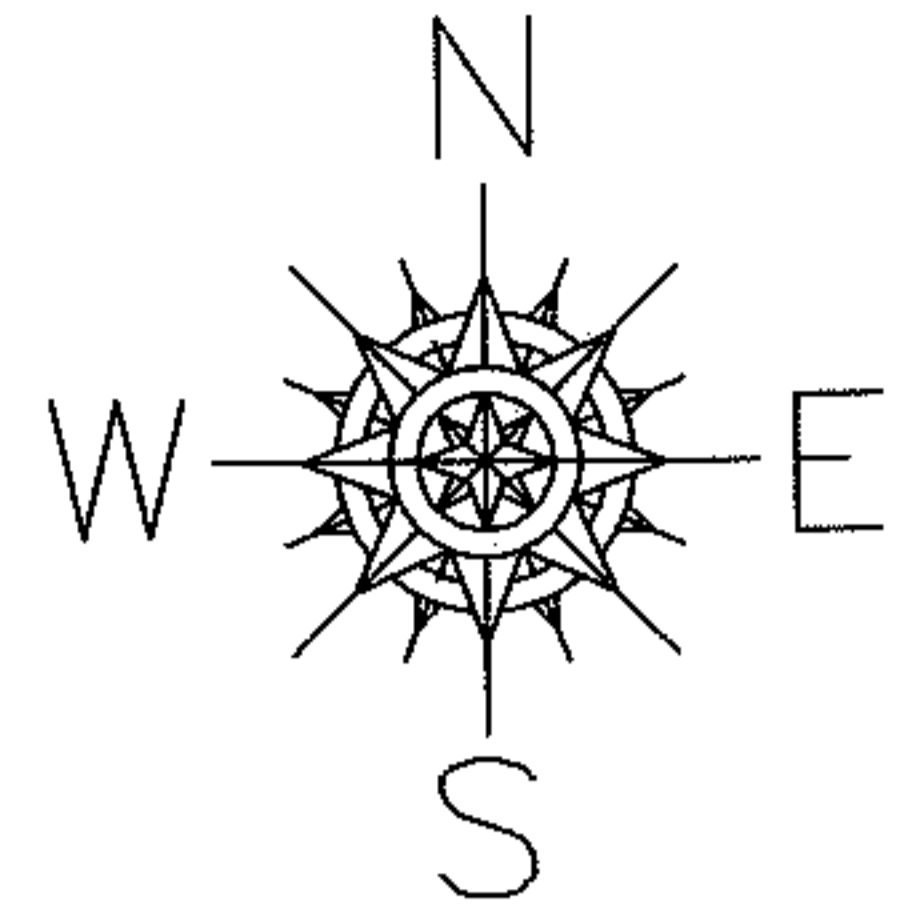

UNCOMBINATION
PER PRIOR DEEDS
TO REMOVE UPDATE LEGAL
FOR 2 LEGALS, 1 PARCEL NO.

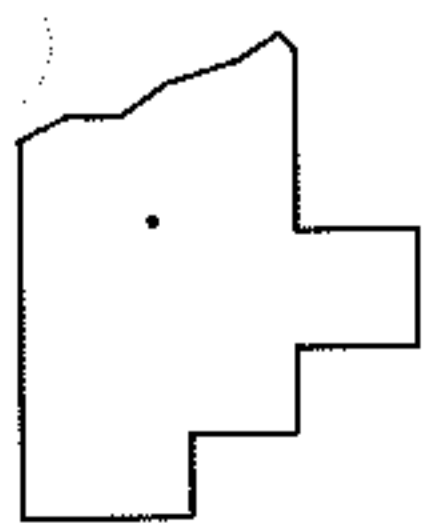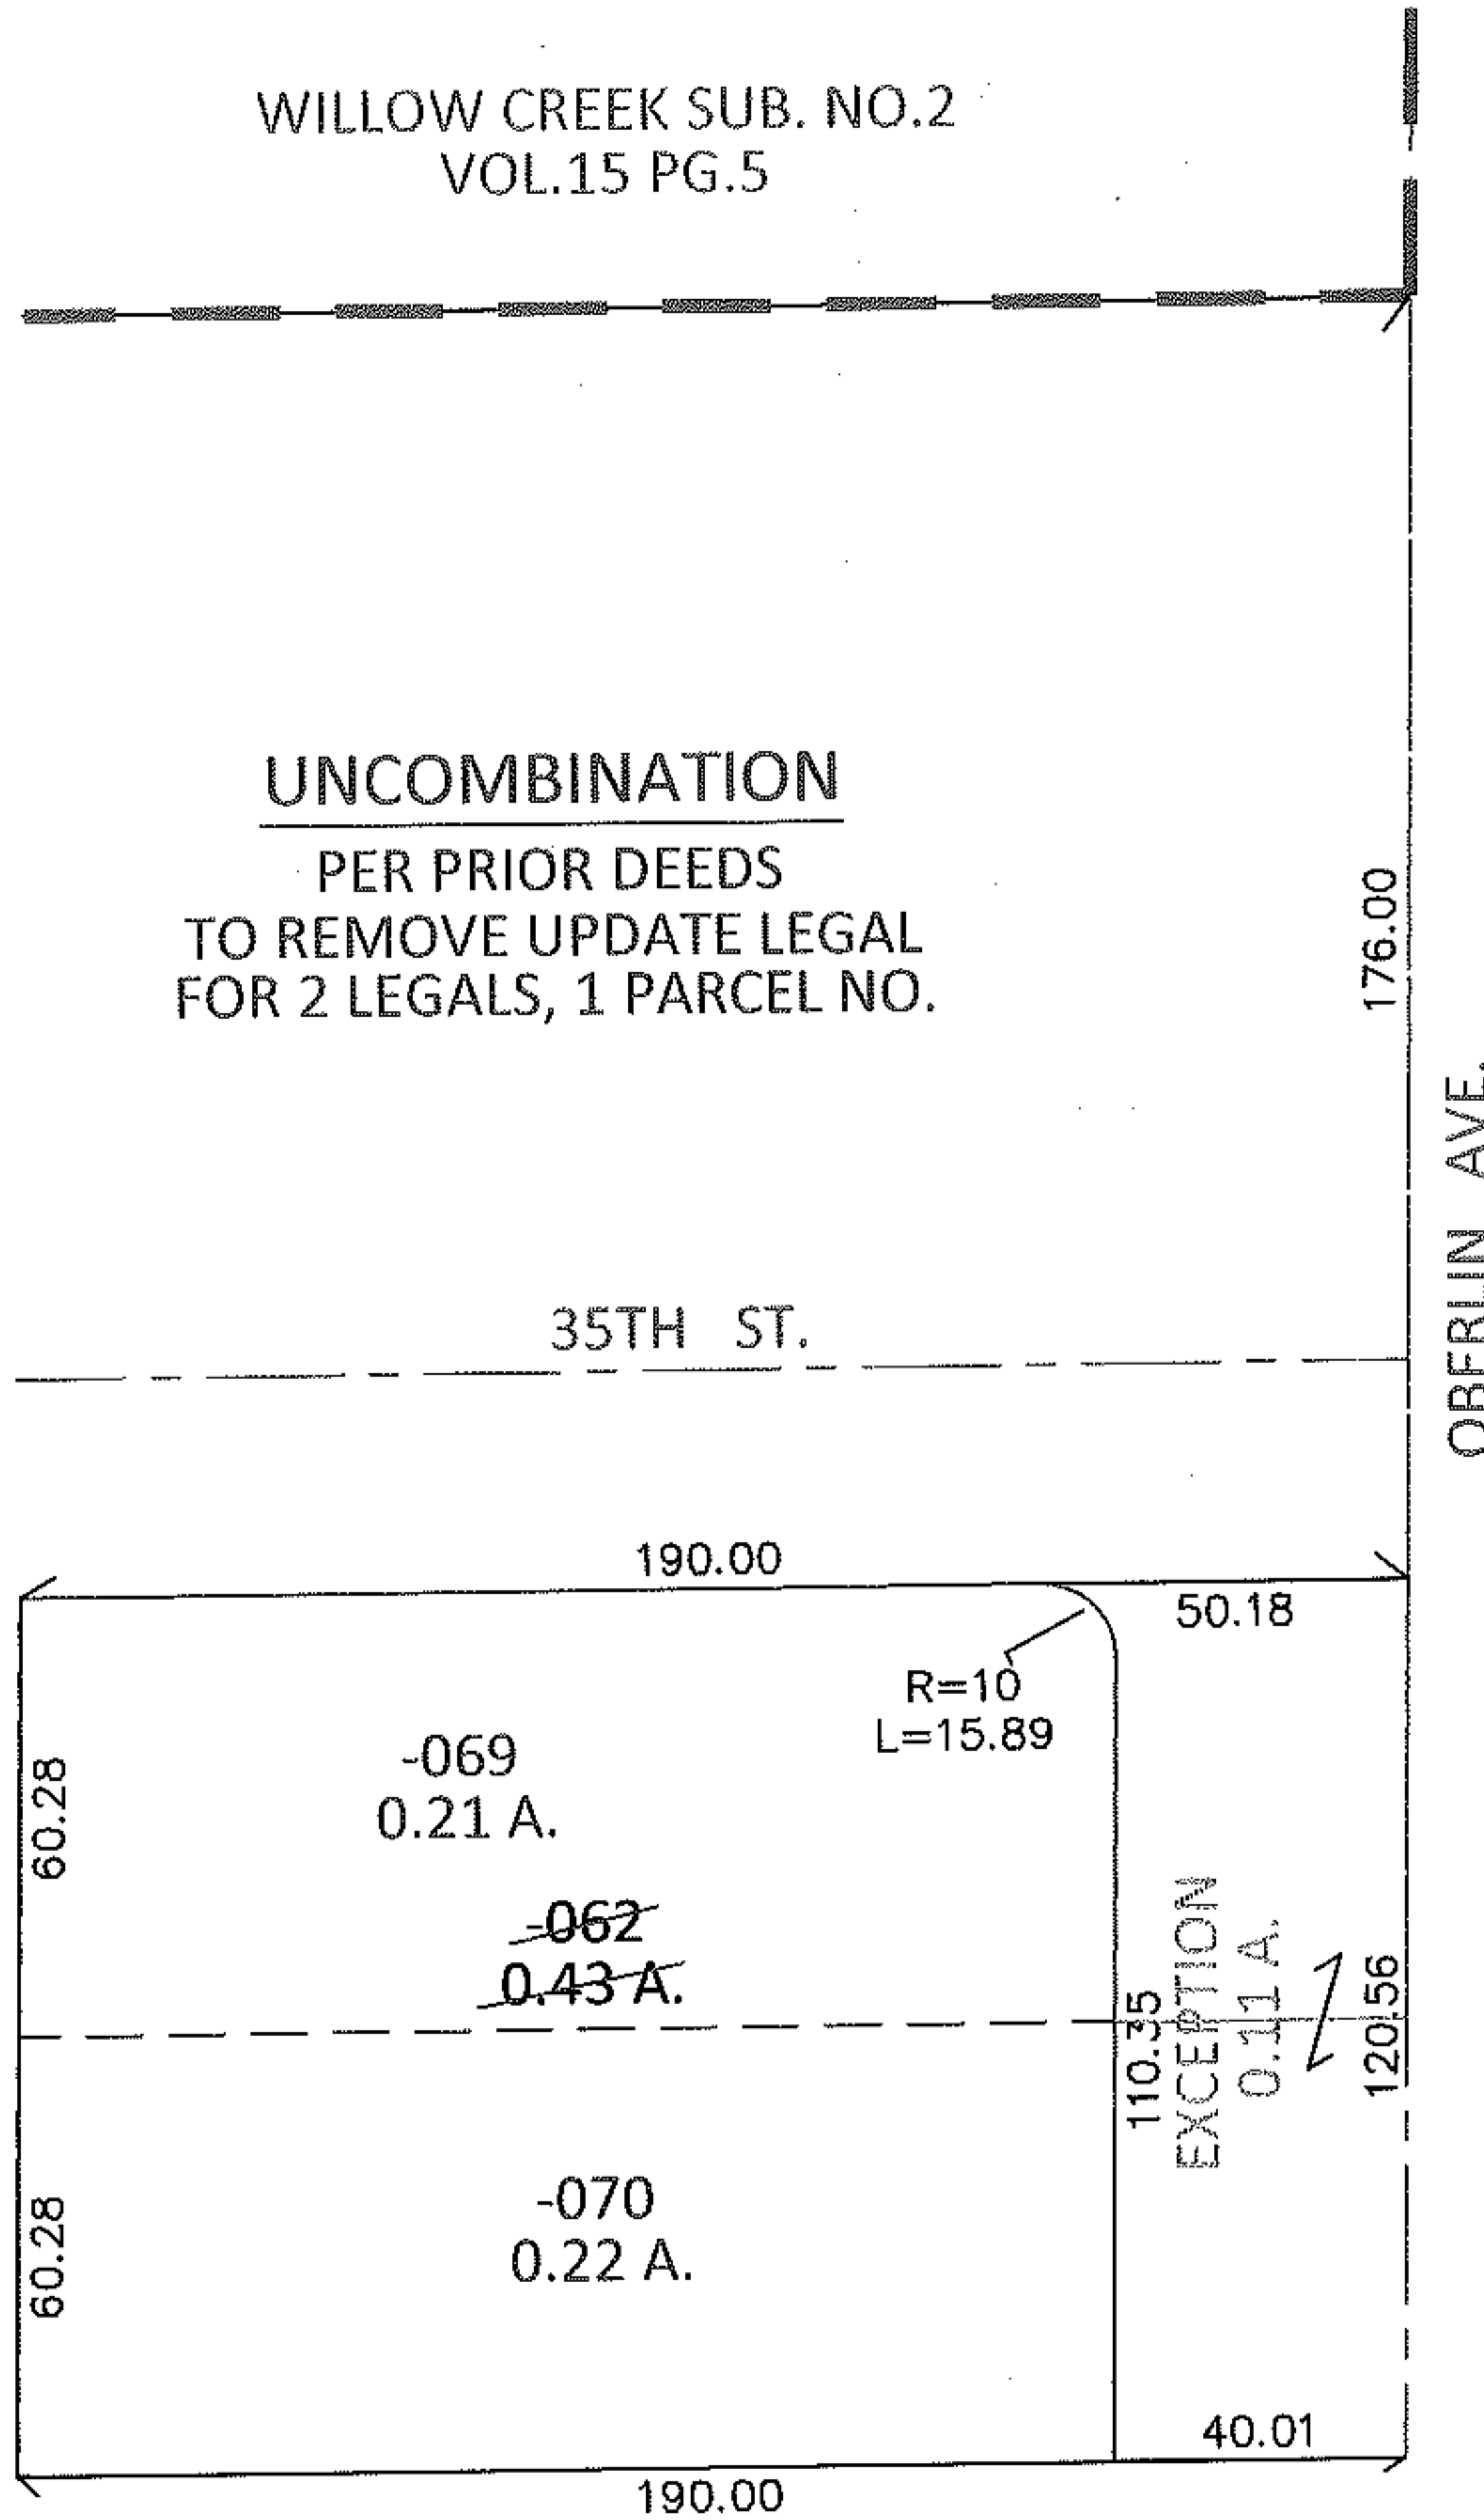

SPLITS/DEEDS PROCESSED

LORAIN COUNTY TAX MAP DEPARTMENT
226 MIDDLE AVE. ELYRIA, OHIO

SURVEYED BY: RAY E. HOLLIS

CLOSURE: .00:10,000

MAP PAGE(S): 2-02-015-B

APPROVED BY: RRM DATE: 1-25-13

SCALE: 1"= 50' PRIOR INST.: 20100345207