




RASTER

PARENT PARCEL: 04-00-025-000-332

CHILD PARCEL: 04-00-025-000-500, -501

STARTING POINT: CENTERLINE OF MILLS RD & EASTERLY LINE OF LORAIN COUNTY

08-02653

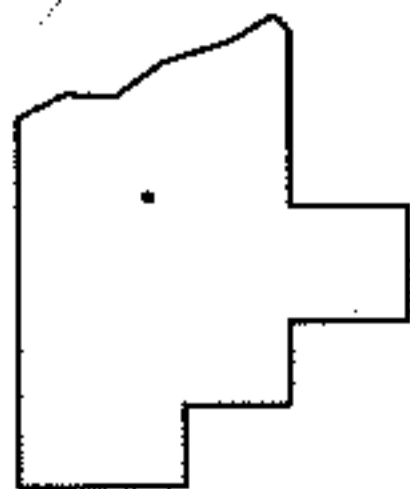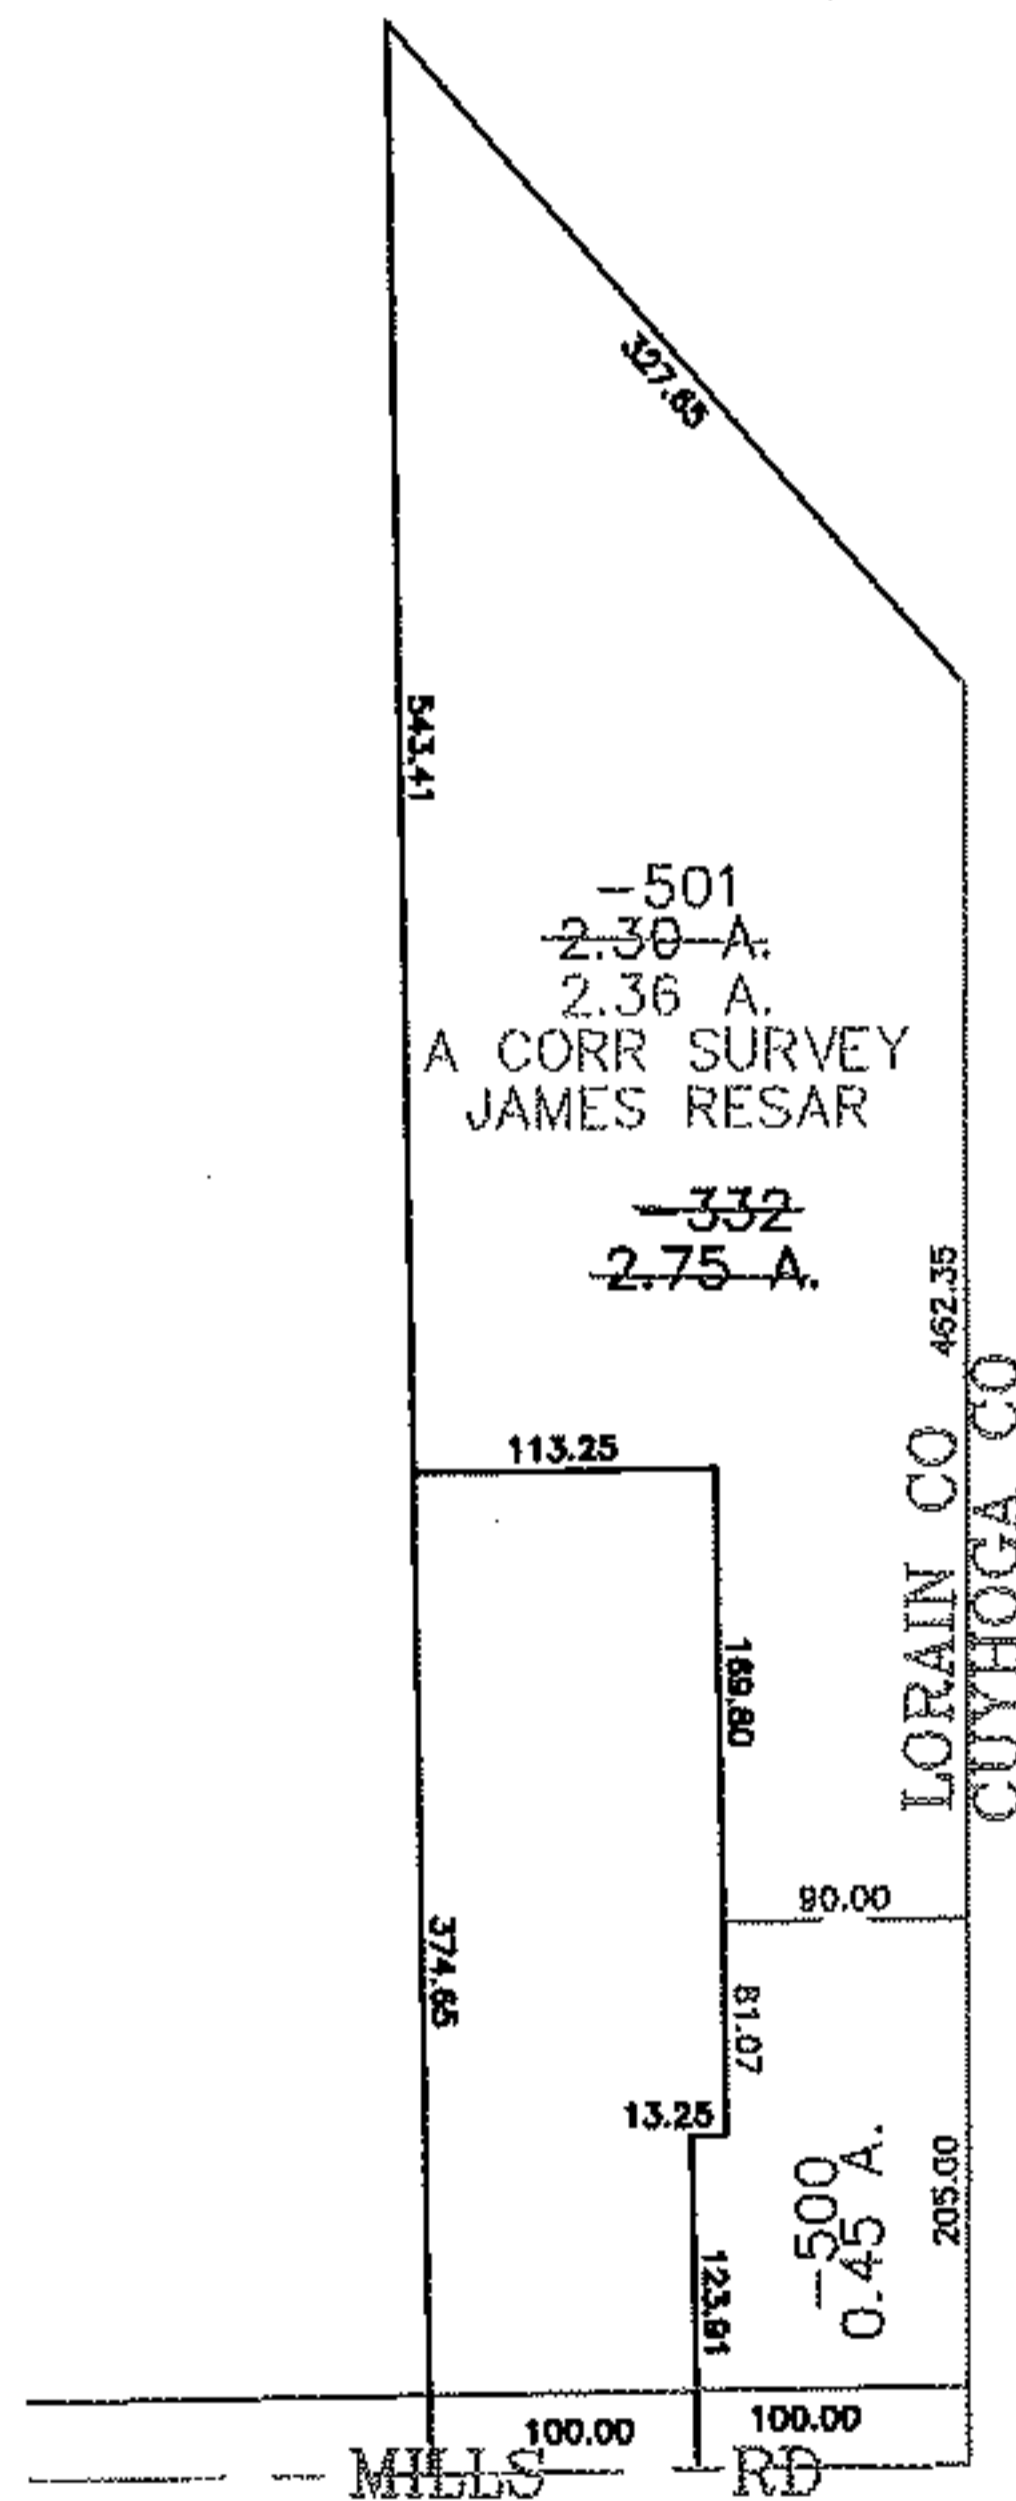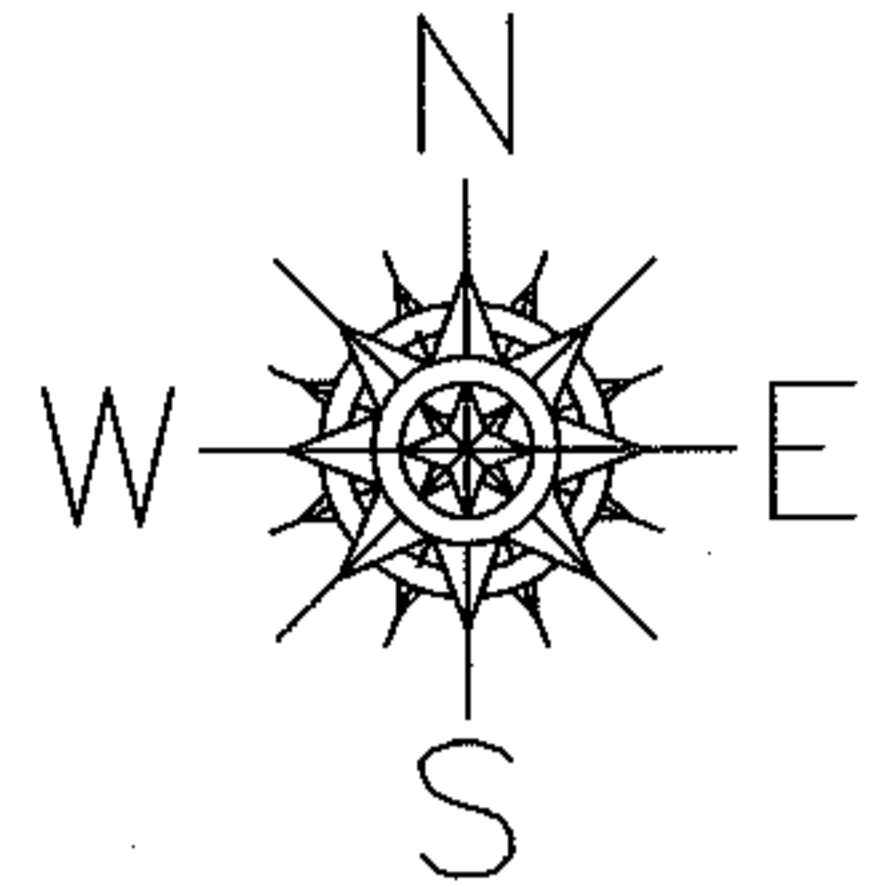

SPLITS/DEEDS PROCESSED
 LORAIN COUNTY TAX MAP DEPARTMENT
 226 MIDDLE AVE. ELYRIA, OHIO

SURVEYED BY: JAMES RESAR
 CLOSURE: 0.00 : 10.00
 MAP PAGE(S): 04-00-025-H
 APPROVED BY: JAH DATE: 12-22-08
 SCALE: 1" = 200 PRIOR INSTRUMENT: 20040041139