




RASTER

PARENT PARCEL: 07-00-008-115-092, -090

CHILD PARCEL: 07-00-008-115-093 THRU -095

STARTING POINT: CENTERLINE OF CENTER RIDGE RD & O.L. 8

08-02654

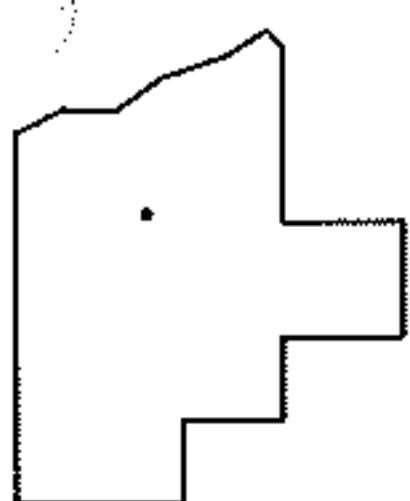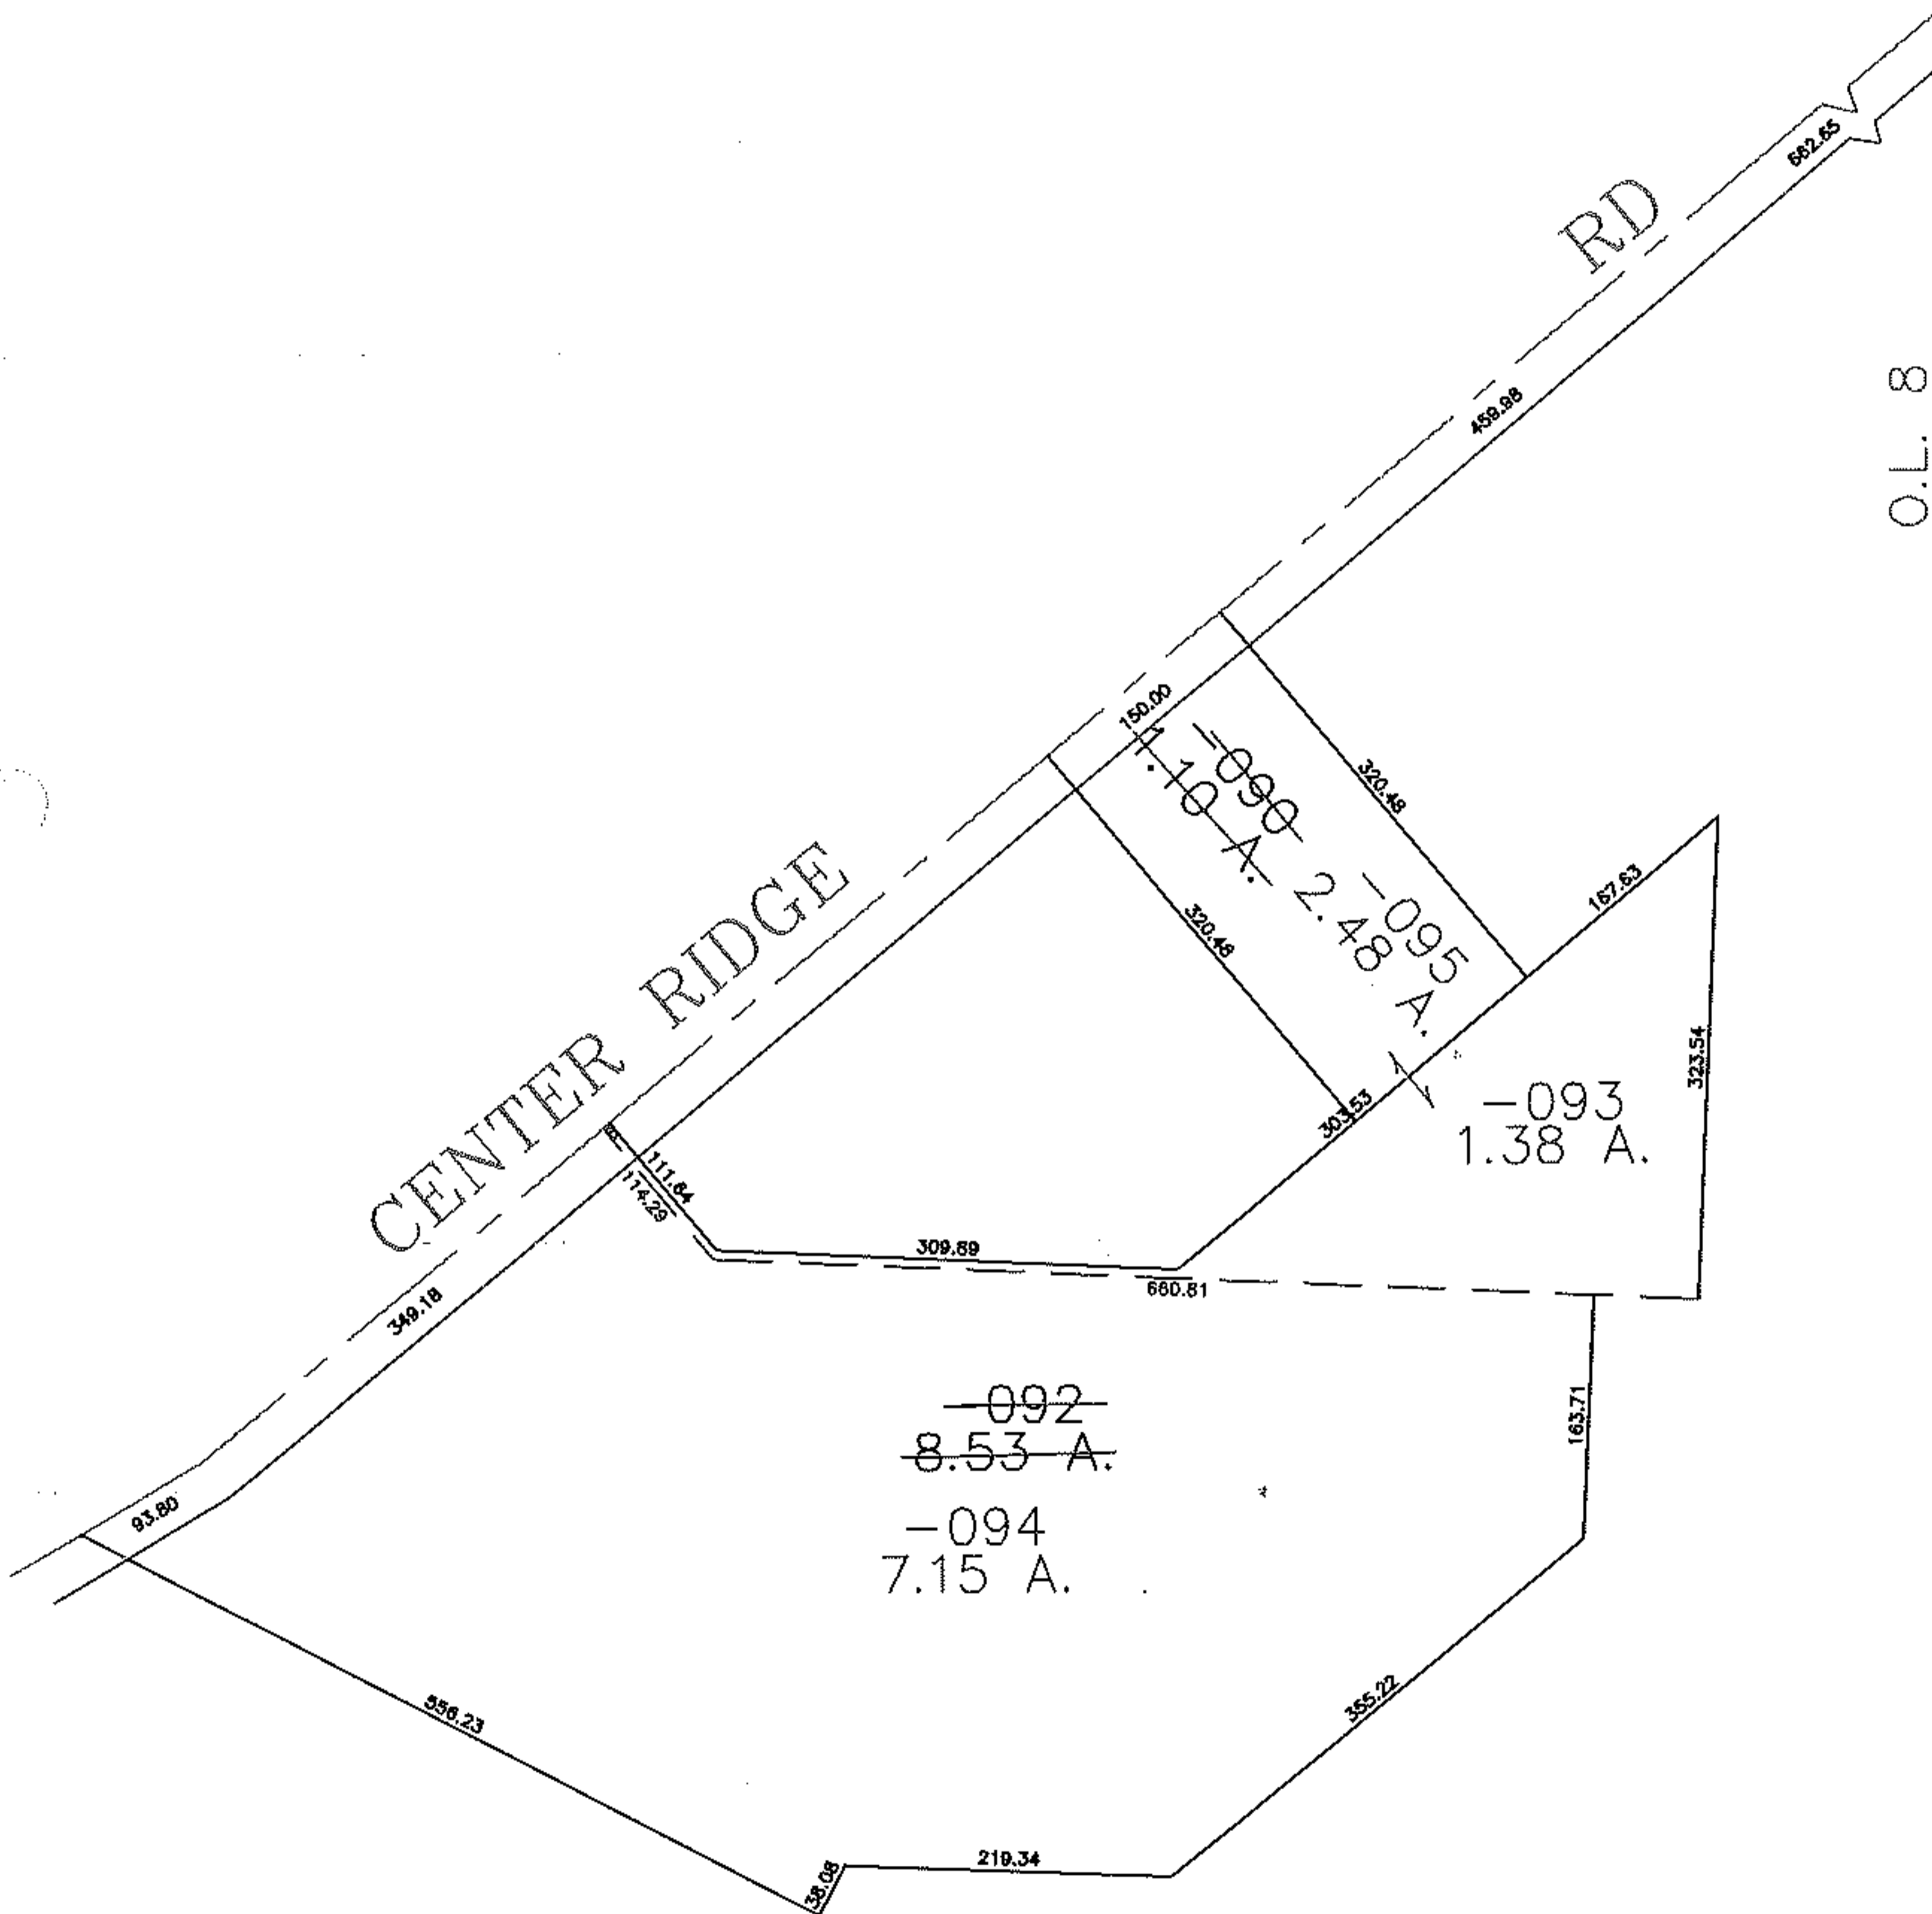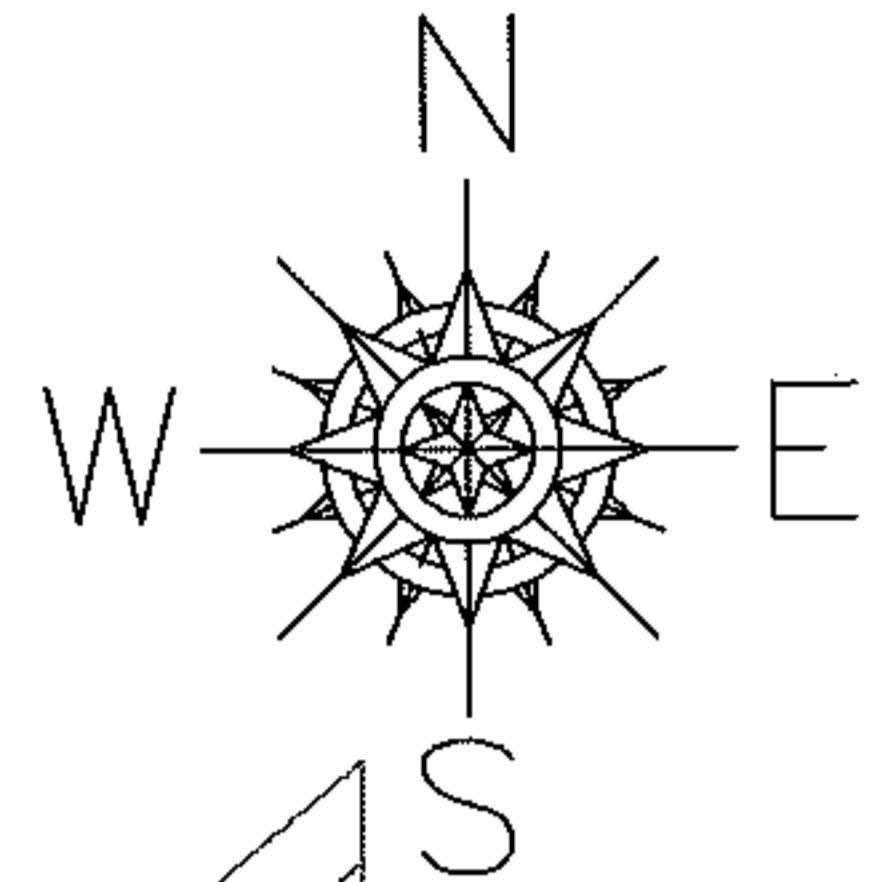

SPLITS/DEEDS PROCESSED
LORAIN COUNTY TAX MAP DEPARTMENT
226 MIDDLE AVE. ELYRIA, OHIO

SURVEYED BY: CHRISTOPHER HIRZEL
CLOSURE: 0.00 : 10,000
MAP PAGE(S): 07-00-008-D
APPROVED BY: JAH DATE: 12-29-08
SCALE: 1" = 200 PRIOR INSTRUMENT: 20080236865