


PARENT PARCEL: 06-24-015-000-001



CHILD PARCEL: XX-XX-XXX-XXX-XXX

STARTING POINT: CL OF MURRAY RDGE & CL OF TELEGRAPH RD.

13-02655-C

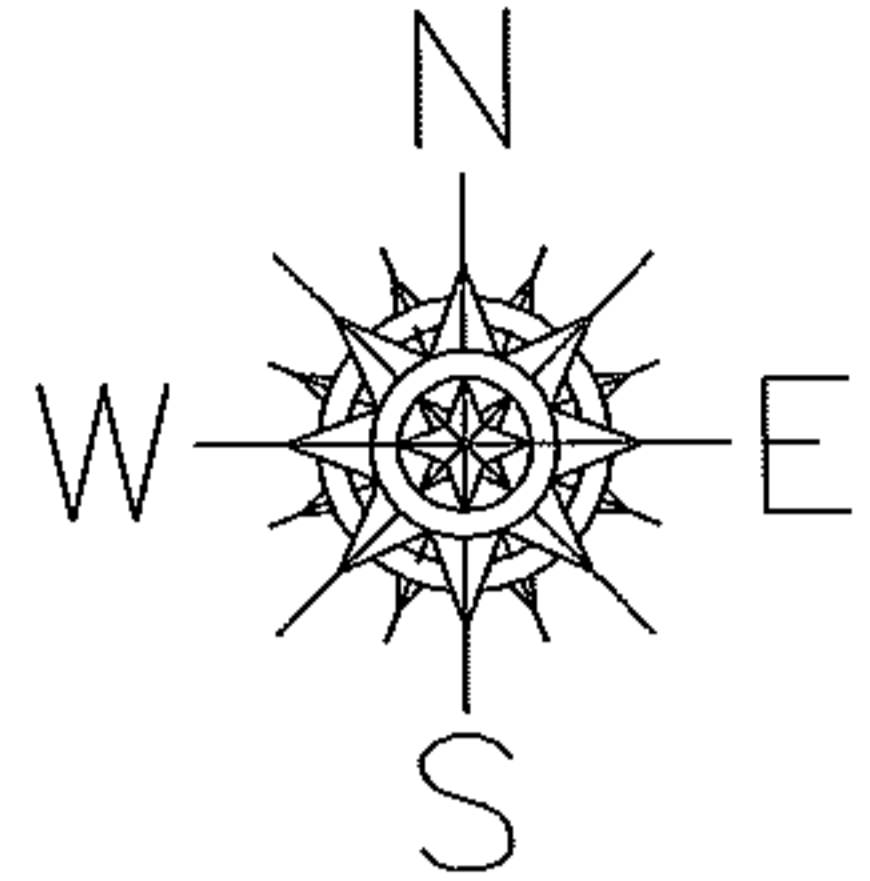

MAP CORRECTION ONLY

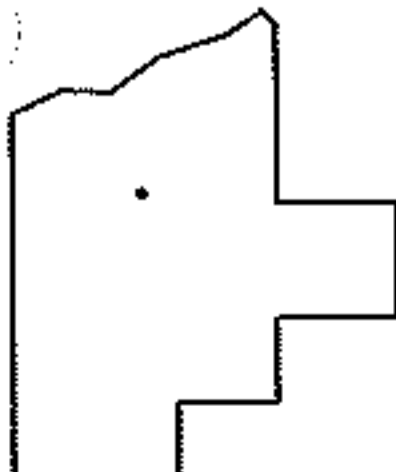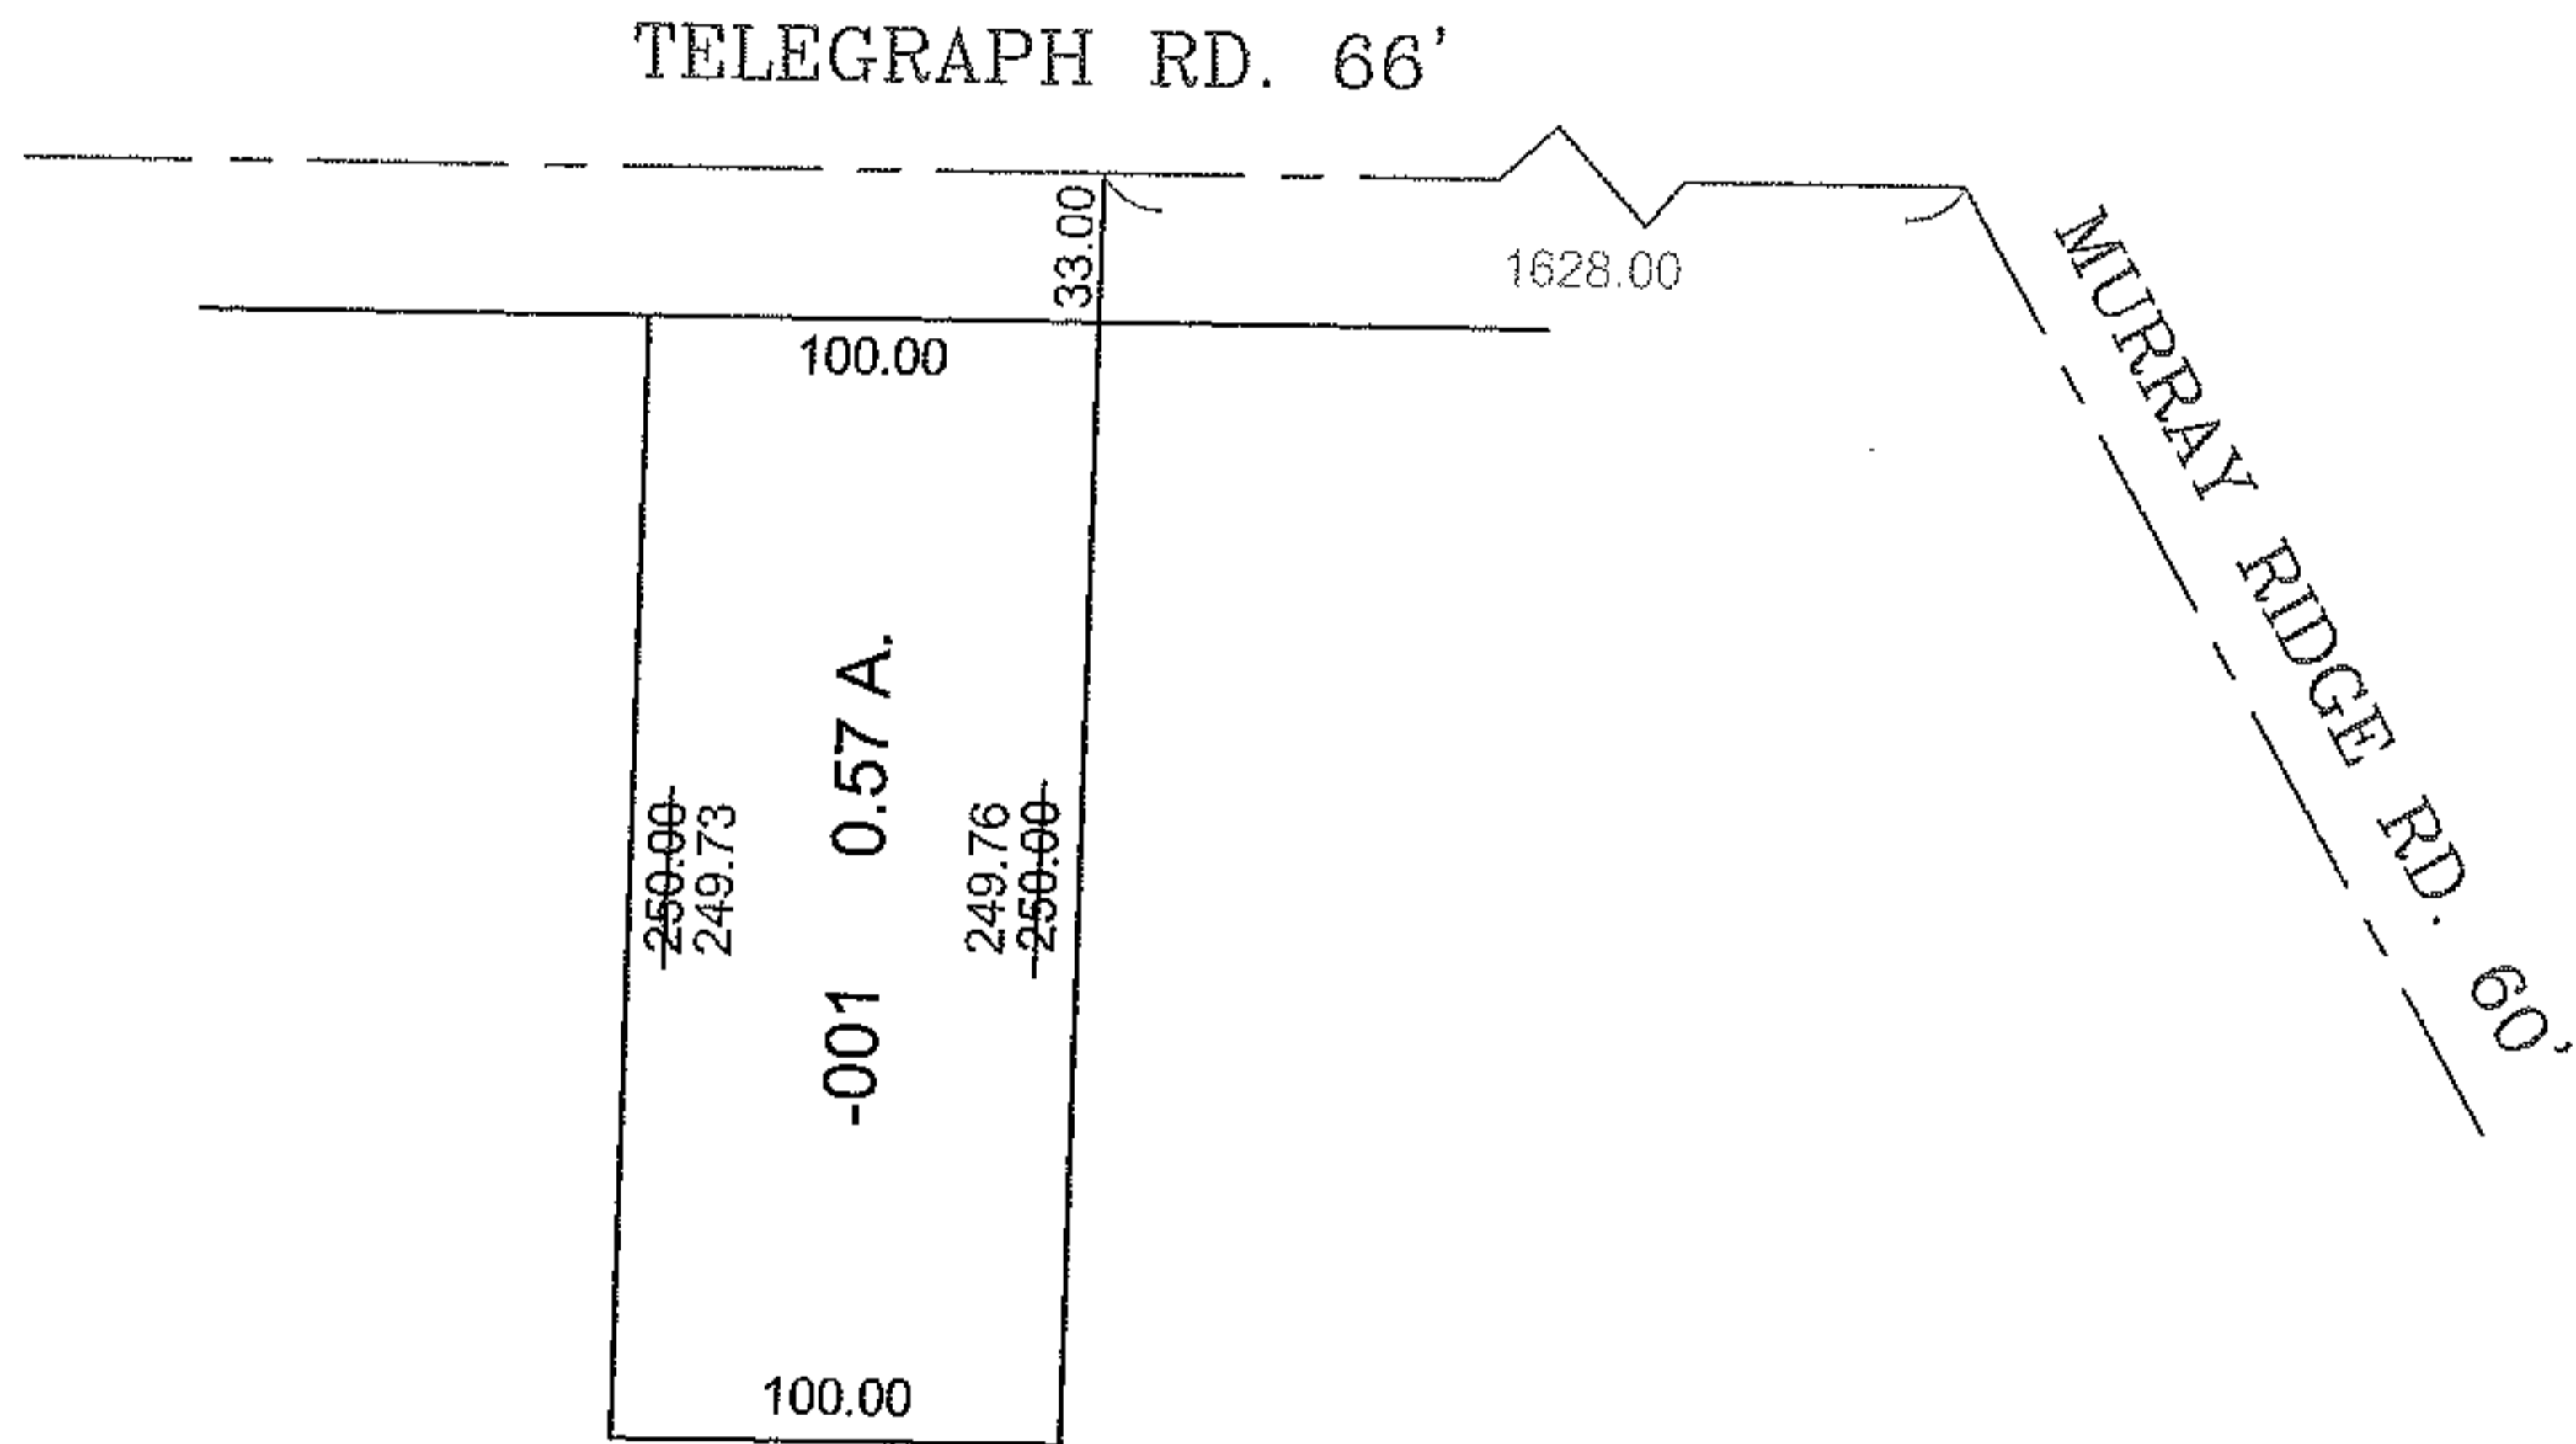

SPLITS/DEEDS PROCESSED
 LORAIN COUNTY TAX MAP DEPARTMENT
 226 MIDDLE AVE. ELYRIA, OHIO

SURVEYED BY: TIMOTHY E. STOCKER
 CLOSURE: 0.01 : 10,000
 MAP PAGE(S): 6-92
 APPROVED BY: TJS DATE: 1/30/13
 SCALE: 1"= 100 PRIOR INST.: 20120426788