
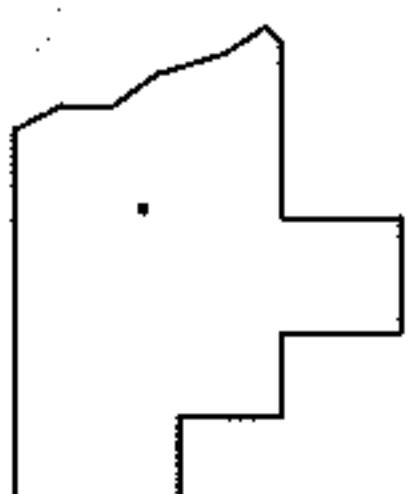
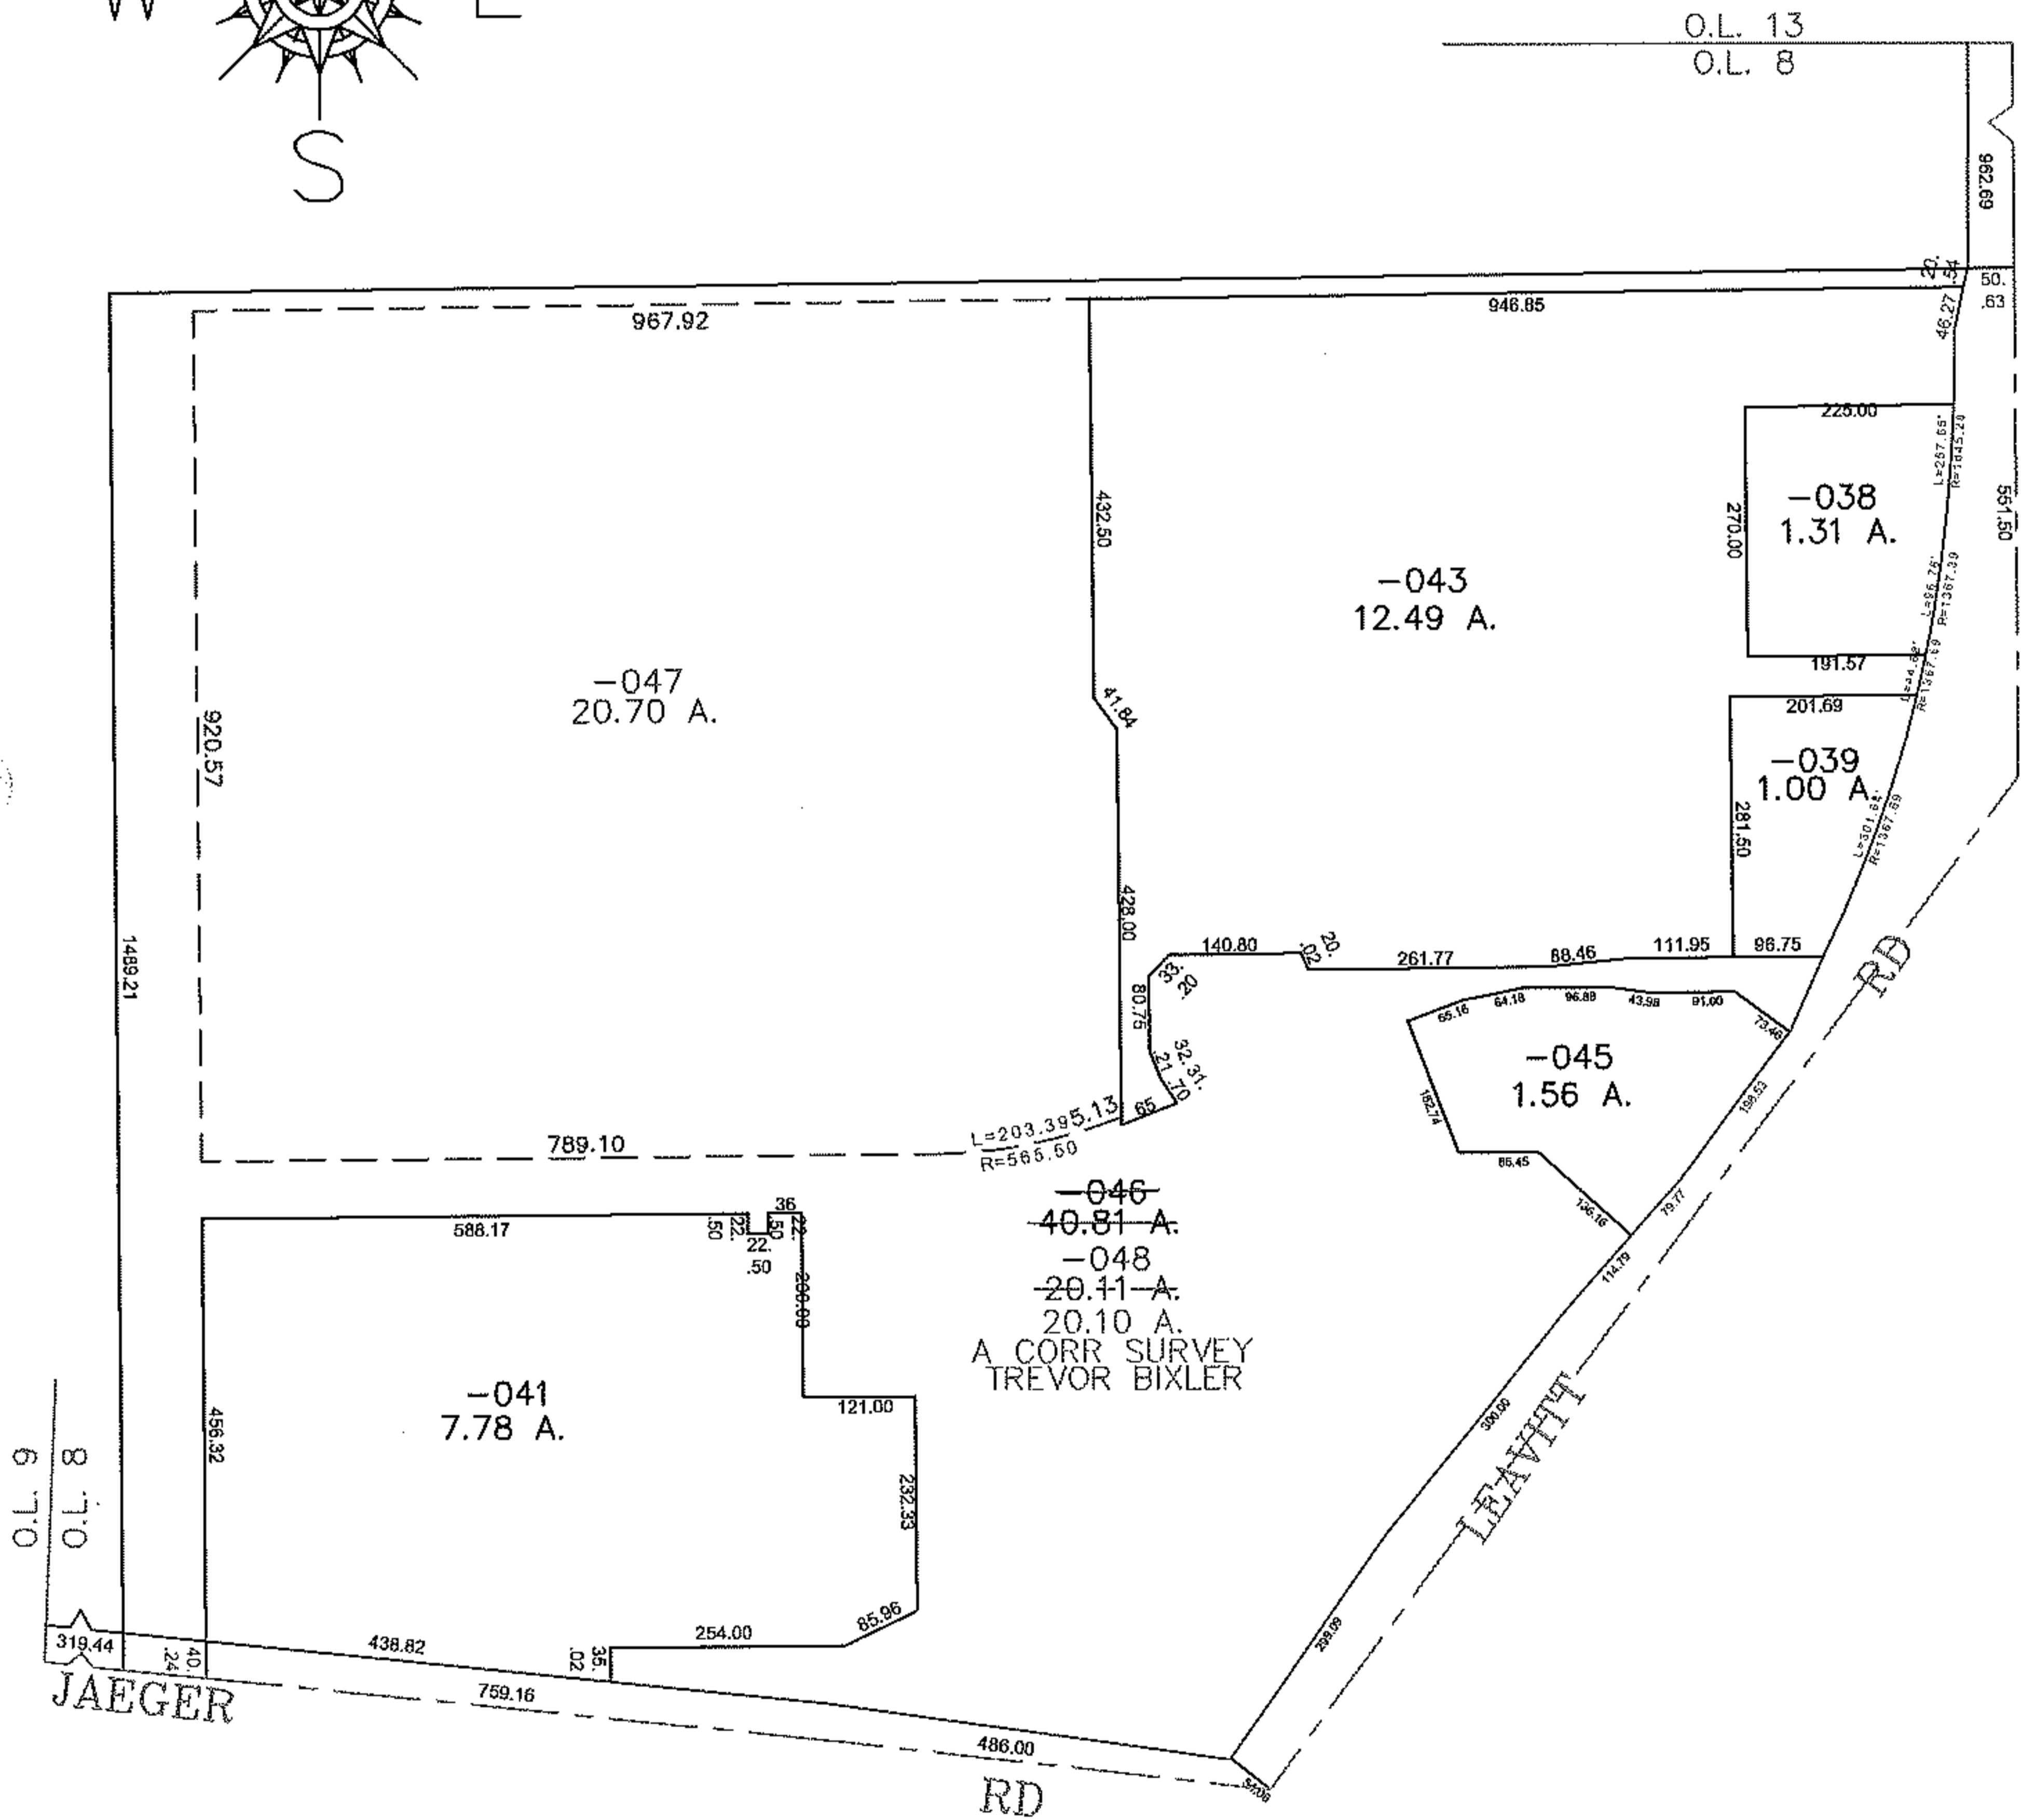


PARENT PARCEL: 02-02-008-107-046

CHILD PARCEL: 02-02-008-107-047, -048

STARTING POINT: CENTERLINE OF JAEGER RD & O.L. 8

09-02655

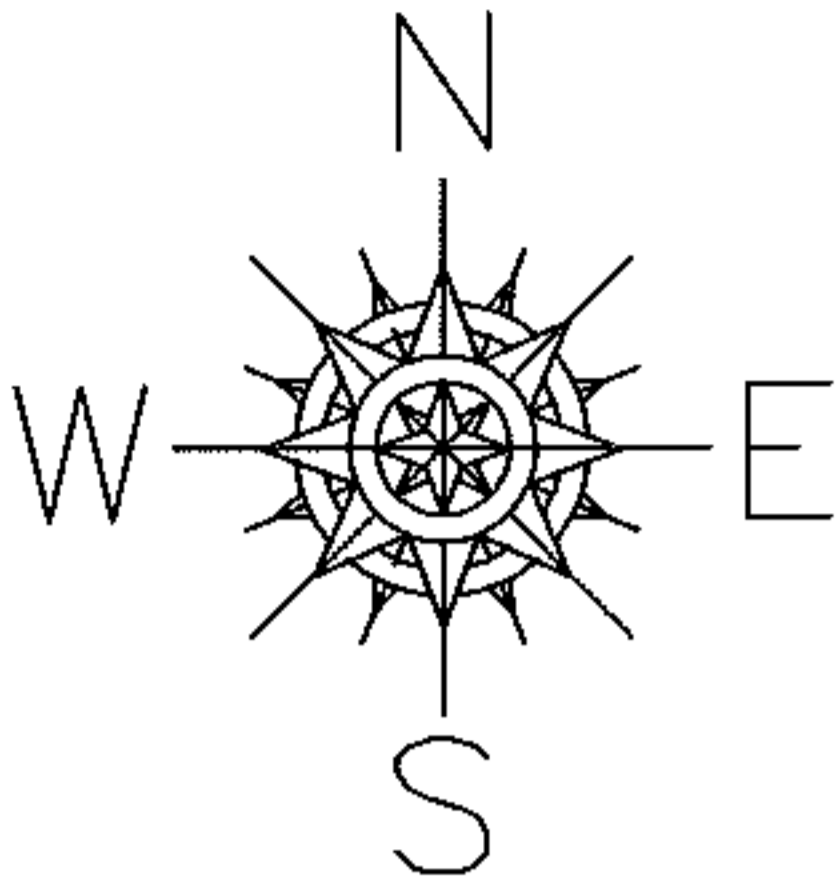

**SPLITS/DEEDS PROCESSED**  
 LORAIN COUNTY TAX MAP DEPARTMENT  
 226 MIDDLE AVE. ELYRIA, OHIO

SURVEYED BY: TREVOR BIXLER  
 CLOSURE: 0.00 : 10.000  
 MAP PAGE(S): 02-02-008-A,B  
 APPROVED BY: JAH DATE: 1-13-09  
 SCALE: 1" = 300 PRIOR INSTRUMENT: 20060138584