

PARENT PARCEL: 18-00-022-115-008 & -009

CHILD PARCEL: XX-XX-XXX-XXX-XXX

STARTING POINT: N.W. CORNER OF LAND IN FRED DOUGLAS DV 195/156

13-02658-C

FRONTAGE & DEPTH CORRECTION

18-00-022-115-008

~~133 X 248~~

133.33 X 247.50 (15 RODS)

PER INST. # 20070215263


&

18-00-022-115-009


~~66.67 X 248~~

66.67 X 247.50 (15 RODS)

PER DV 528/46

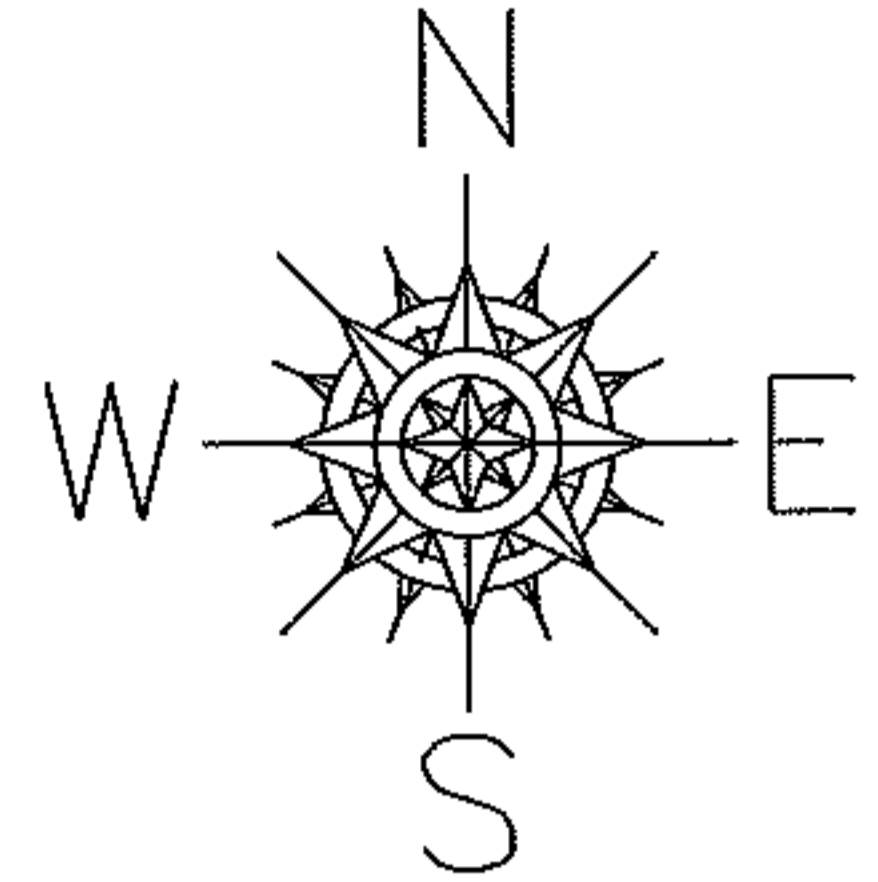

HARRICK AVENUE EAST 66'

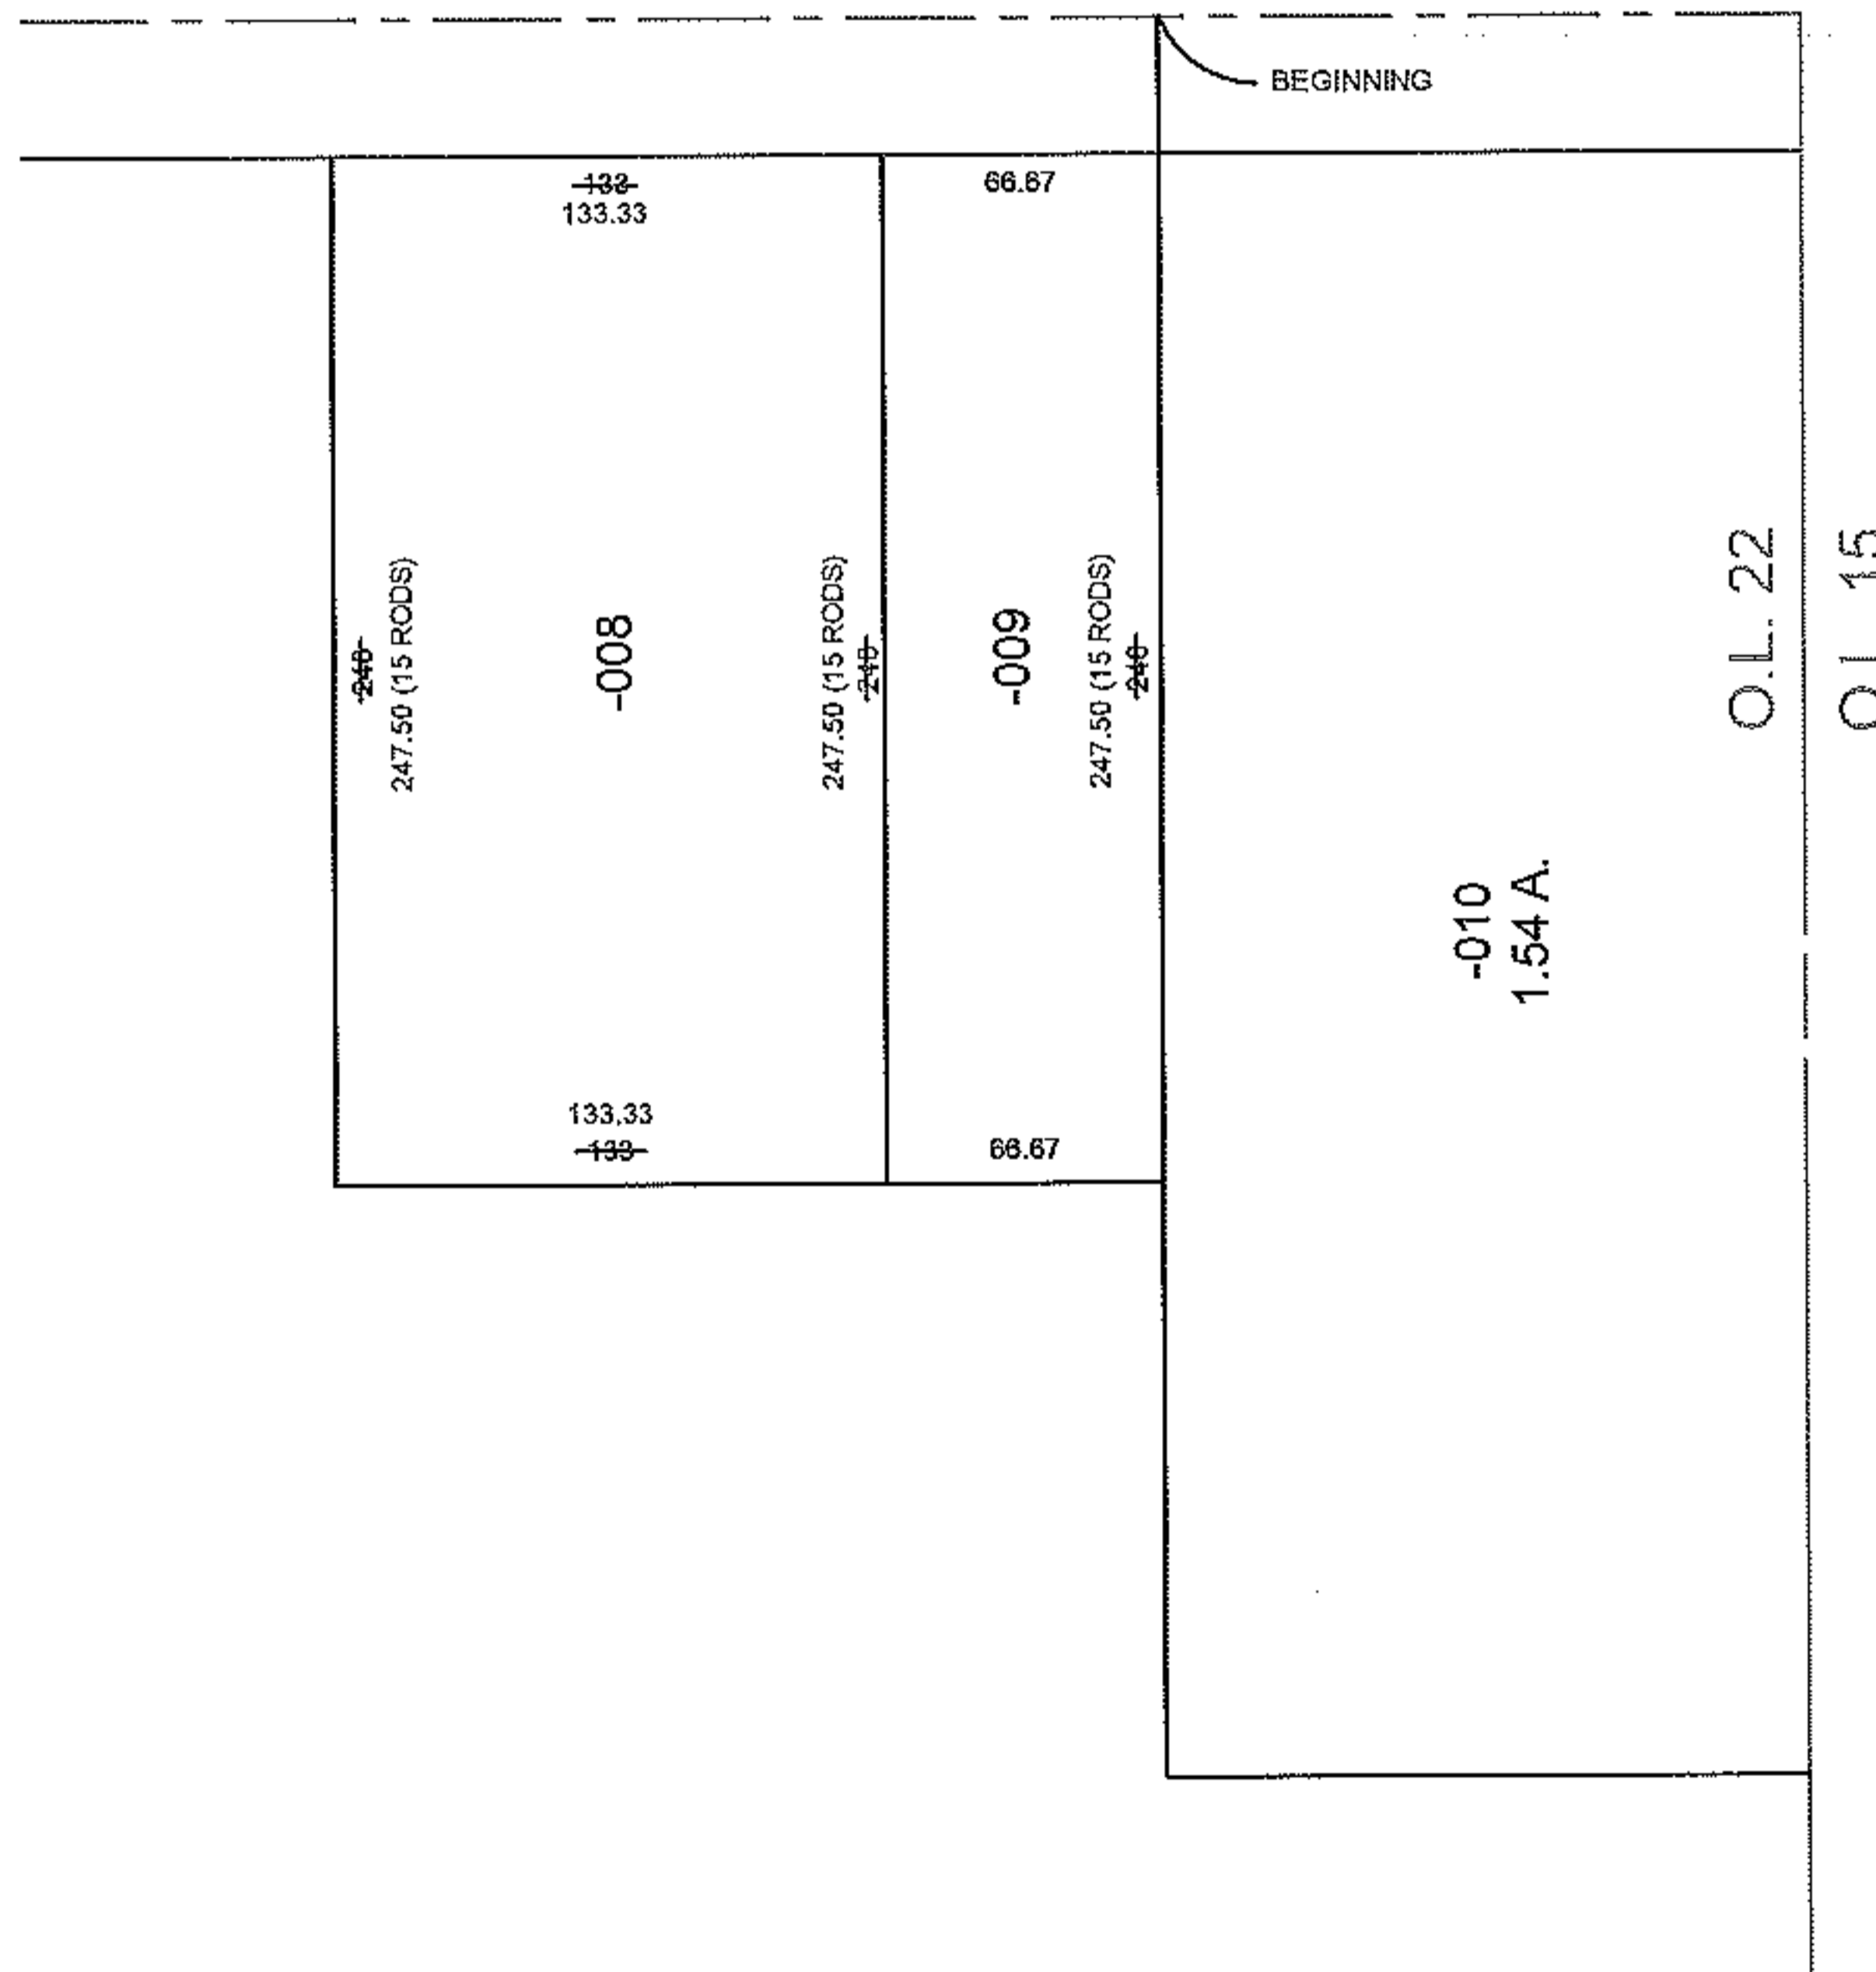

SPLITS/DEEDS PROCESSED

LORAIN COUNTY TAX MAP DEPARTMENT
226 MIDDLE AVE. ELYRIA, OHIO

SURVEYED BY: NONE

CLOSURE: 0.00 : 10,000

MAP PAGE(S): 18-00-022-B

APPROVED BY: TJS DATE: 2/6/13

SCALE: 1" = 100 PRIOR INSTRUMENT: 20030911966