
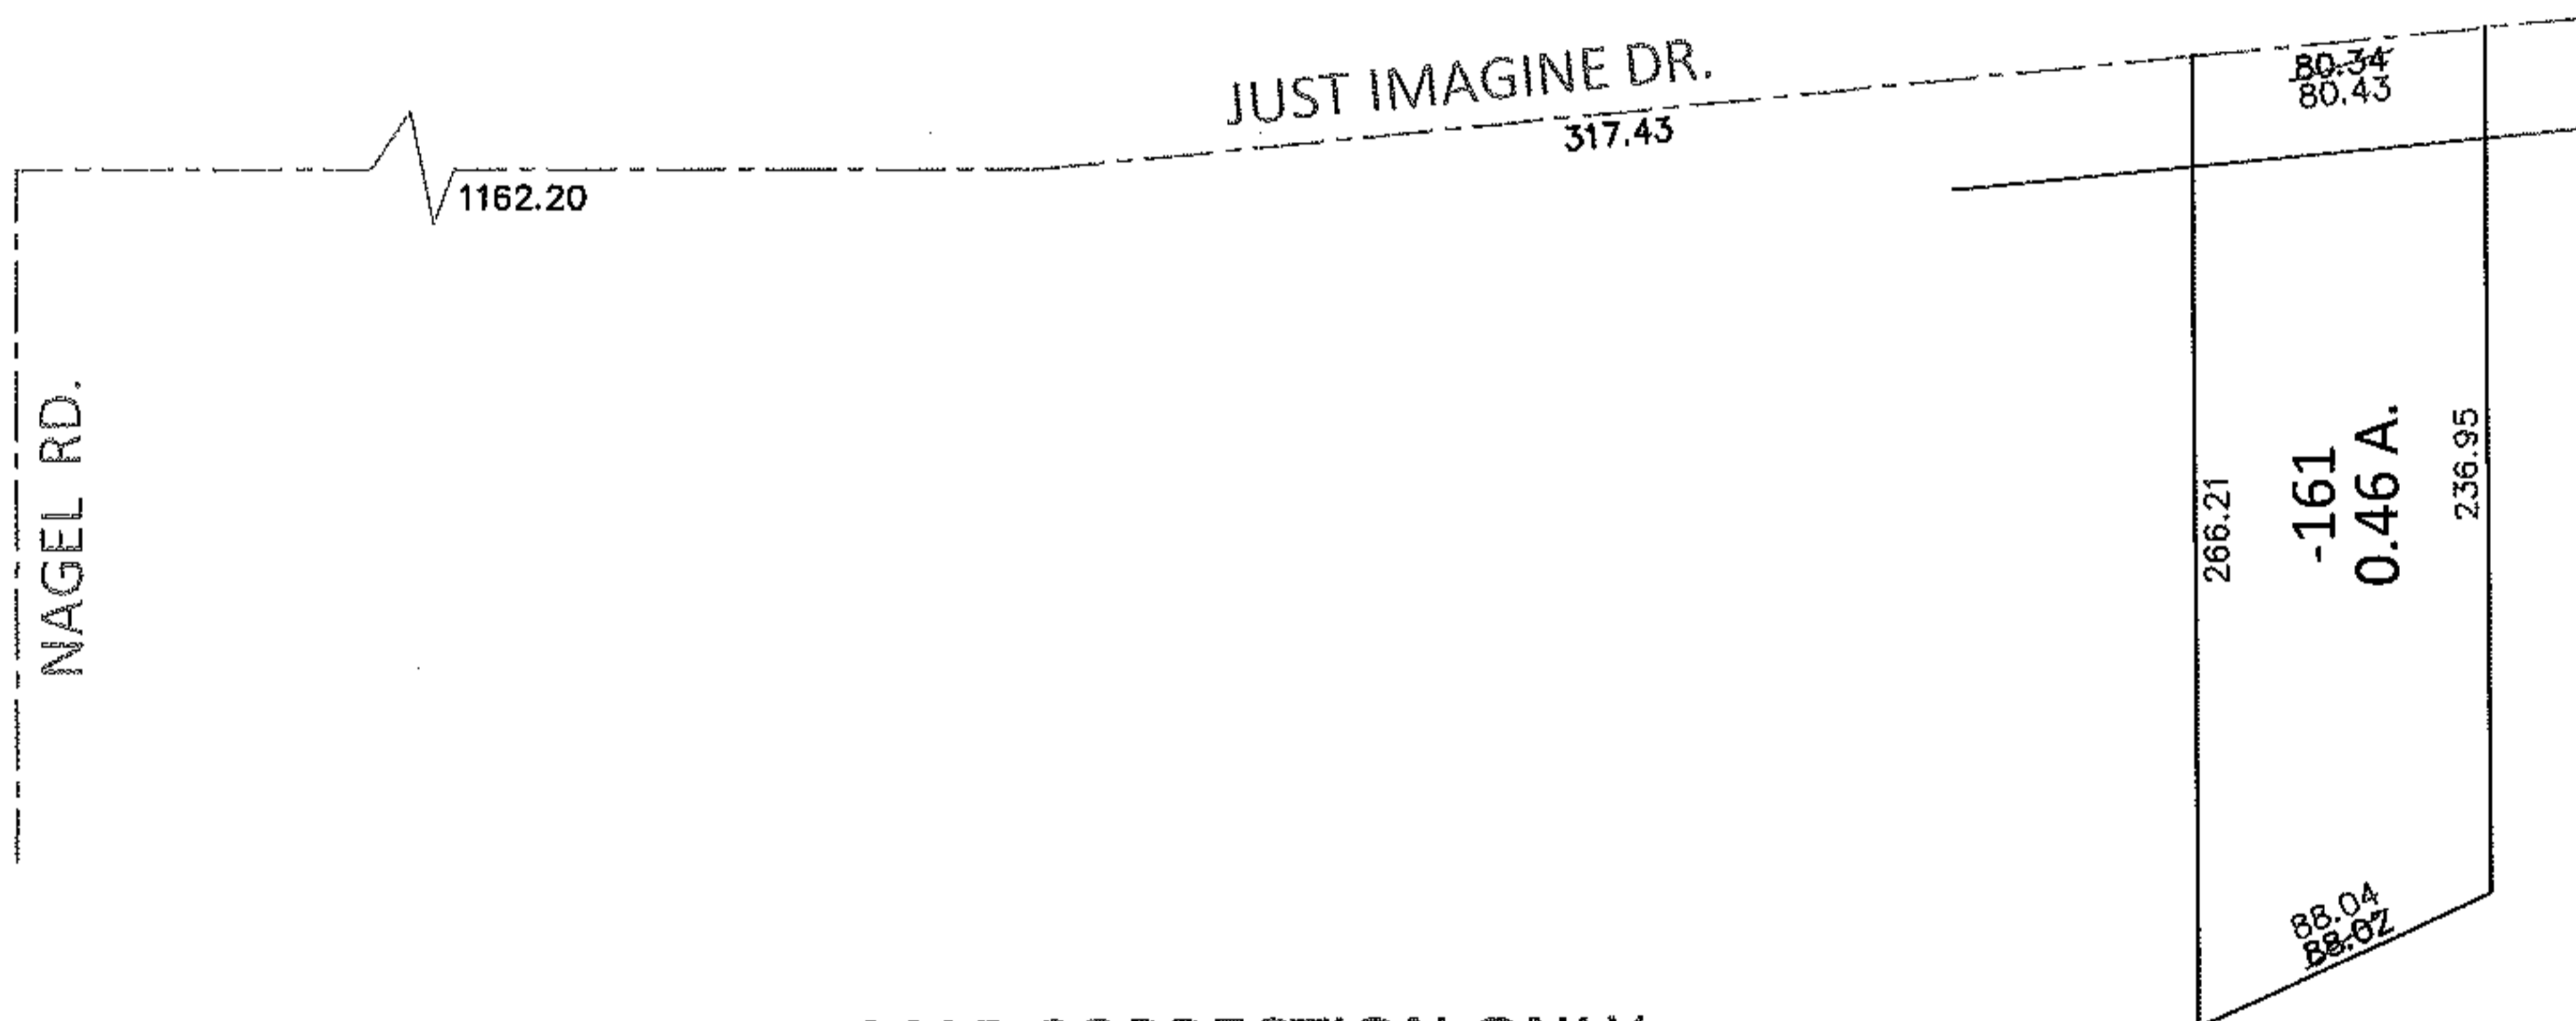


PARENT PARCEL: 04-00-028-102-161


CHILD PARCEL: _____

13-02662-C

STARTING POINT: INTERSECTION OF C/L OF JUST IMAGINE DR. AND C/L OF NAGEL RD.

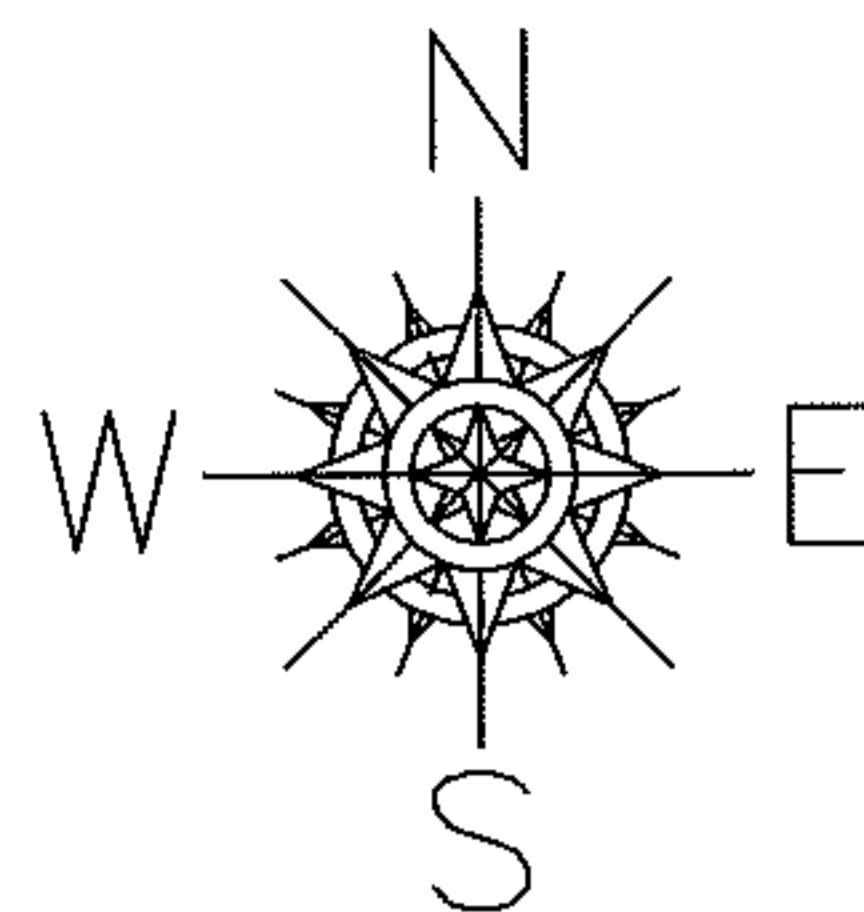

MAP CORRECTION ONLY

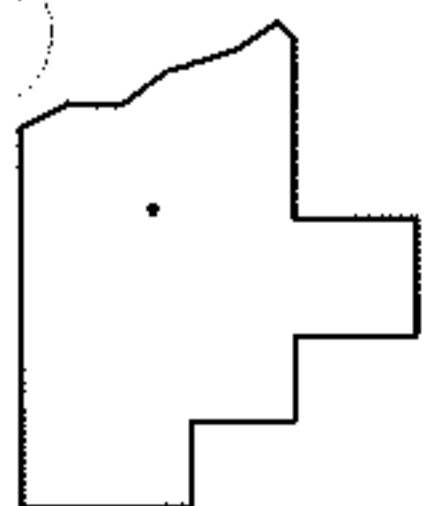

SPLITS/DEEDS PROCESSED

LORAIN COUNTY TAX MAP DEPARTMENT
226 MIDDLE AVE. ELYRIA, OHIO

SURVEYED BY: MICHAEL P. SPELLACY

CLOSURE: .01:10,000

MAP PAGE(S): 4-00-028-E

APPROVED BY: RRM DATE: 2-7-13

SCALE: 1"= 100 PRIOR INST.: 20110377275