

PARENT PARCEL: 14-00-030-000-018

CHILD PARCEL: XX-XX-XXX-XXX-XXX

STARTING POINT: SOUTHERLY LINE OF LAND CONVEYED TO LEO F.W. FARBER & CL OF QUARRY RD.

13-02663-C


ACREAGE CORRECTION

14-00-030-000-018

~~19.63 A.~~

19.64 A.

CORR. PER
OR 157/246

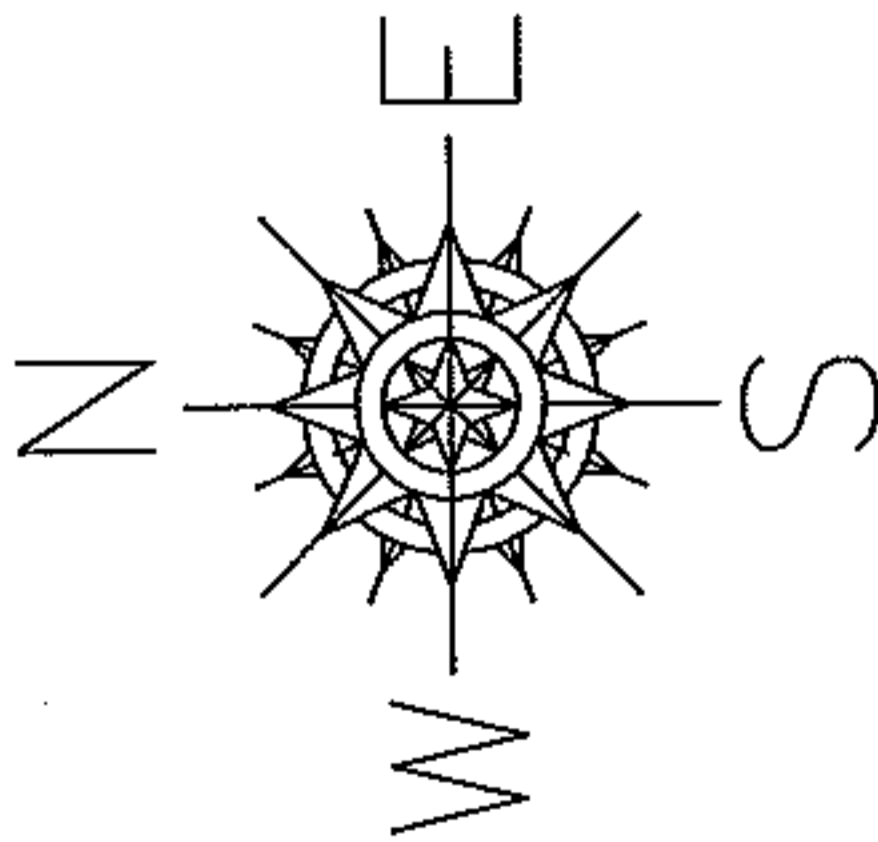

120' VARIABLE

(U.S. 20 / S.R. 10)

NORWALK - KIPTON EAST

QUARRY RD. 60'

2852.19

3060.70

-018

~~19.63 A.~~
19.64 A.

CORR. PER
OR 157/246

2852.19

300.00

300.00

SPLITS/DEEDS PROCESSED

LORAIN COUNTY TAX MAP DEPARTMENT
226 MIDDLE AVE. ELYRIA, OHIO

SURVEYED BY: NONE

CLOSURE: 0.00 : 10,000

MAP PAGE(S): 14-A

APPROVED BY: TJS DATE: XX/XX/XX

SCALE: 1"= 400 PRIOR INST.: OR 157/246