
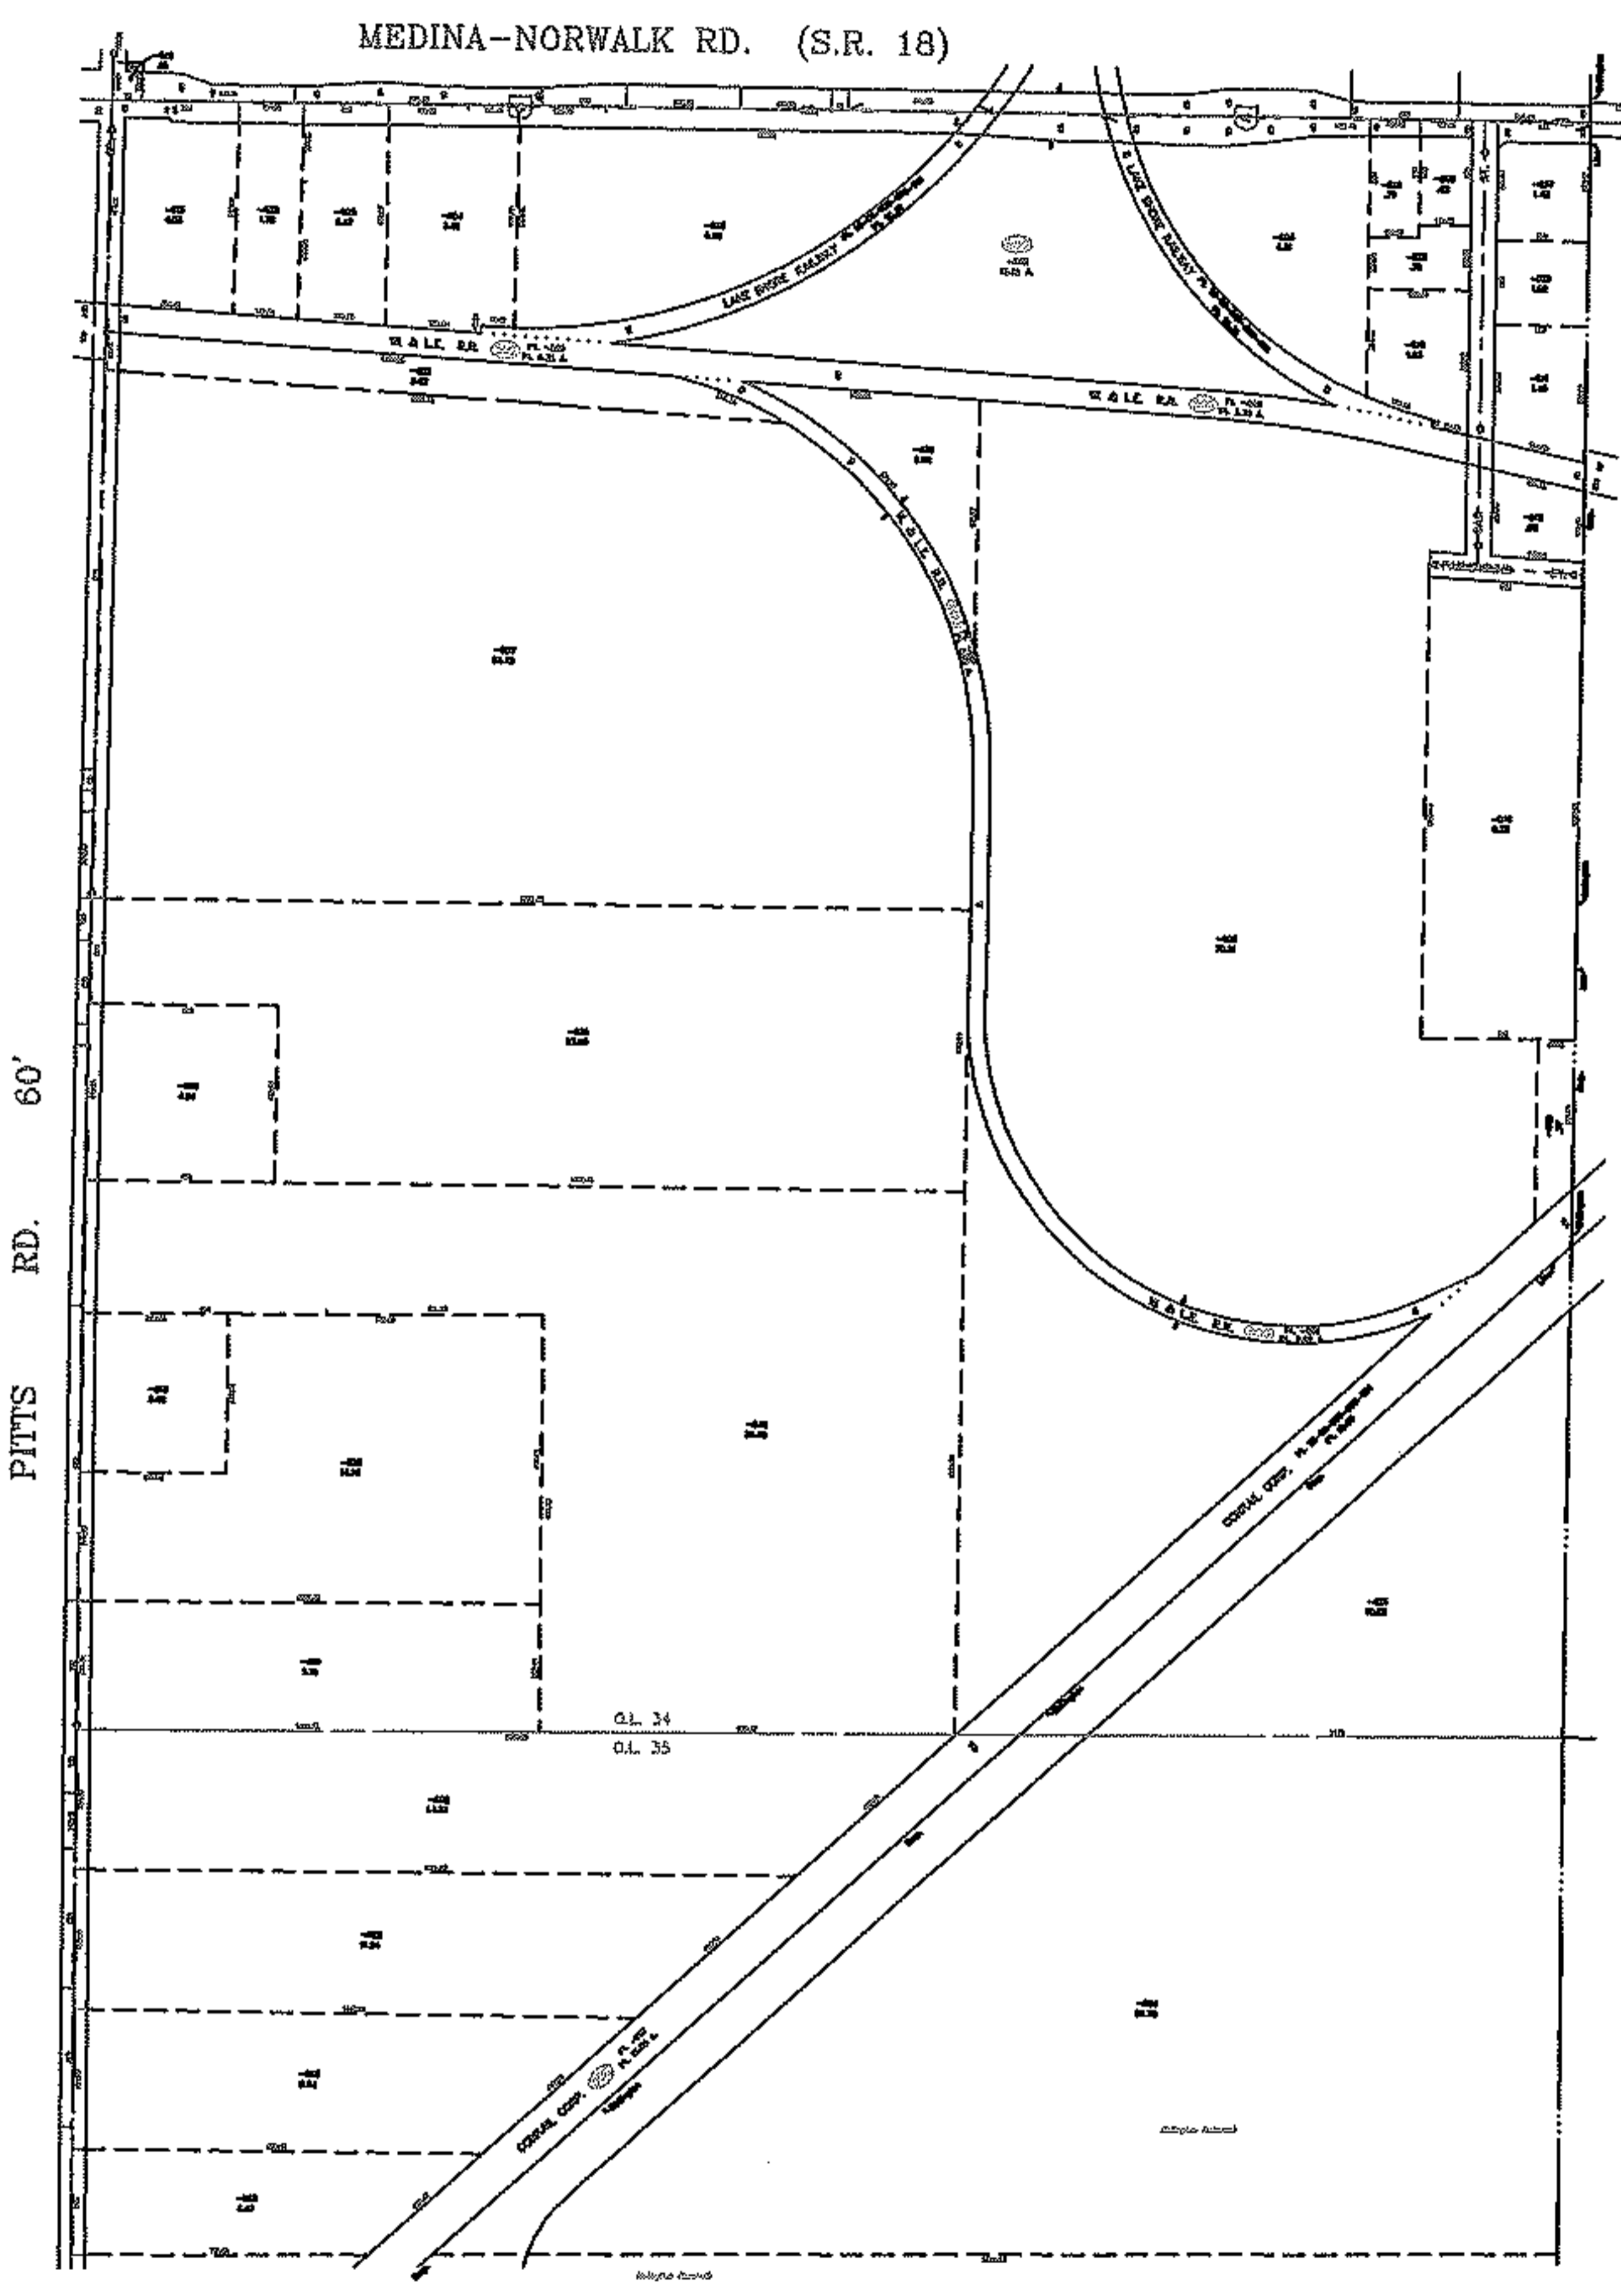


PARENT PARCEL: XX-XX-XXX-XXX-XXX
CHILD PARCEL: XX-XX-XXX-XXX-XXX
STARTING POINT: XXXXXX

13-02664-C

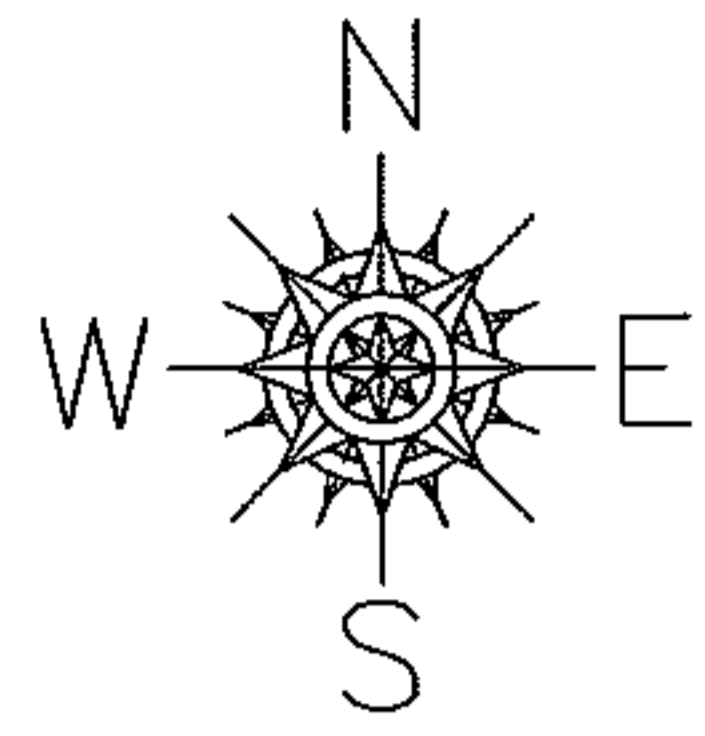

TAX MAP REGISTER CORRECT

AUDITORS DEVNET
CORRECTION ONLY

DROP FROM DUP.

18-00-034-501-001
3.08 A.

&

18-00-034-501-001
3.08 A.

ADD TO DUP:

18-00-034-500-002
5.38 A.

&


18-00-034-500-003
13.69 A.

AC. CORR.

18-00-034-500-001
~~10.90 A.~~
3.08 A.

&

18-00-035-500-001
~~0.00 A.~~
10.90 A.

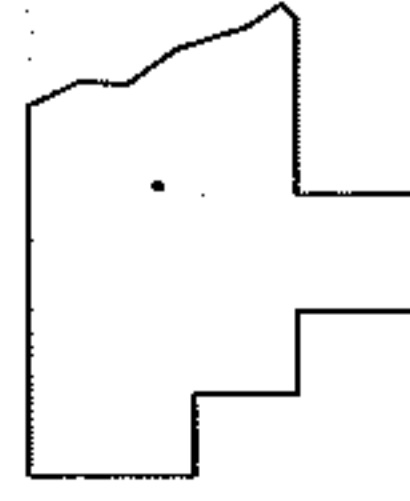

SPLITS/DEEDS PROCESSED

LORAIN COUNTY TAX MAP DEPARTMENT
226 MIDDLE AVE. ELYRIA, OHIO

SURVEYED BY: NONE
CLOSURE: NONE
MAP PAGE(S): 18-00-034-B & 18-F
APPROVED BY: TJS DATE: 2/11/13
SCALE: 1" = 800 PRIOR INSTRUMENT: DV XXXX/XXX