



RASTER

PARENT PARCEL: 07-00-031-000-049, 07-00-032-000-603 (ST)

CHILD PARCEL: 07-00-031-000-131, -132

STARTING POINT: CENTERLINE OF BARRES RD & STONEY RIDGE RD

09-02664

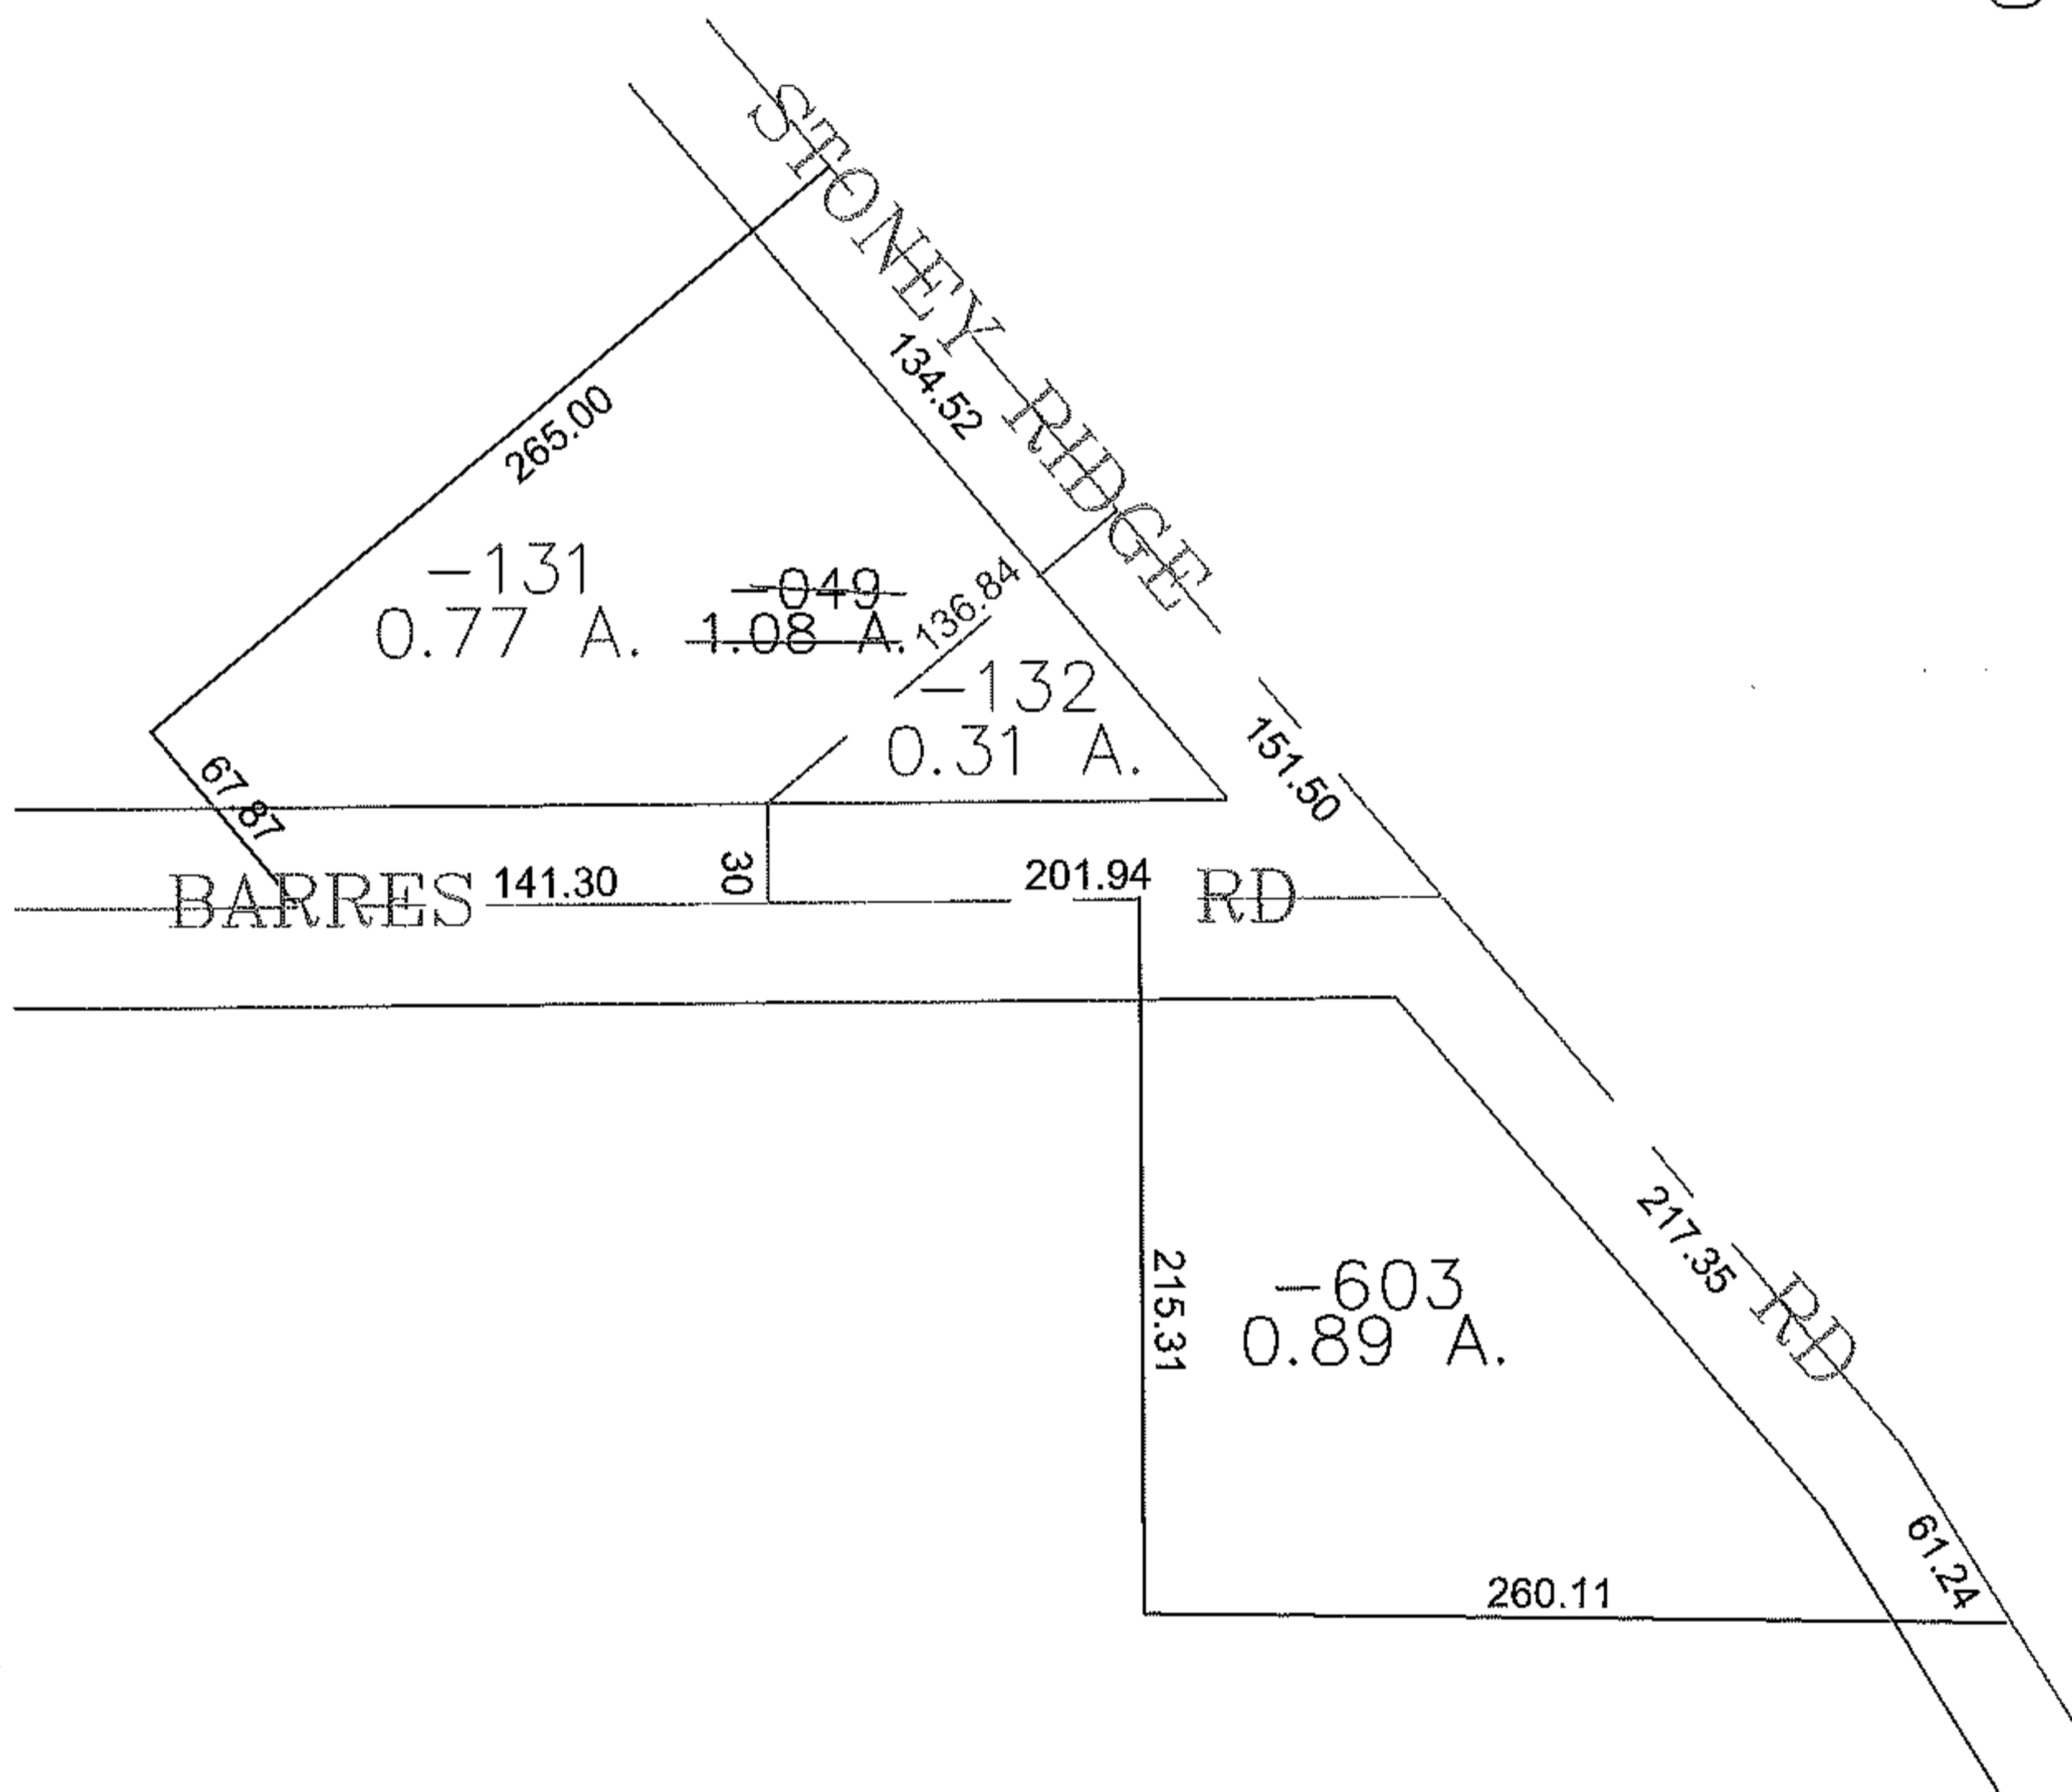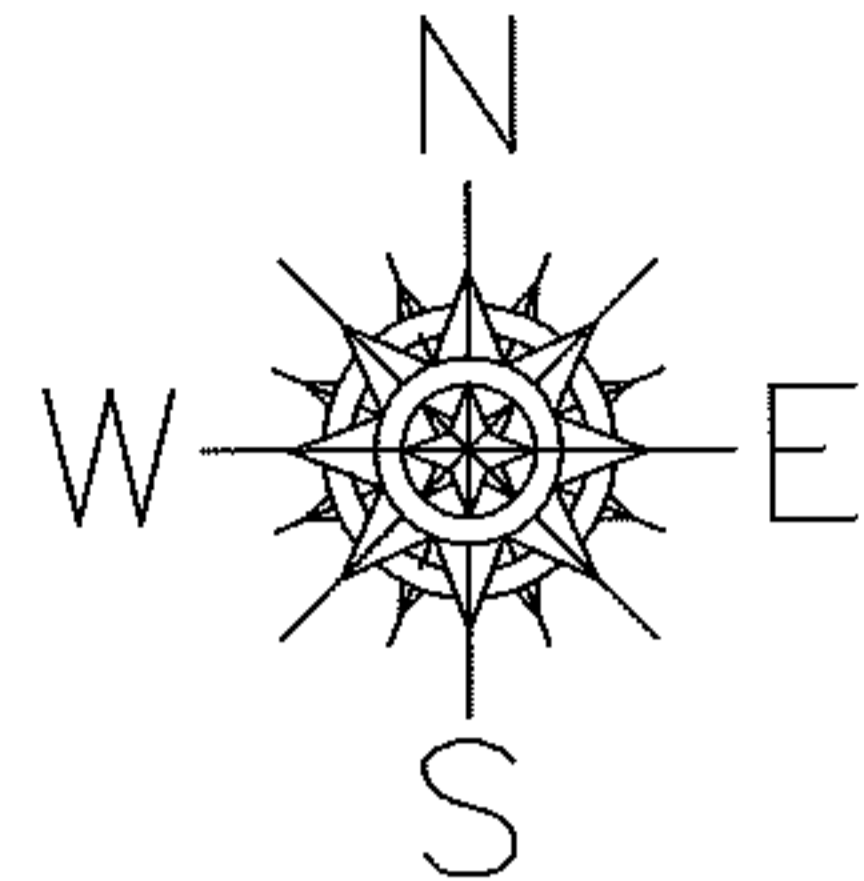

SPLITS/DEEDS PROCESSED

LORAIN COUNTY TAX MAP DEPARTMENT  
226 MIDDLE AVE. ELYRIA, OHIO

SURVEYED BY: DANE HAPONEK

CLOSURE: 0.00 : 10,000

MAP PAGE(S): 7-B

APPROVED BY: JAH DATE: 2-9-09

SCALE: 1" = 100 PRIOR INSTRUMENT: 20070225724