
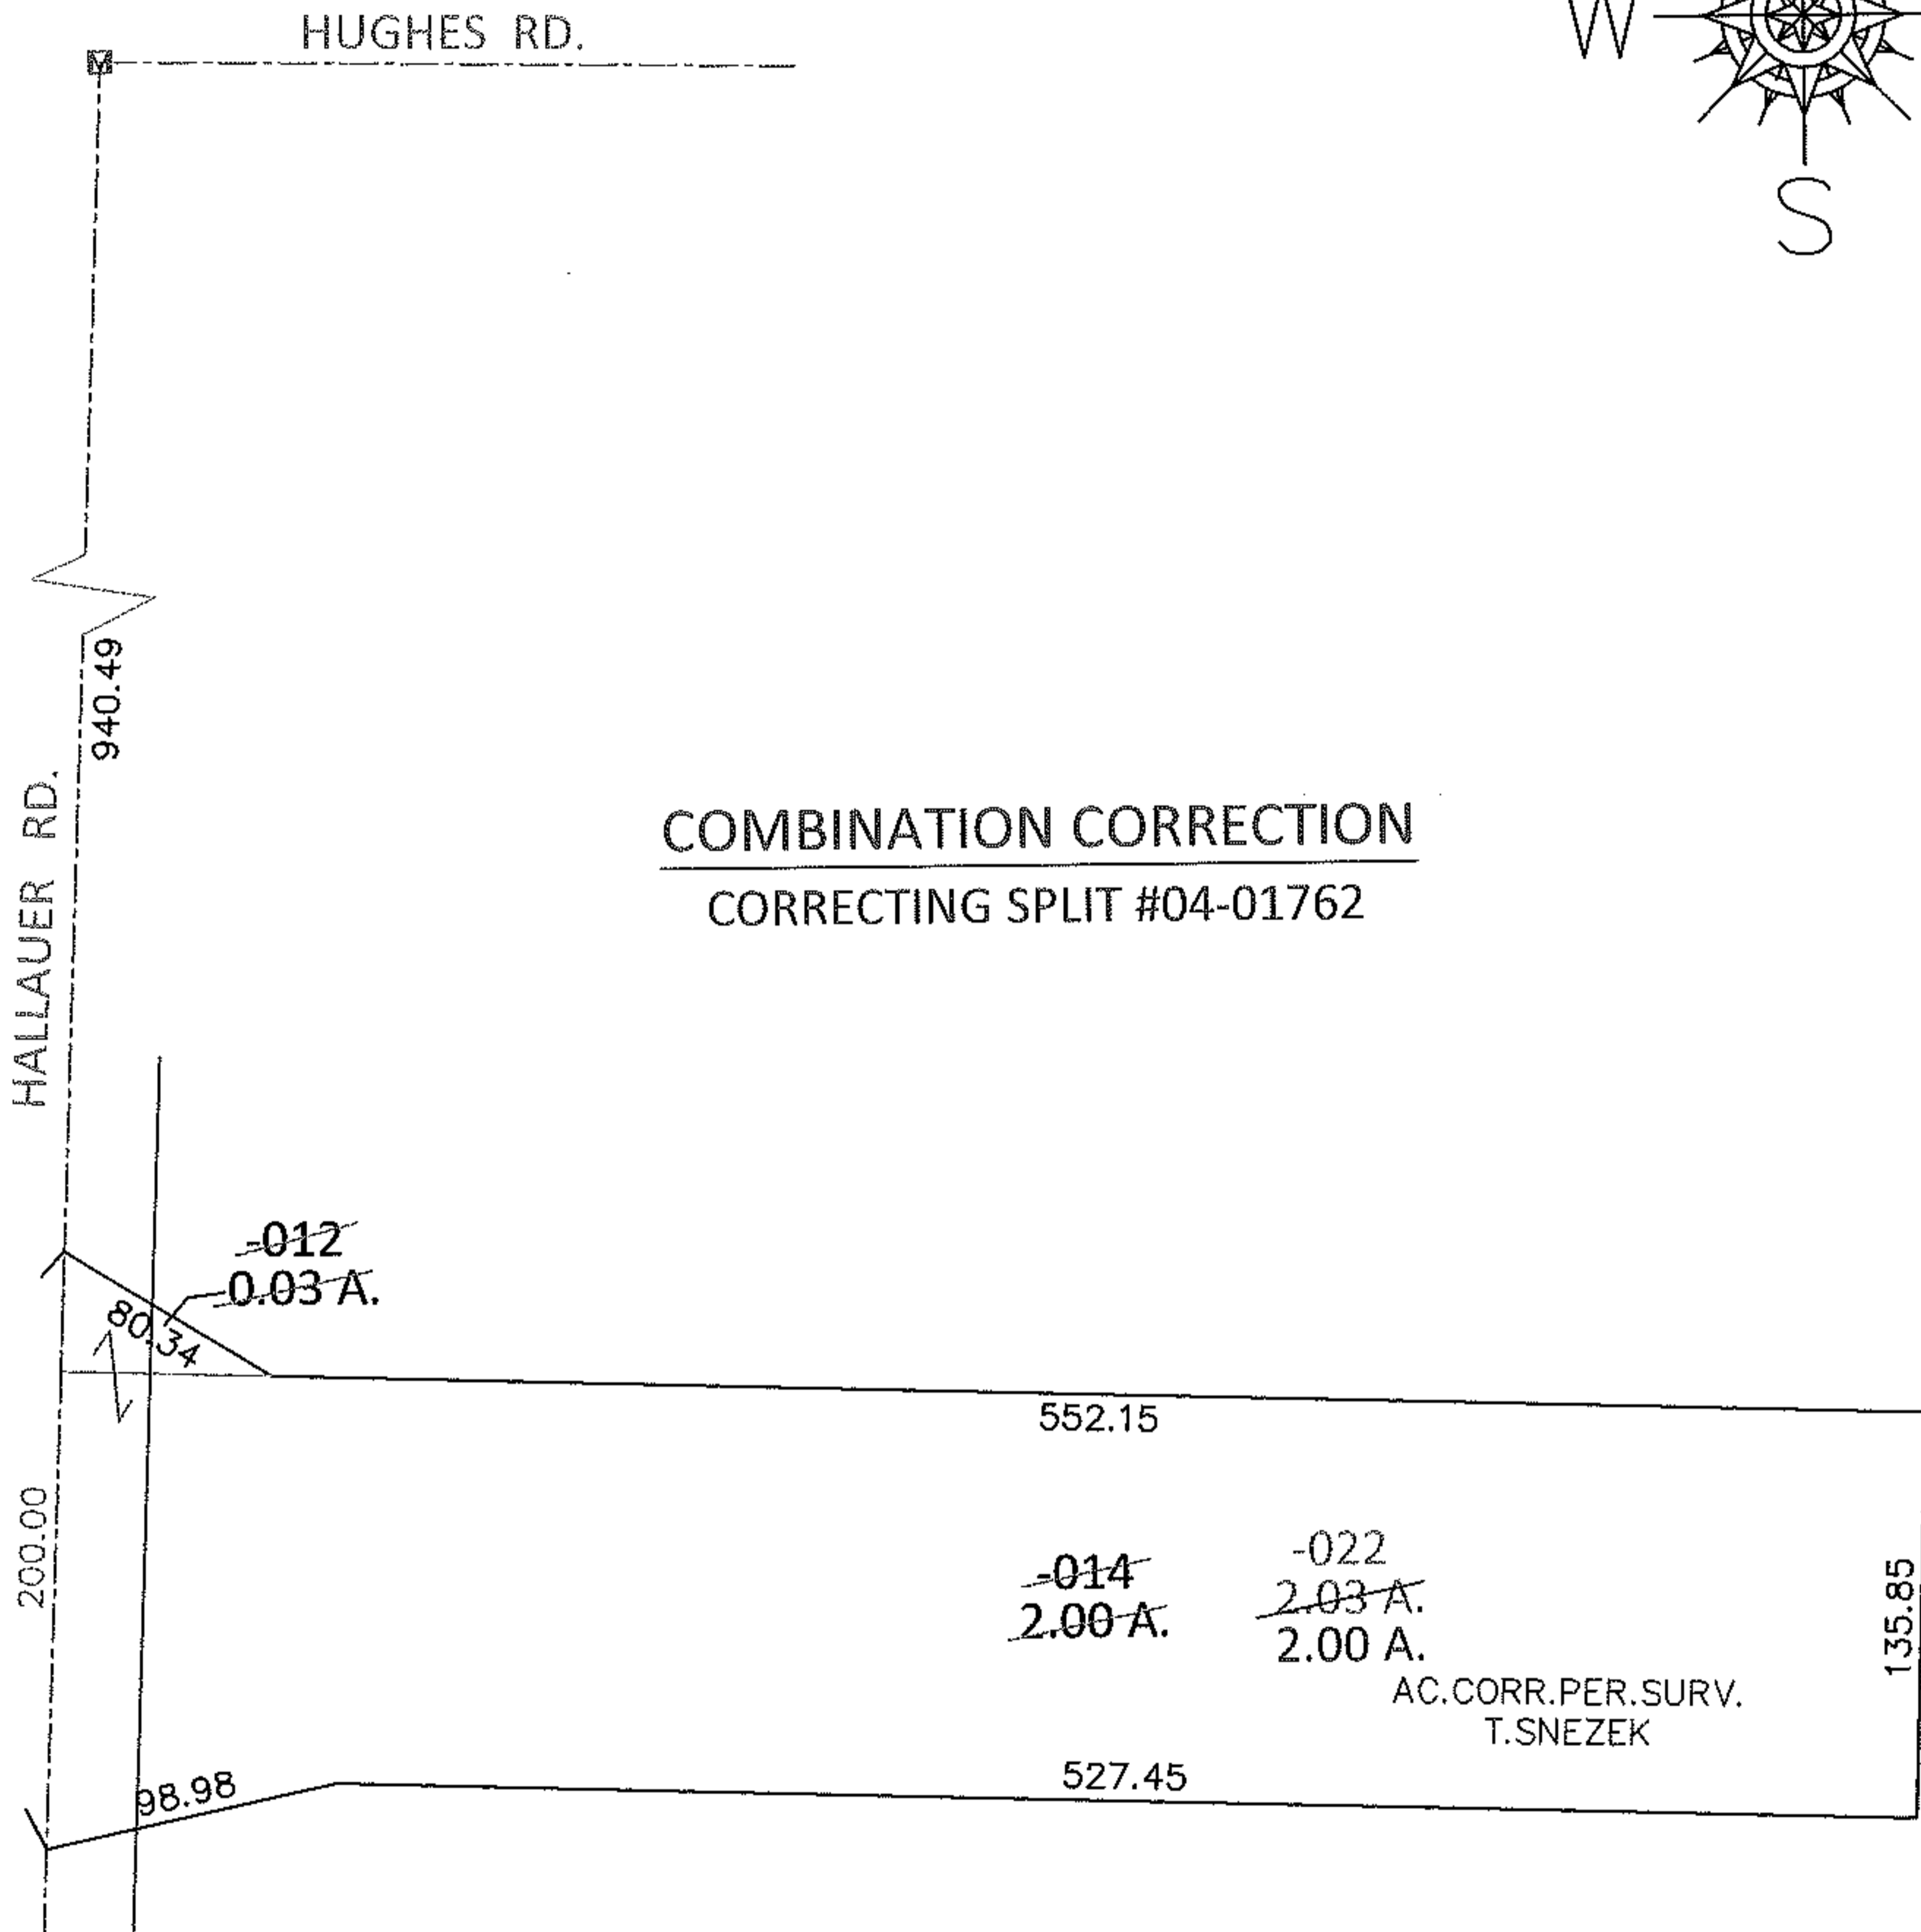


PARENT PARCEL: 14-00-057-000-012, -014

CHILD PARCEL: 14-00-057-000-022

13-02665-C

STARTING POINT: AT A MON BOX AT THE INTERSECTION OF C/L OF HUGHES RD. AND C/L OF HALLAUER RD.

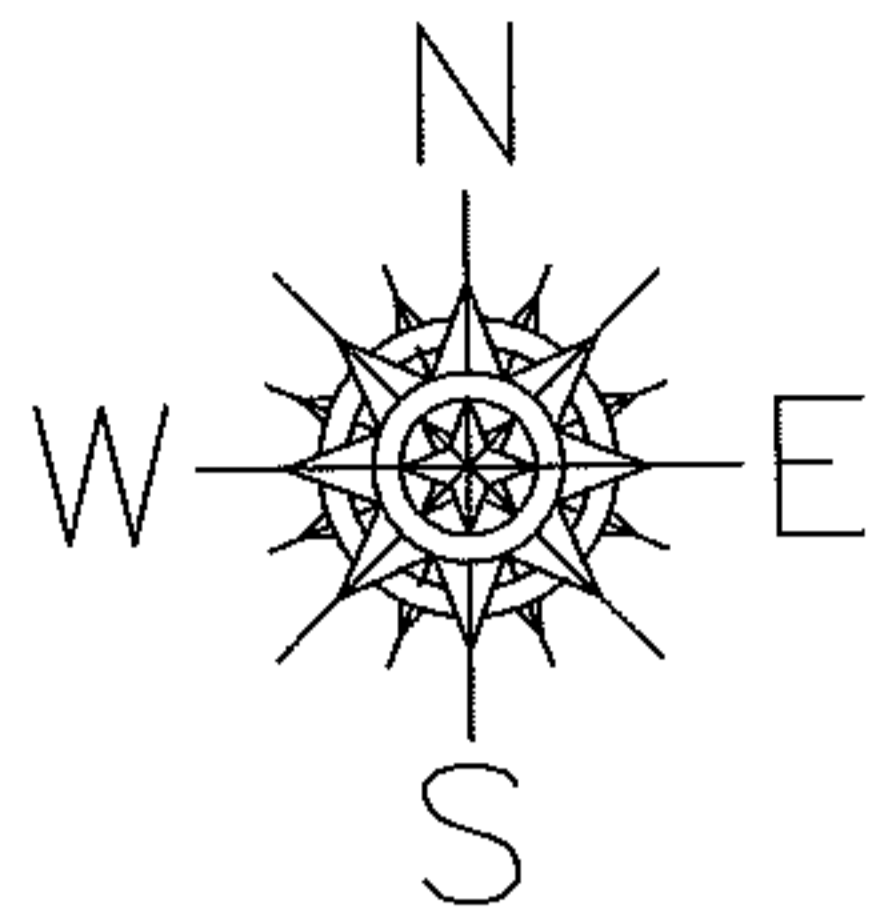

**COMBINATION CORRECTION**  
CORRECTING SPLIT #04-01762

**SPLITS/DEEDS PROCESSED**

LORAIN COUNTY TAX MAP DEPARTMENT  
226 MIDDLE AVE. ELYRIA, OHIO

SURVEYED BY: THOMAS M. SNEZEK  
CLOSURE: .01:10,000  
MAP PAGE(S): 14-C  
APPROVED BY: RRM DATE: 2-11-13  
SCALE: 1"= 100 PRIOR INST.: 20040031559

