




RASTER

PARENT PARCEL: 11-00-093-102-078, -051

CHILD PARCEL: 11-00-093-102-108

STARTING POINT: CENTERLINE OF BUTTERNUT RIDGE RD & OBERLIN CLEVELAND RD

09-02667

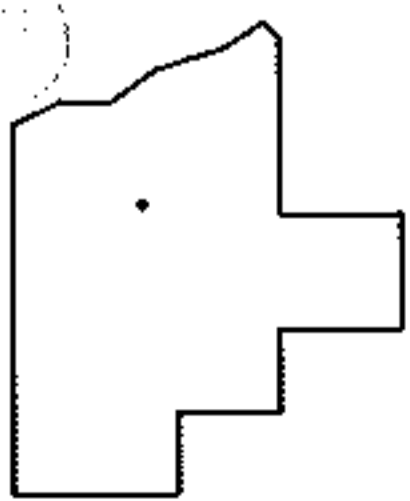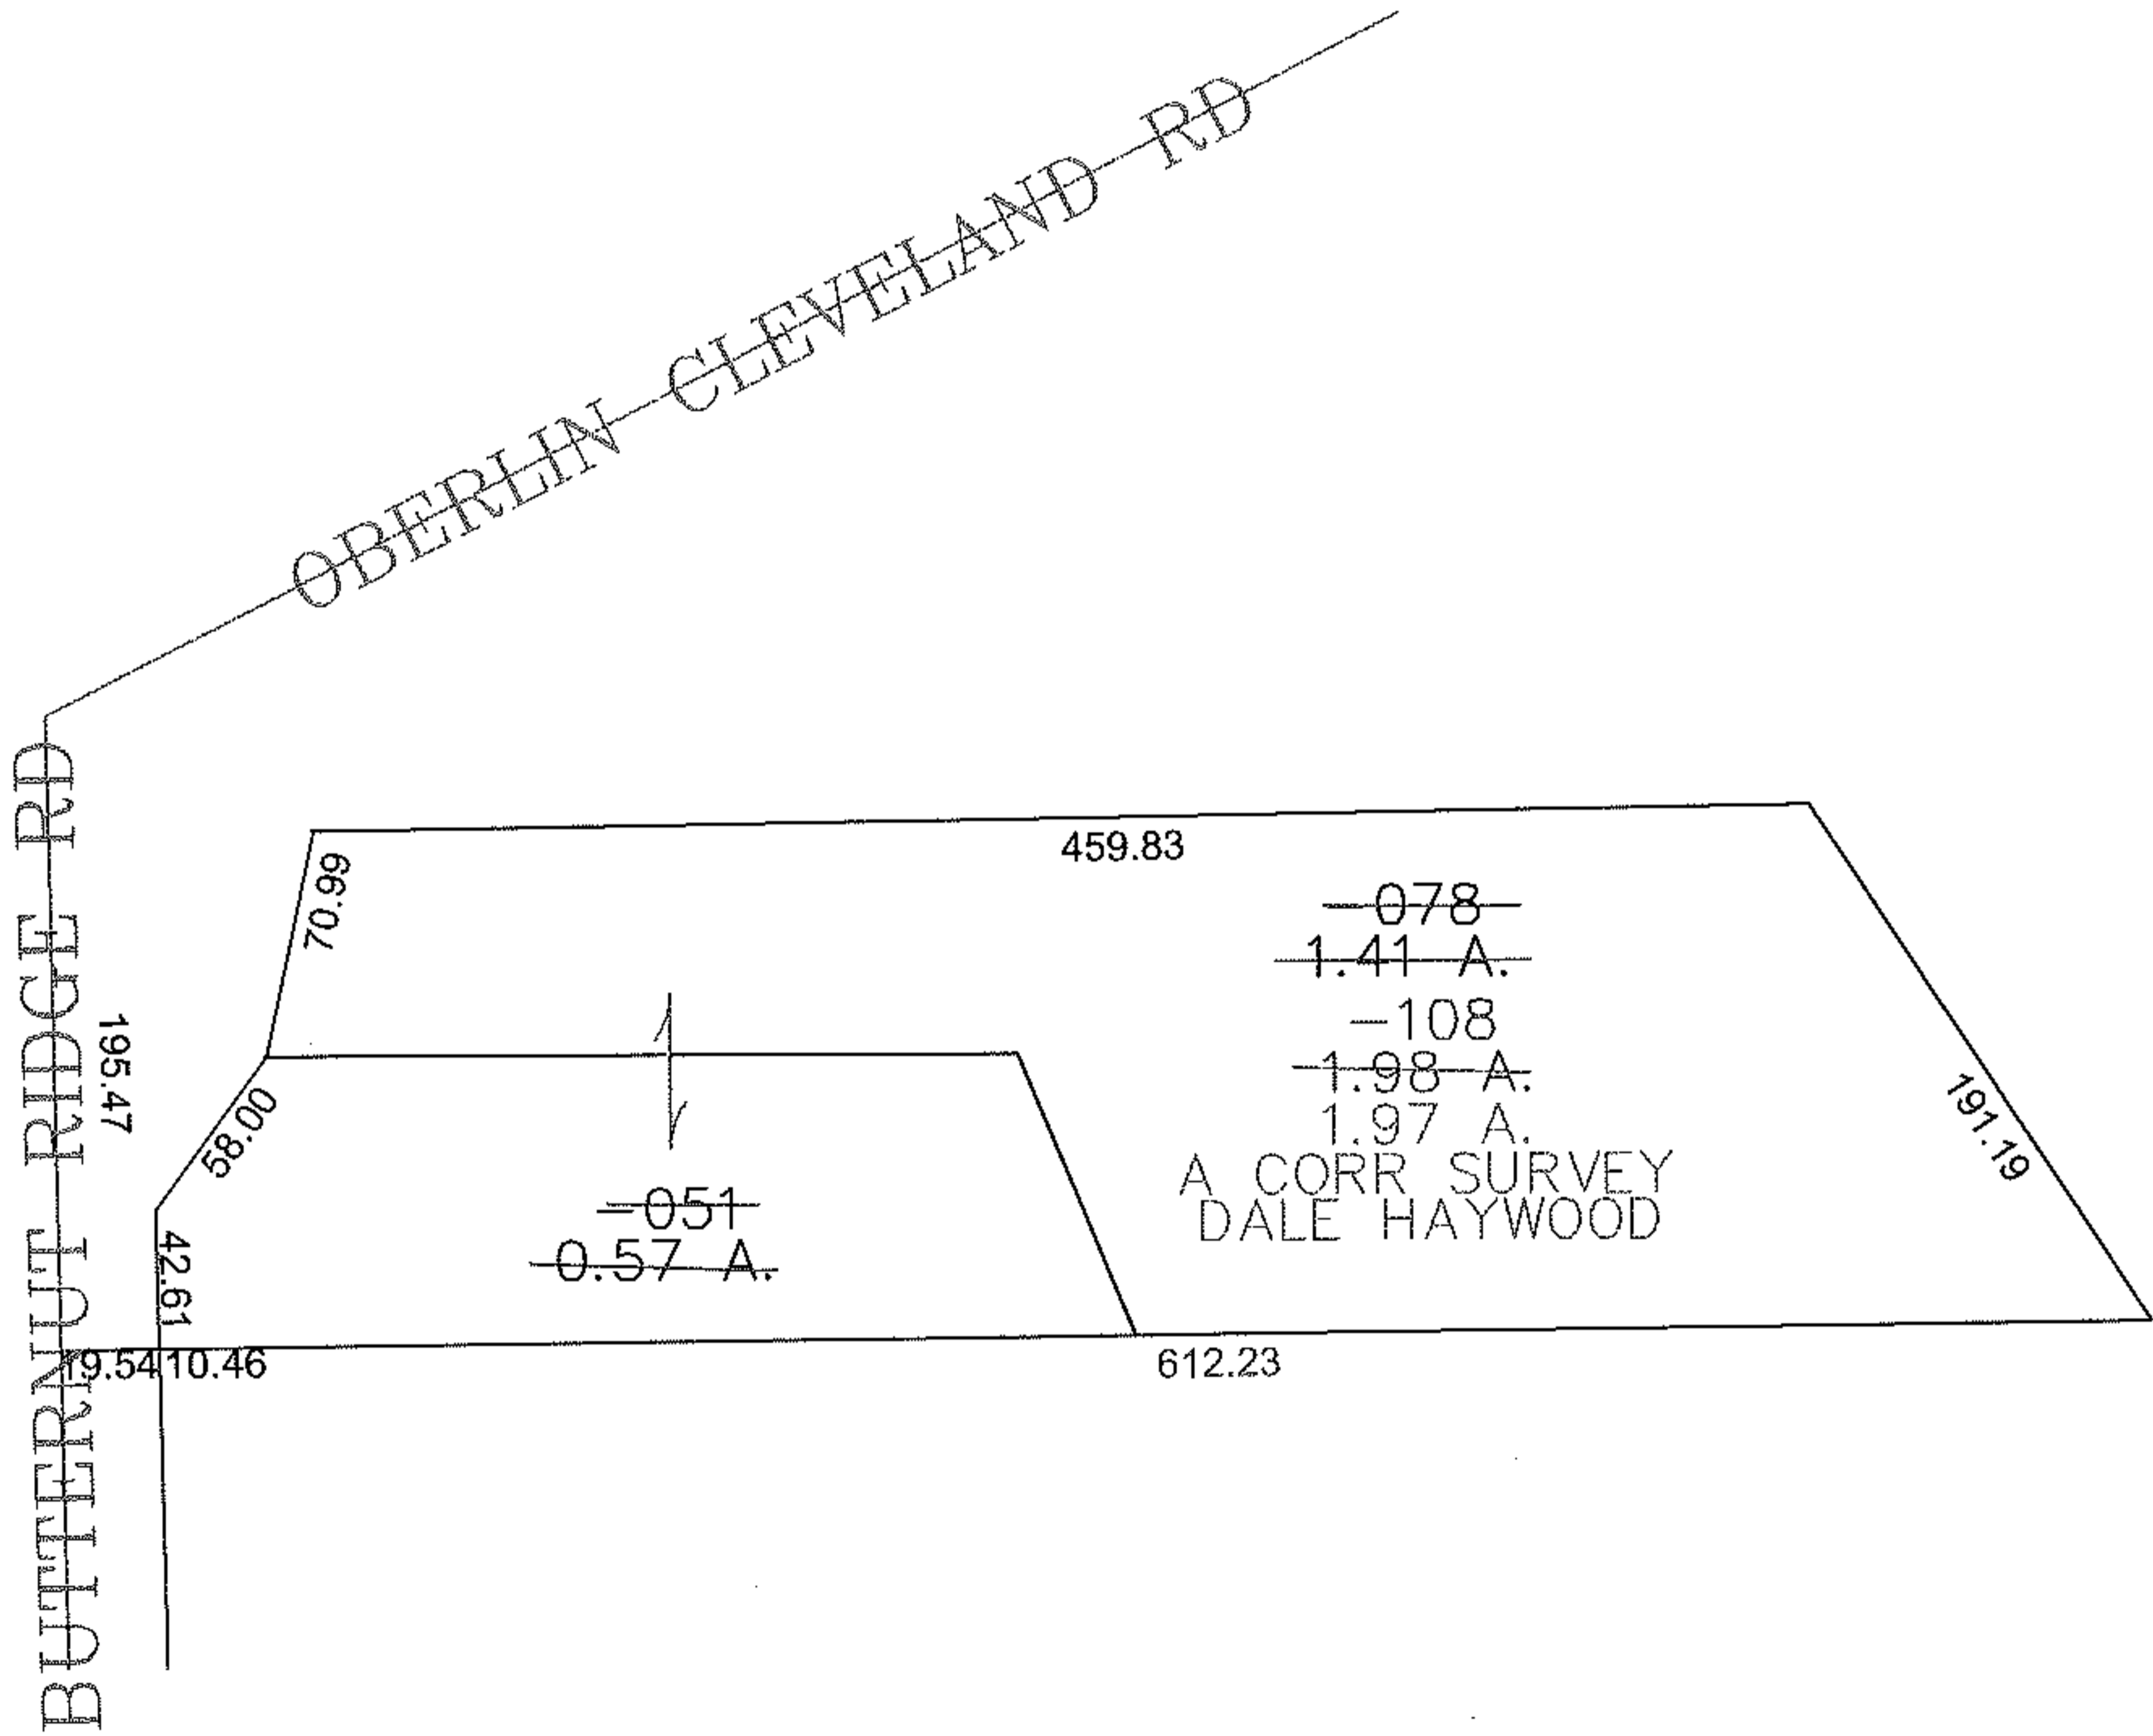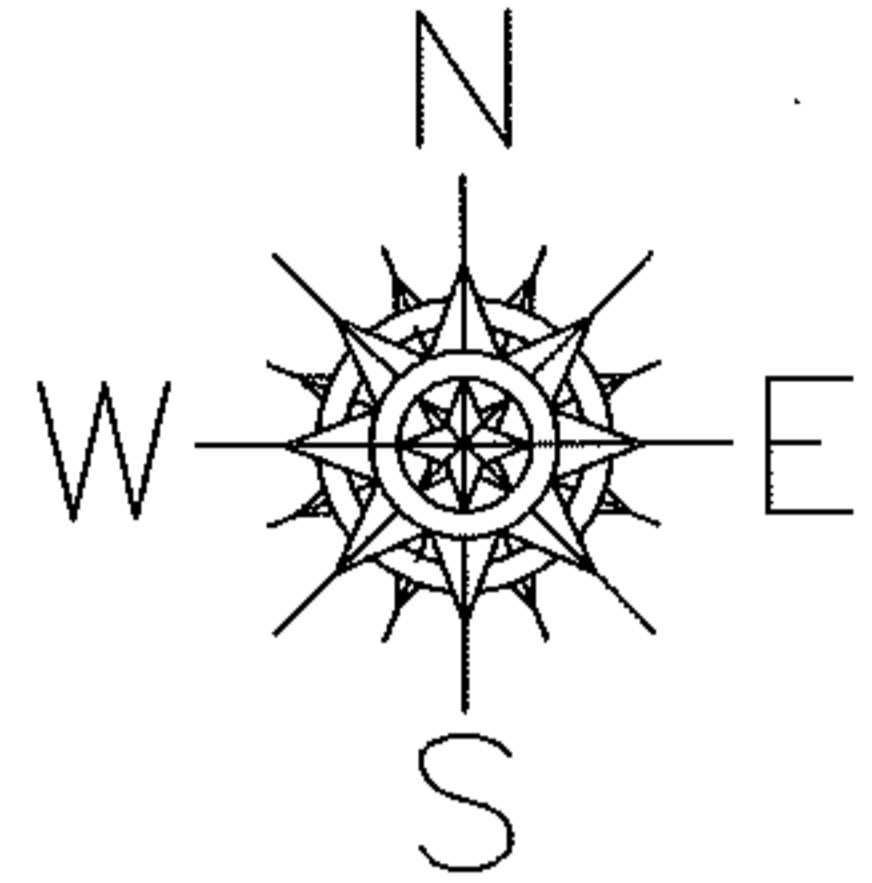

SPLITS/DEEDS PROCESSED

LORAIN COUNTY TAX MAP DEPARTMENT
226 MIDDLE AVE. ELYRIA, OHIO

SURVEYED BY: DALE HAYWOOD

CLOSURE: 0.00 : 10.000

MAP PAGE(S): 11-00-093-A

APPROVED BY: JAH DATE: 2-25-09

SCALE: 1" = 100 PRIOR INSTRUMENT: 20080262219