


PARENT PARCEL: 06-25-002-102-078, 06-25-006-132-009

CHILD PARCEL: \_\_\_\_\_



13-02668-A

STARTING POINT: NORTHEAST CORNER OF S/L 39 IN PARKWOOD ESTATES NO.2 (VOL.25 PG.68)

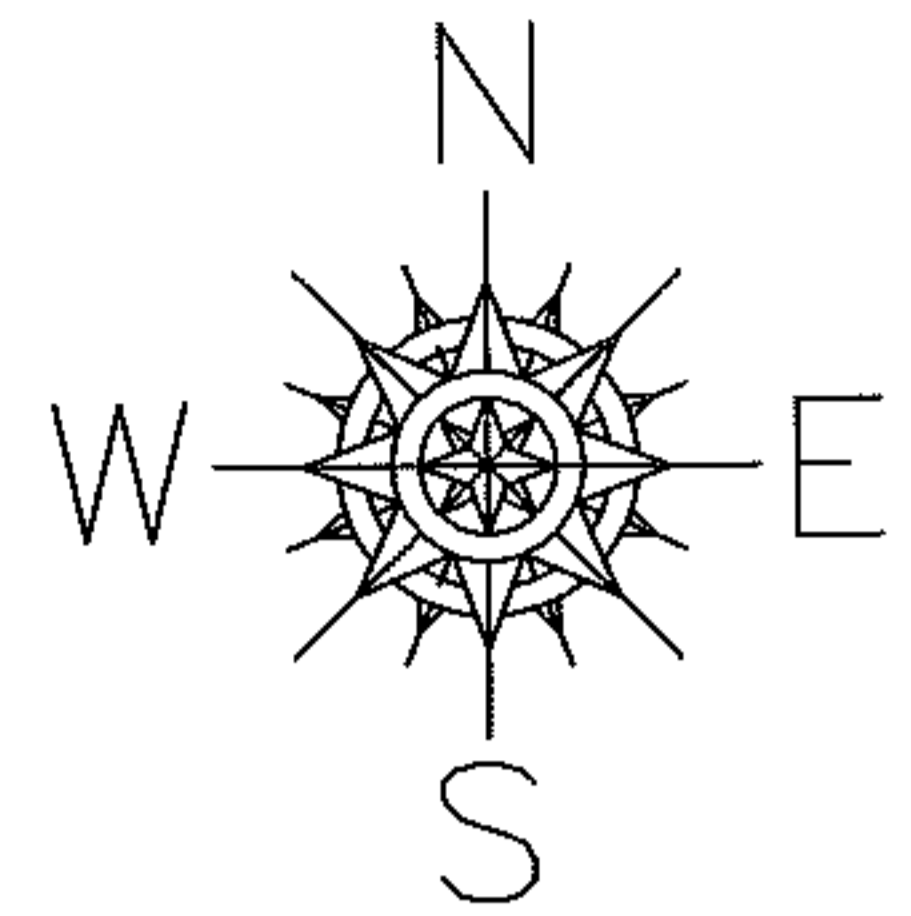

STANFORD AVE.

LONGSON AVE.  
VAC. ORD. 72-93

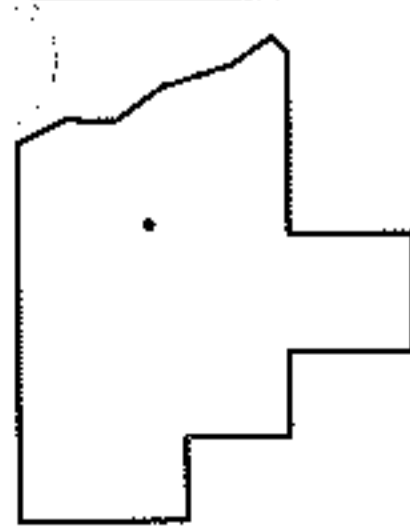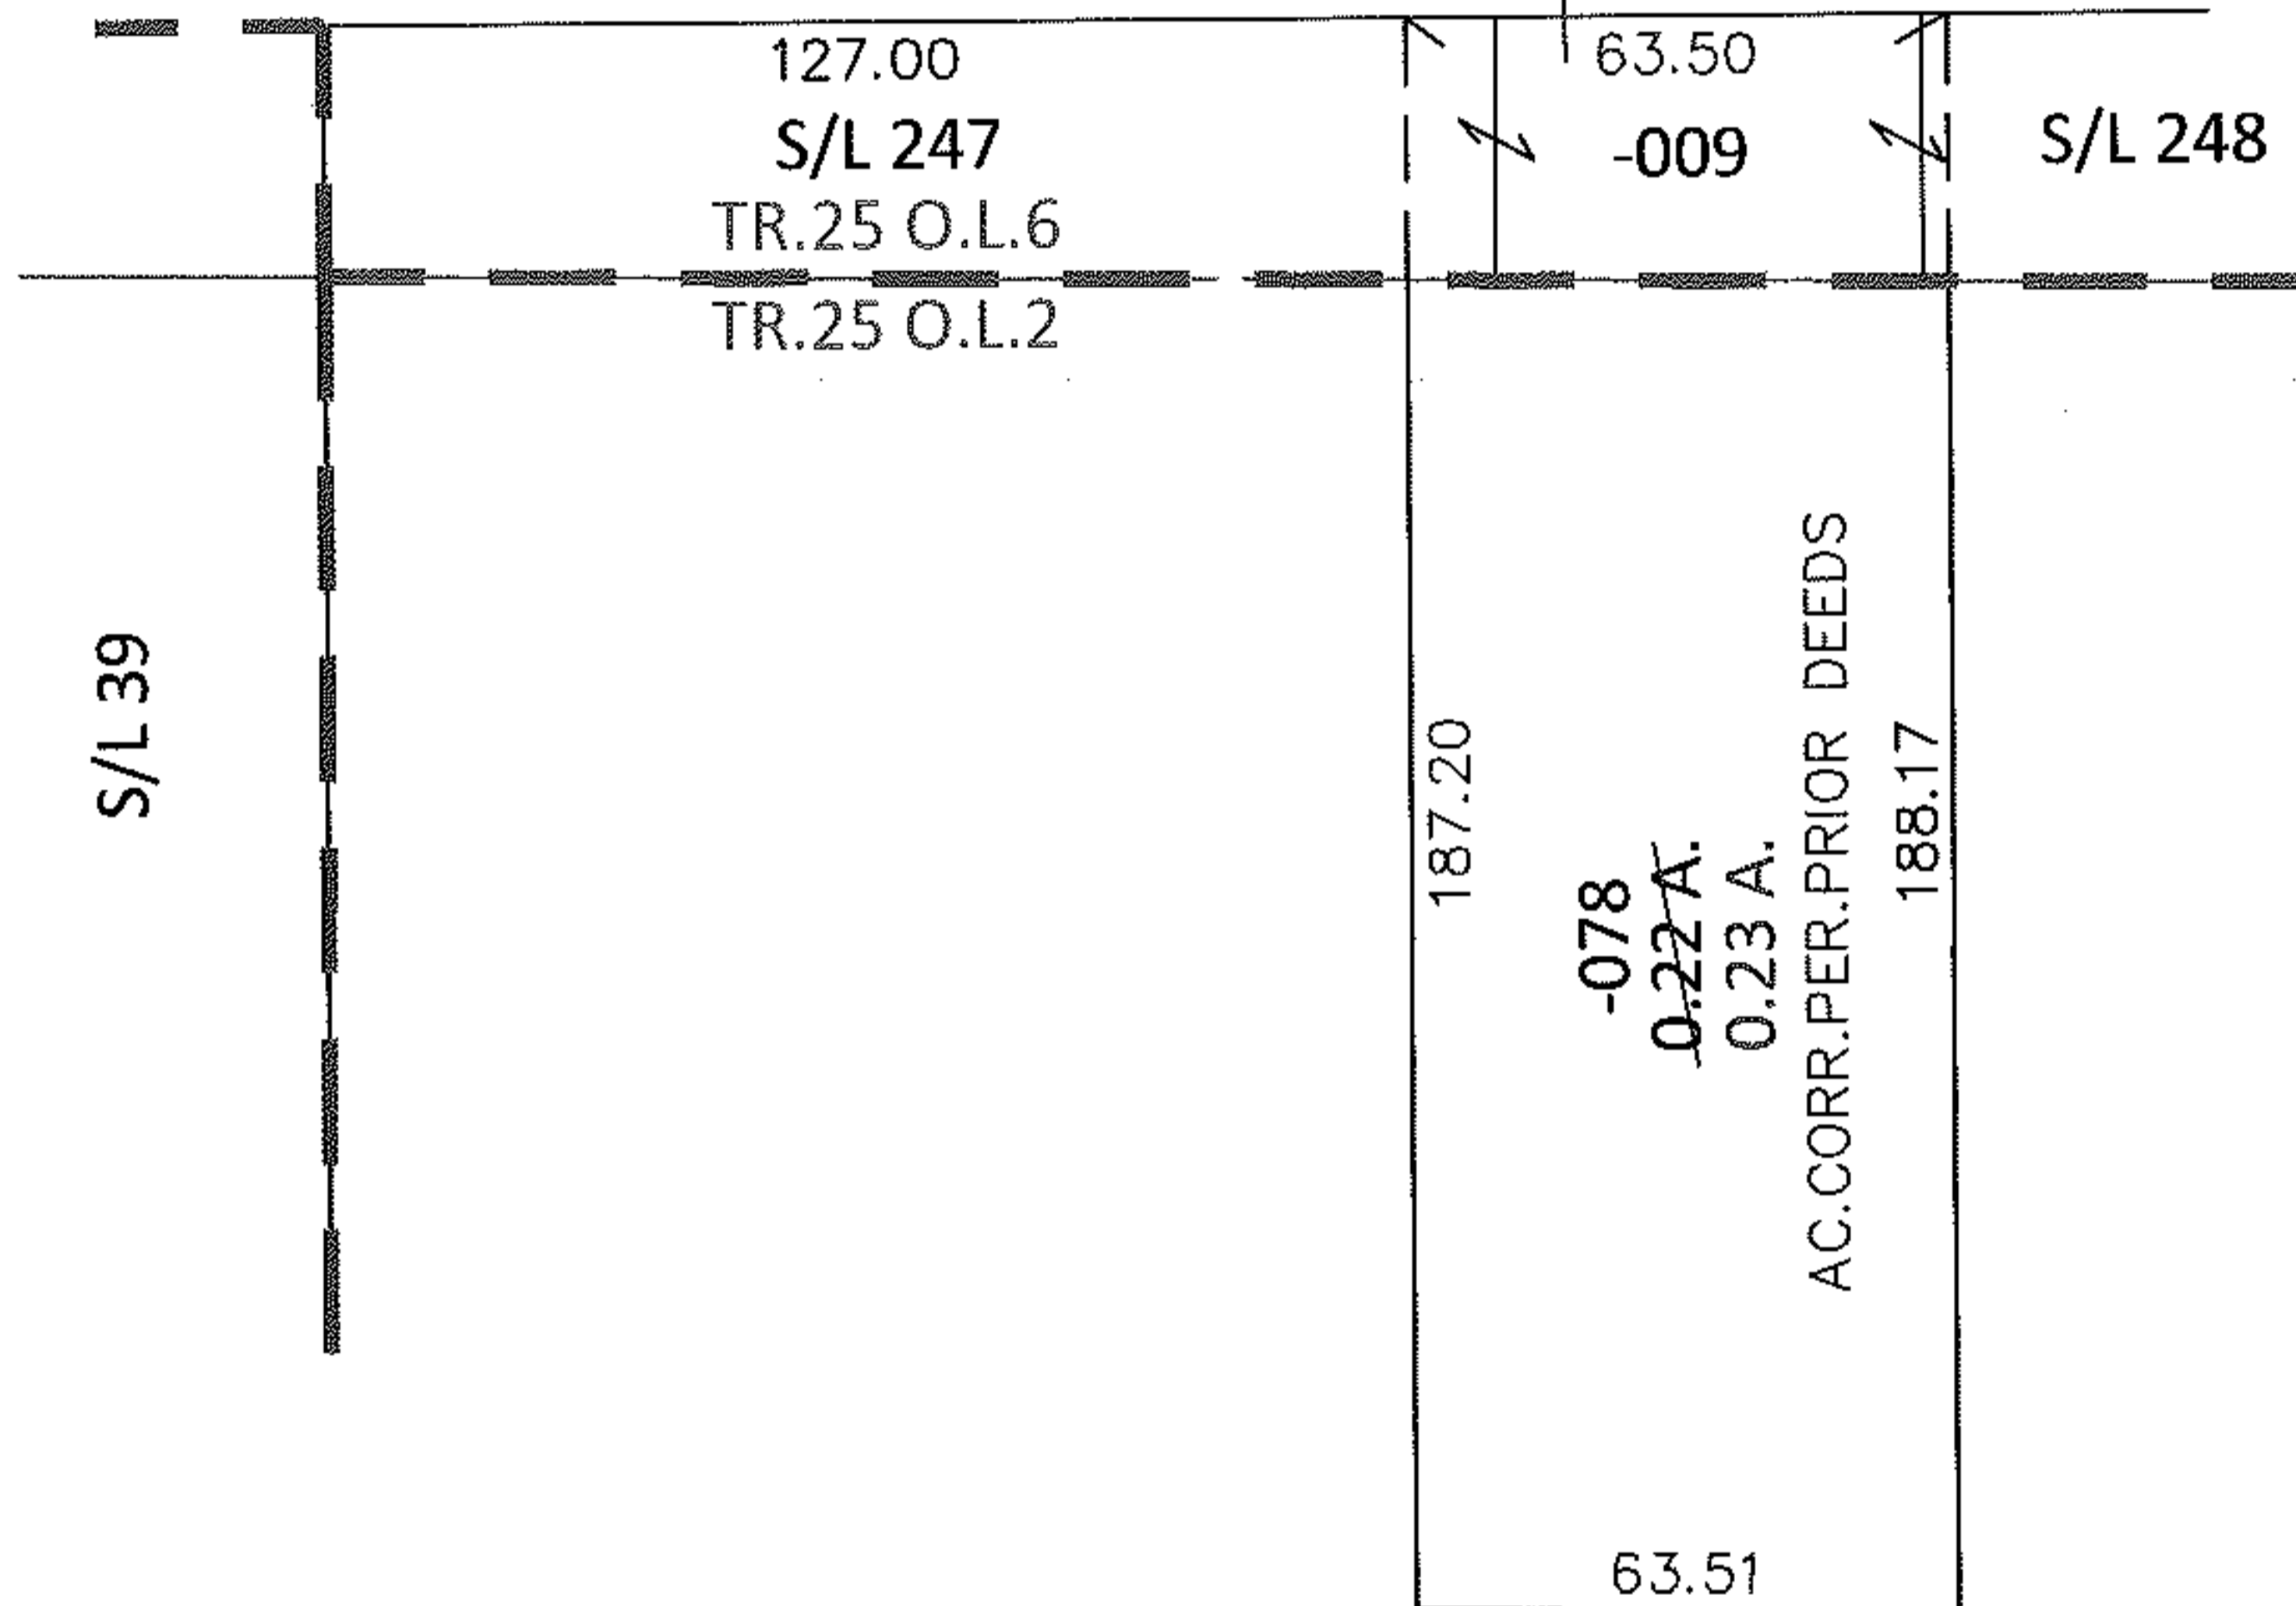

SPLITS/DEEDS PROCESSED

LORAIN COUNTY TAX MAP DEPARTMENT  
226 MIDDLE AVE. ELYRIA, OHIO

SURVEYED BY: N/A

CLOSURE: .01:10,000

MAP PAGE(S): 6-142

APPROVED BY: RRM DATE: 3-13-13

SCALE: 1"= 50' PRIOR INST.: 20090313964