



RASTER

PARENT PARCEL: 02-01-008-101-360

CHILD PARCEL: 02-01-008-101-383, 384

STARTING POINT: CENTERLINE OF NORTH RDIGE RD & OBERLIN AVE

09-02670

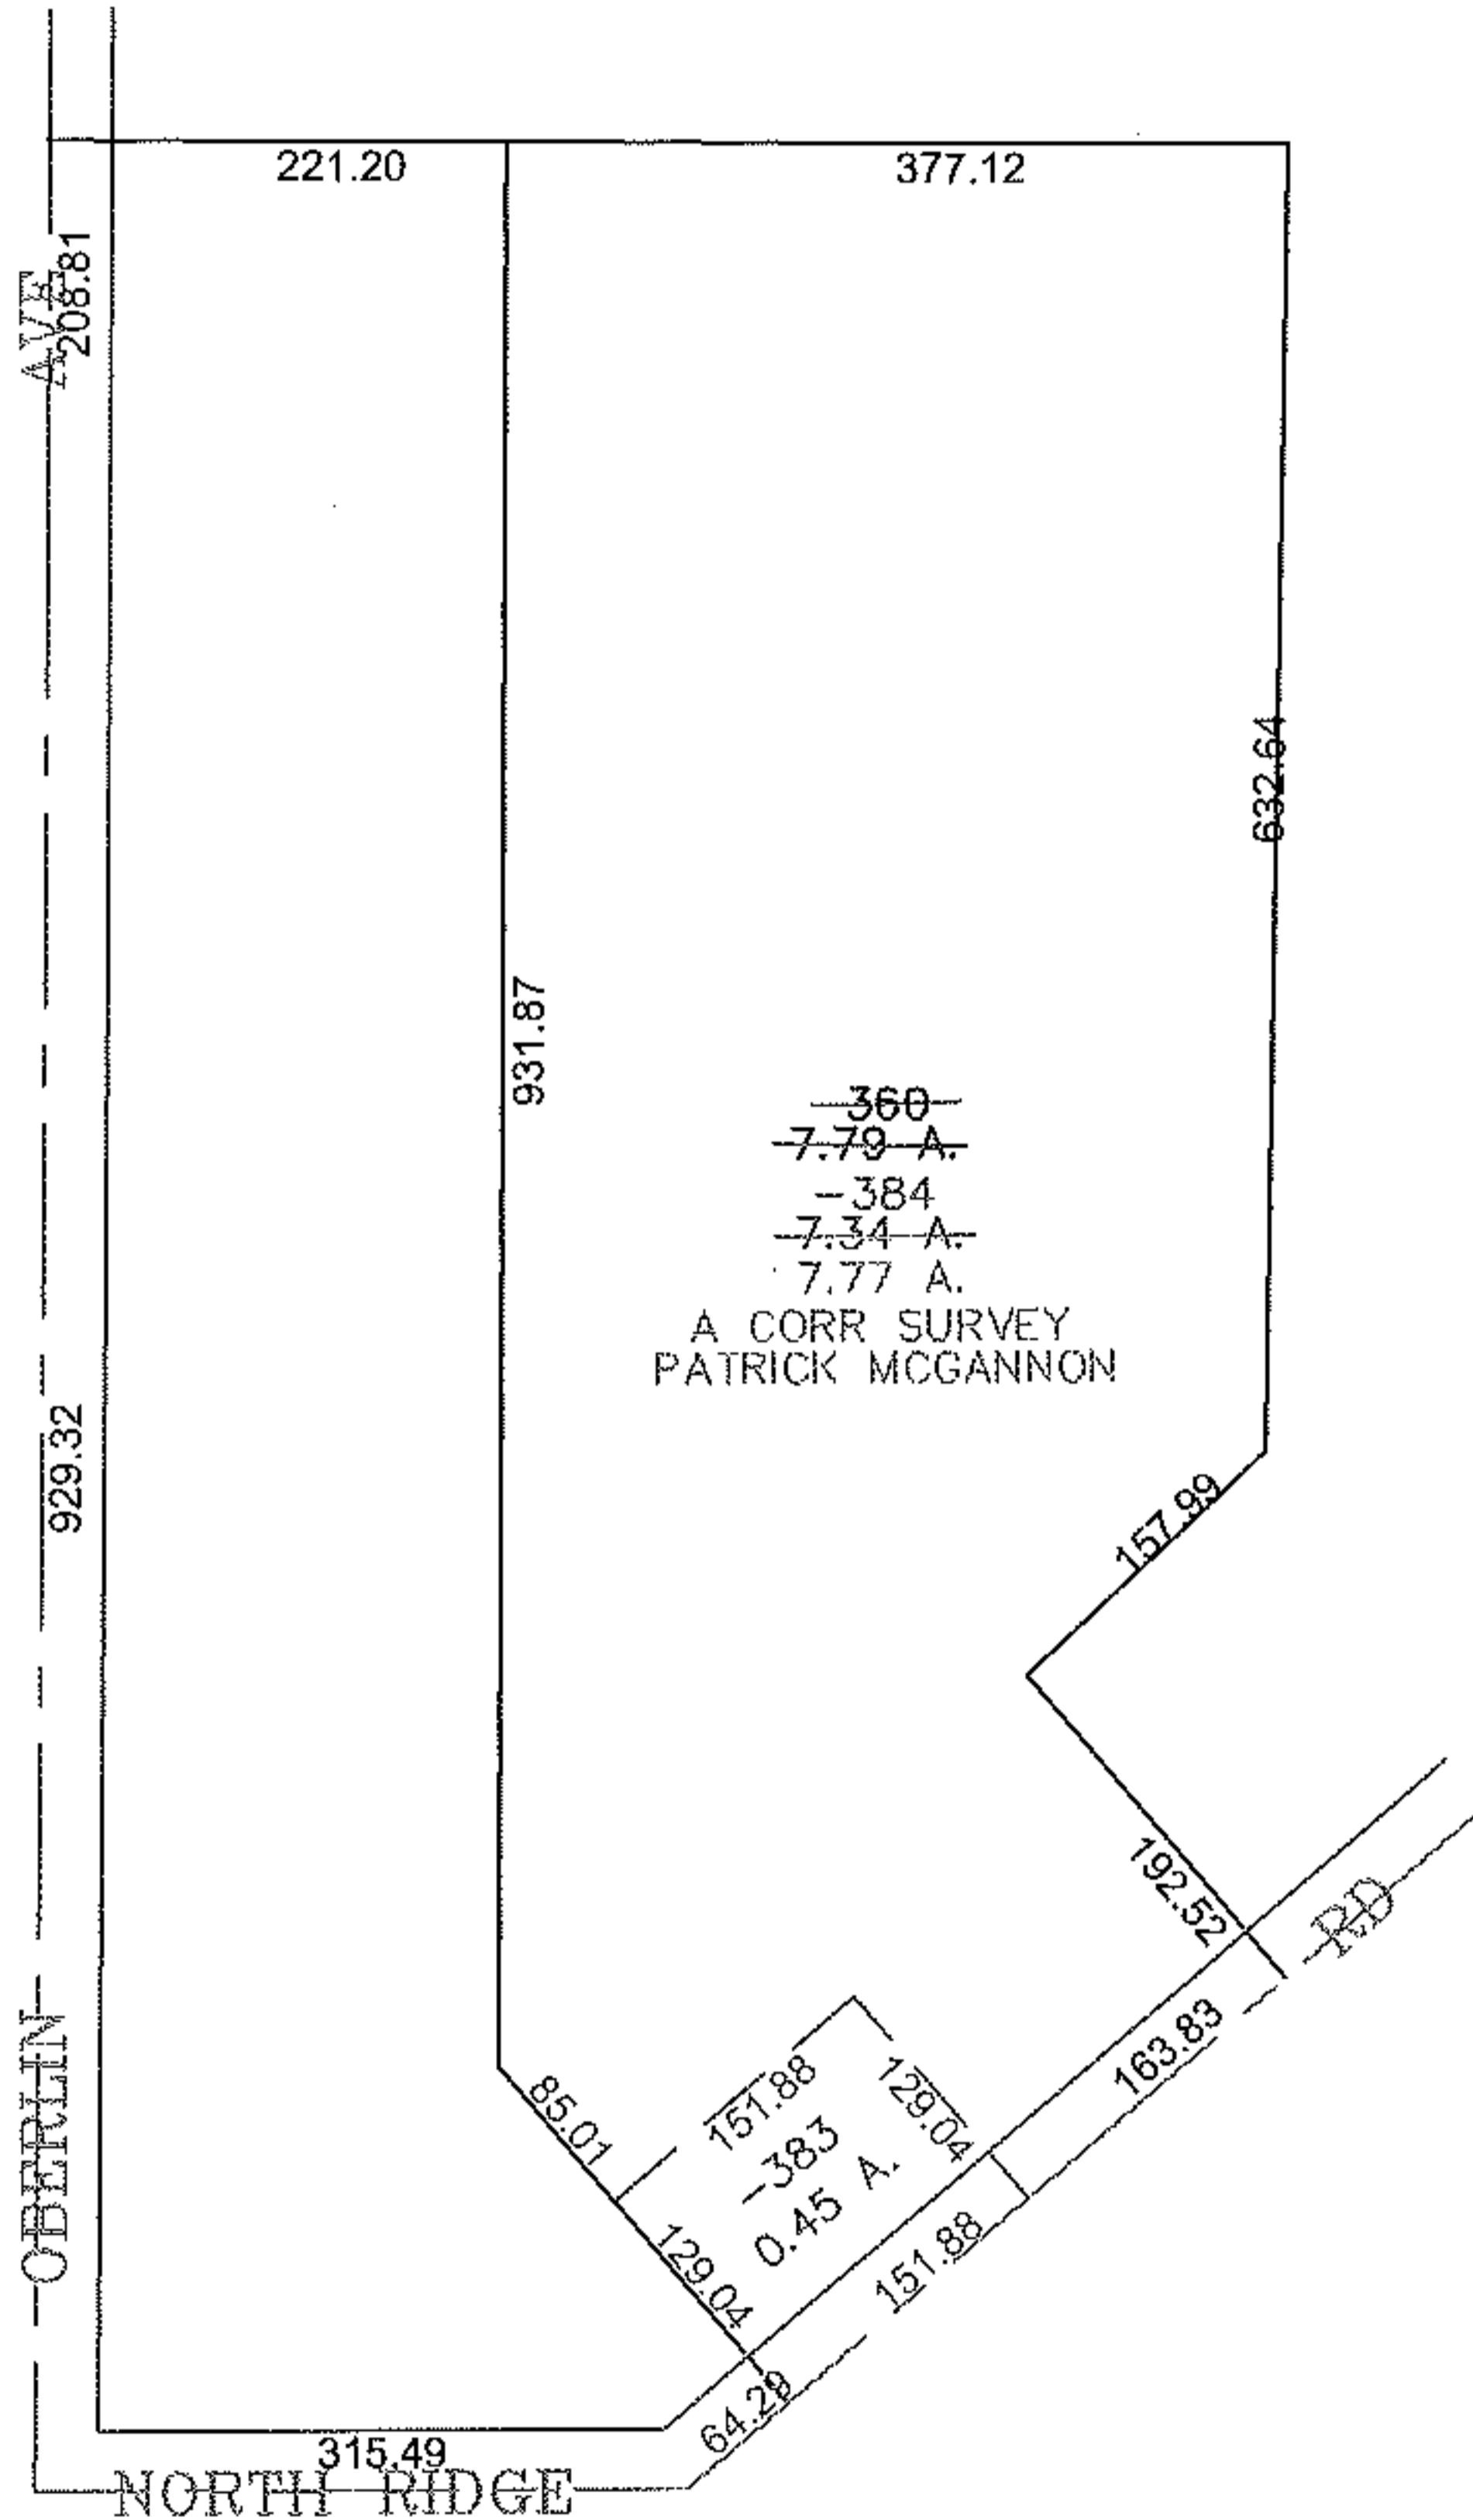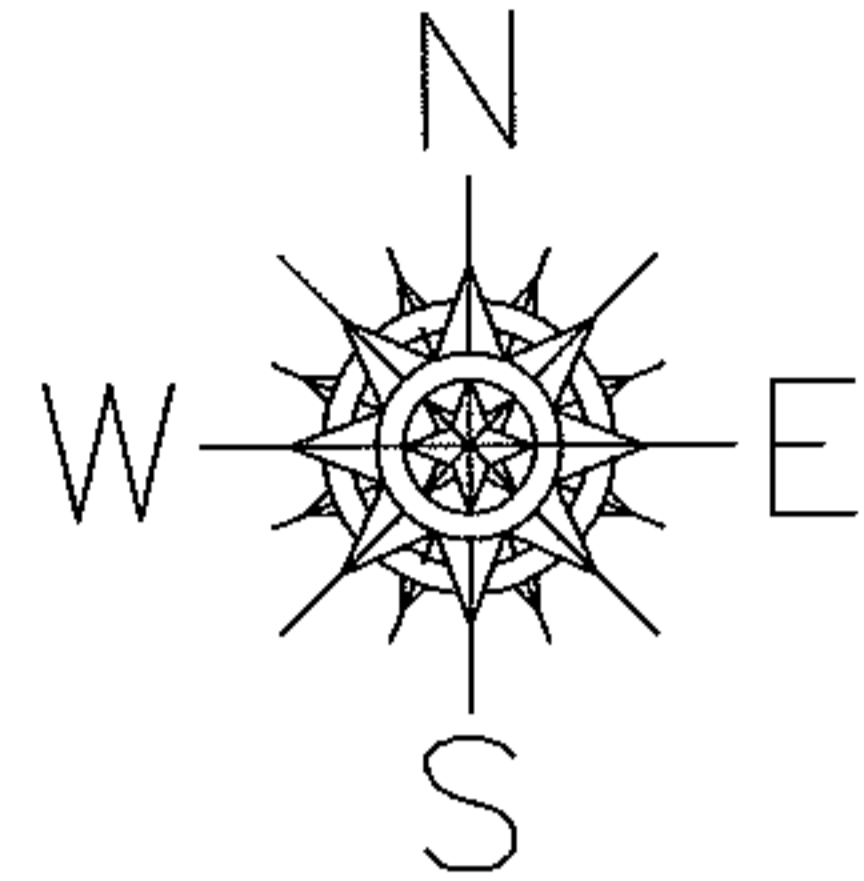

~~360~~
~~7.79 A.~~
~~384~~
~~7.34 A.~~
 7.77 A.
 A CORR SURVEY
 PATRICK MCGANNON

SPLITS/DEEDS PROCESSED

LORAIN COUNTY TAX MAP DEPARTMENT
 226 MIDDLE AVE. ELYRIA, OHIO

SURVEYED BY: PATRICK MCGANNON

CLOSURE: 0.00 : 10.000

MAP PAGE(S): 02-01-008-B

APPROVED BY: JAH DATE: 2-26-09

SCALE: 1" = 200 PRIOR INSTRUMENT: 20080257457