


PARENT PARCEL: 04-00-014-107-007

CHILD PARCEL: _____

13-02671-D

STARTING POINT: INTERSECTION OF C/L OF WEST PARK RD. AND C/L OF CENTER RD.

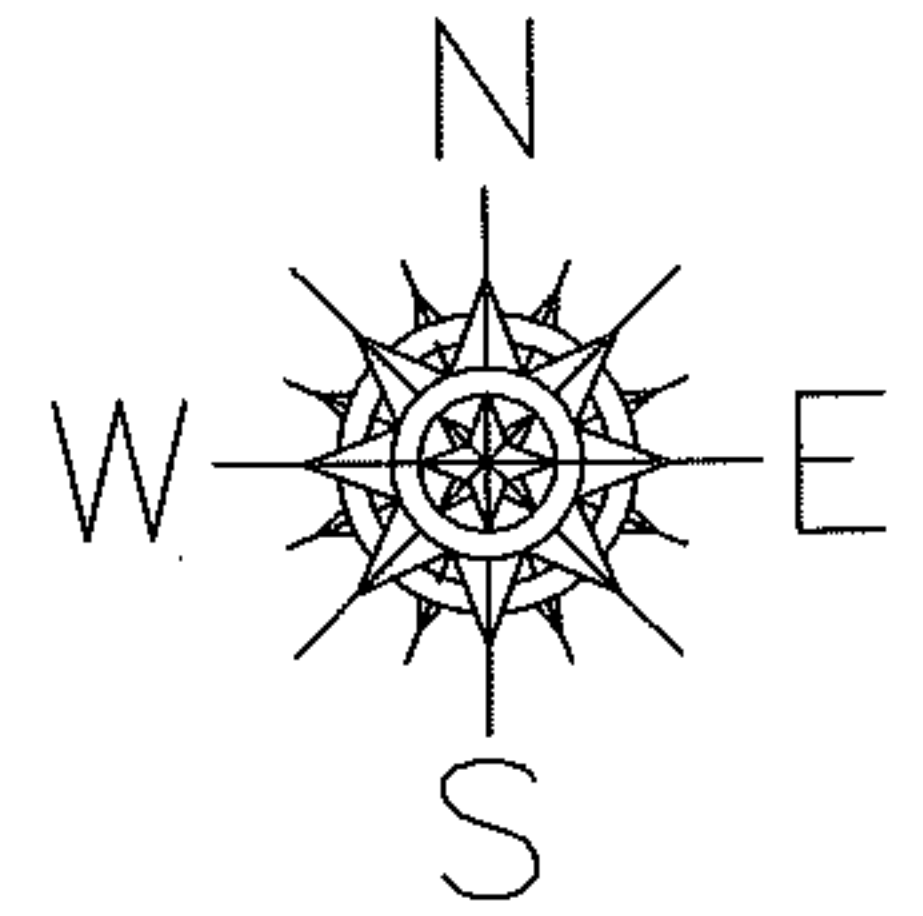

WEST PARK RD.

MAP CORRECTION ONLY

S/L 11

572.65
CENTER RD.

170.05
~~168.04~~

657.23


-007
2.24 A.

642.66

90.00

49.361

C/L OF
FRENCH CREEK

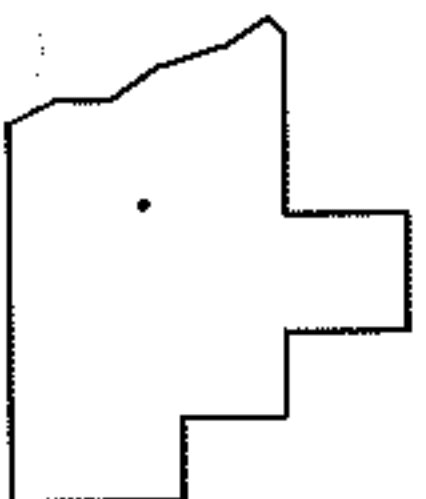

SPLITS/DEEDS PROCESSED

LORAIN COUNTY TAX MAP DEPARTMENT
226 MIDDLE AVE. ELYRIA, OHIO

SURVEYED BY: DALE R. HAYWOOD

CLOSURE: .01:10,000

MAP PAGE(S): 4-00-014-C

APPROVED BY: RRM DATE: 2-20-13

SCALE: 1"= 100 PRIOR INST.: 20110385751