


PASTER

PARENT PARCEL: 12-00-015-000-013

CHILD PARCEL: 12-00-015-000-083, -084

STARTING POINT: CENTERLINE OF ROYALTON RD & MARKS RD

09-02671

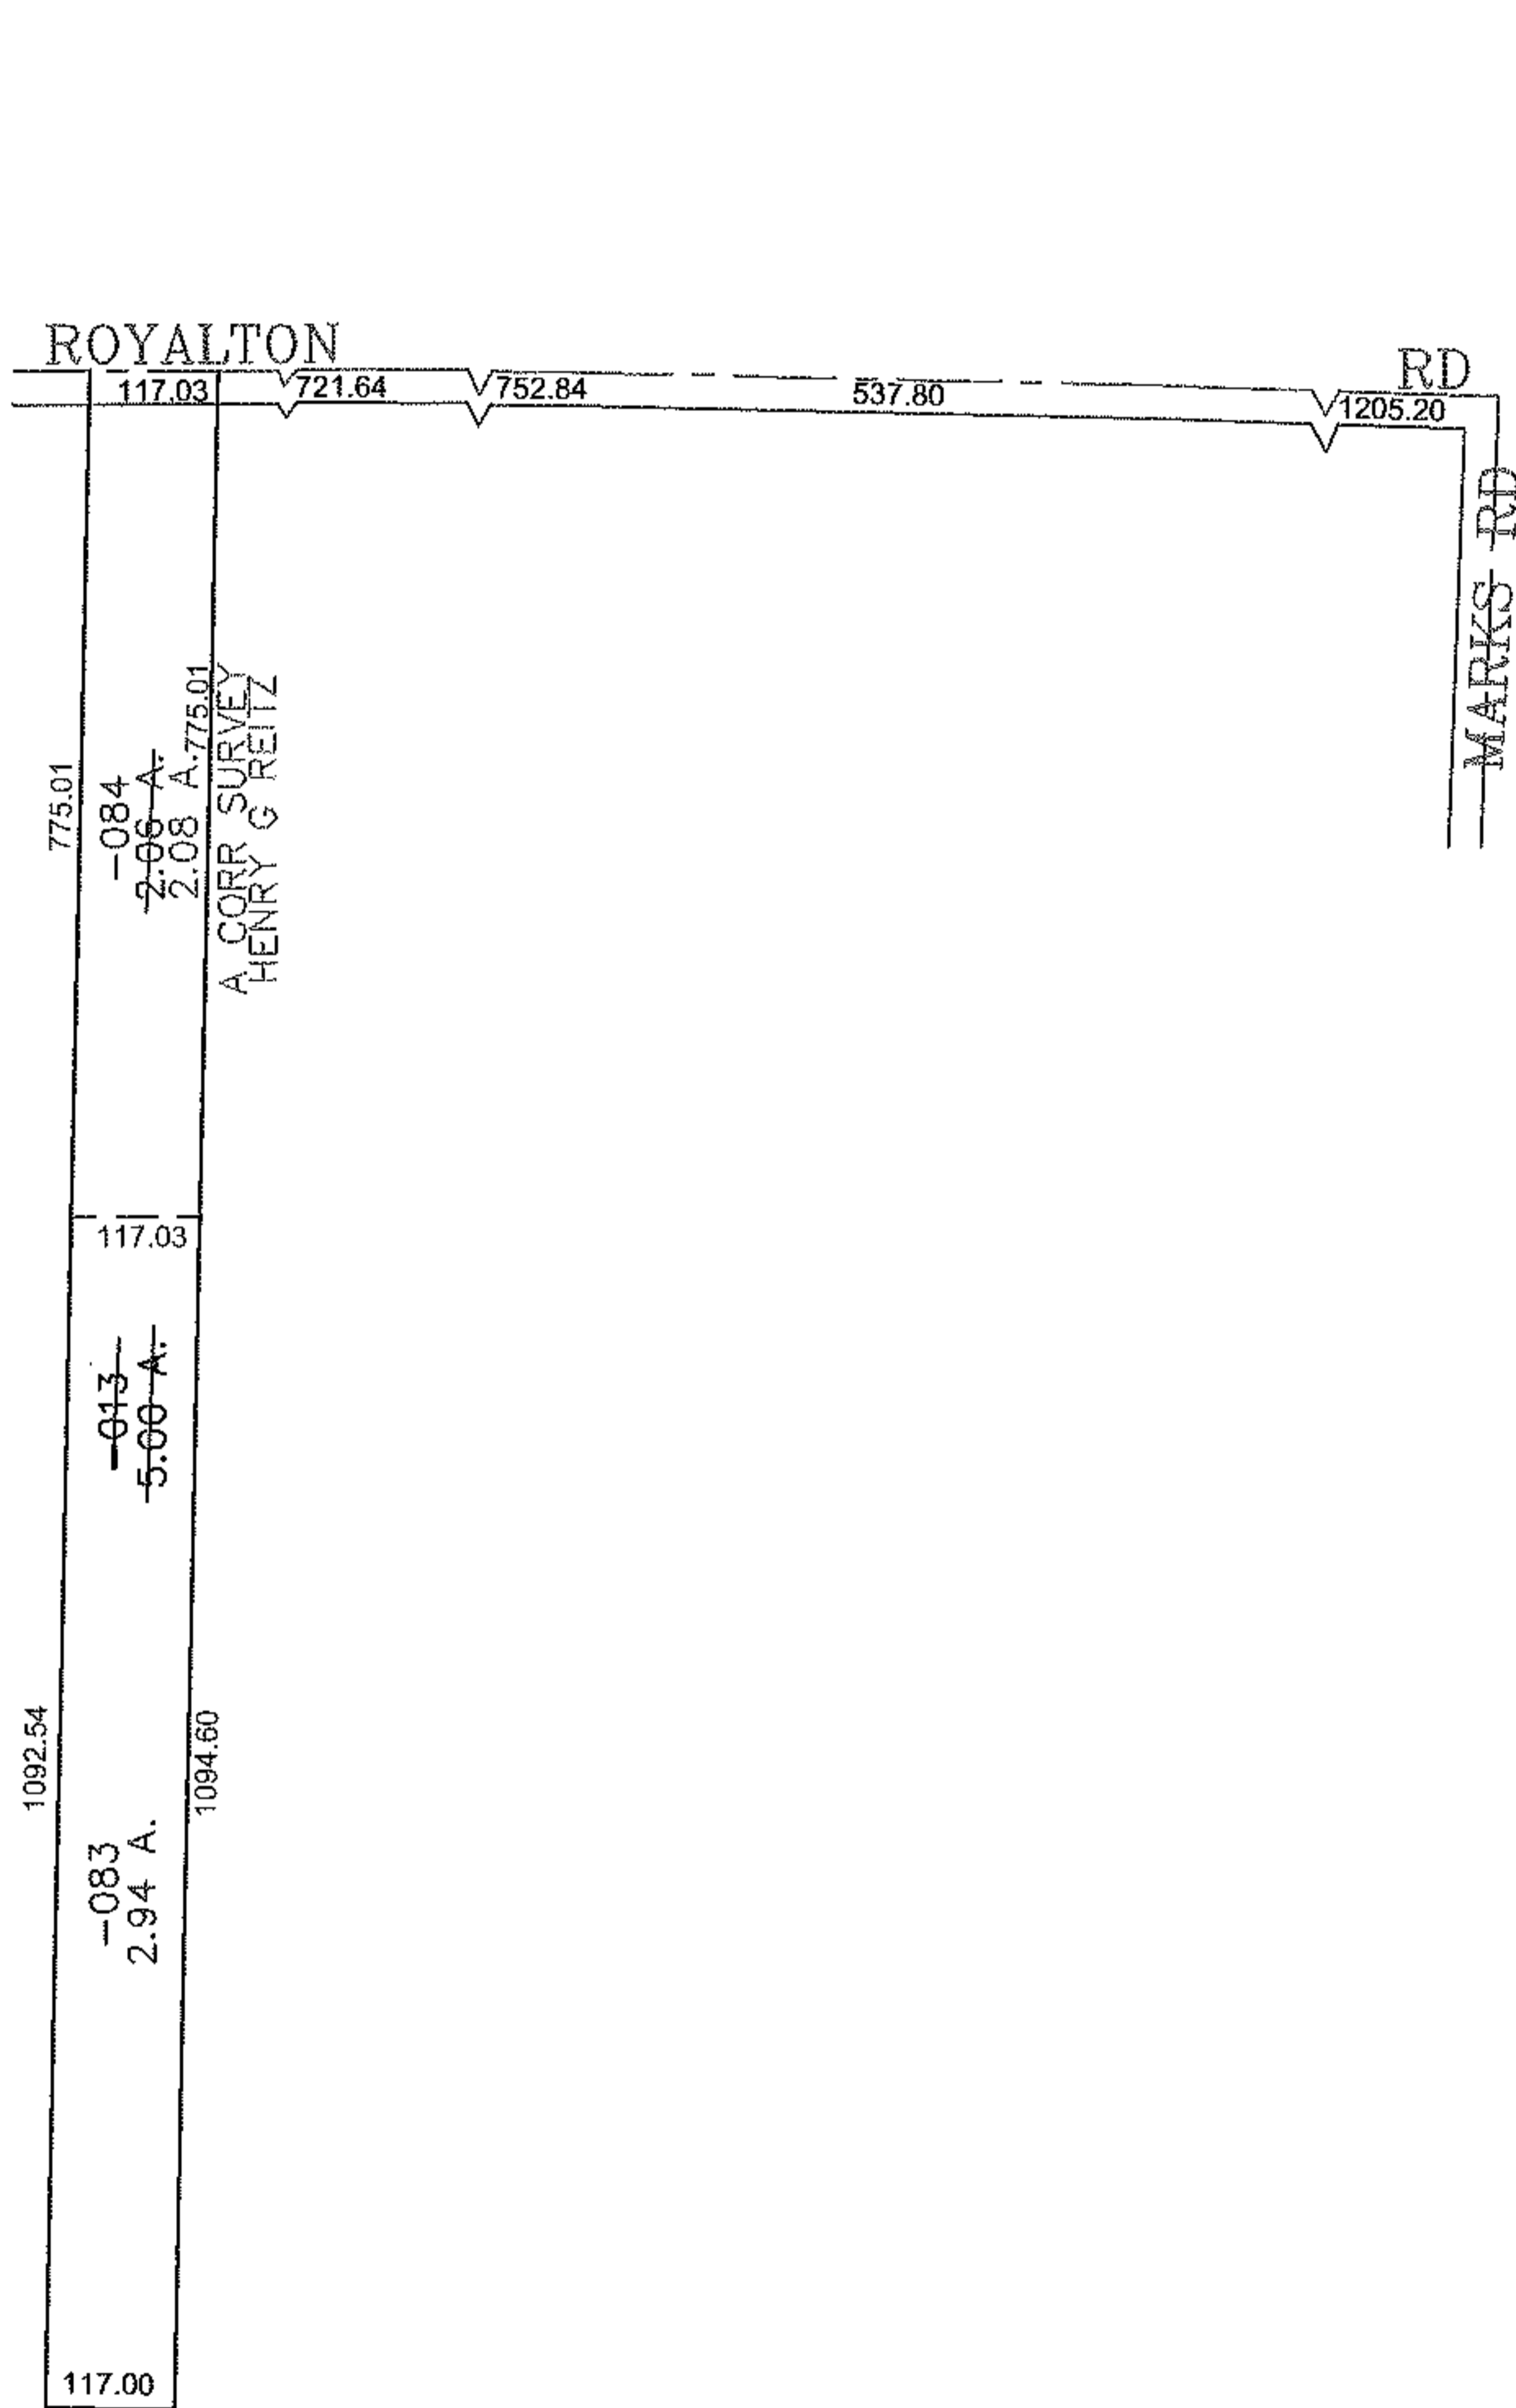

SPLITS/DEEDS PROCESSED

LORAIN COUNTY TAX MAP DEPARTMENT
226 MIDDLE AVE. ELYRIA, OHIO

SURVEYED BY: HENRY G REITZ
 CLOSURE: 0.00 : 10,000
 MAP PAGE(S): 12-00-015-B
 APPROVED BY: JAH DATE: 3-2-09
 SCALE: 1" = 300 PRIOR INSTRUMENT: 20010732595