



RASTER

PARENT PARCEL: 02-01-008-101-236, -254

CHILD PARCEL: 02-01-008-101-385 THRU -387

STARTING POINT: CENTERLINE OF OBERLIN AVE & NORTH RIDGE RD

09-02676

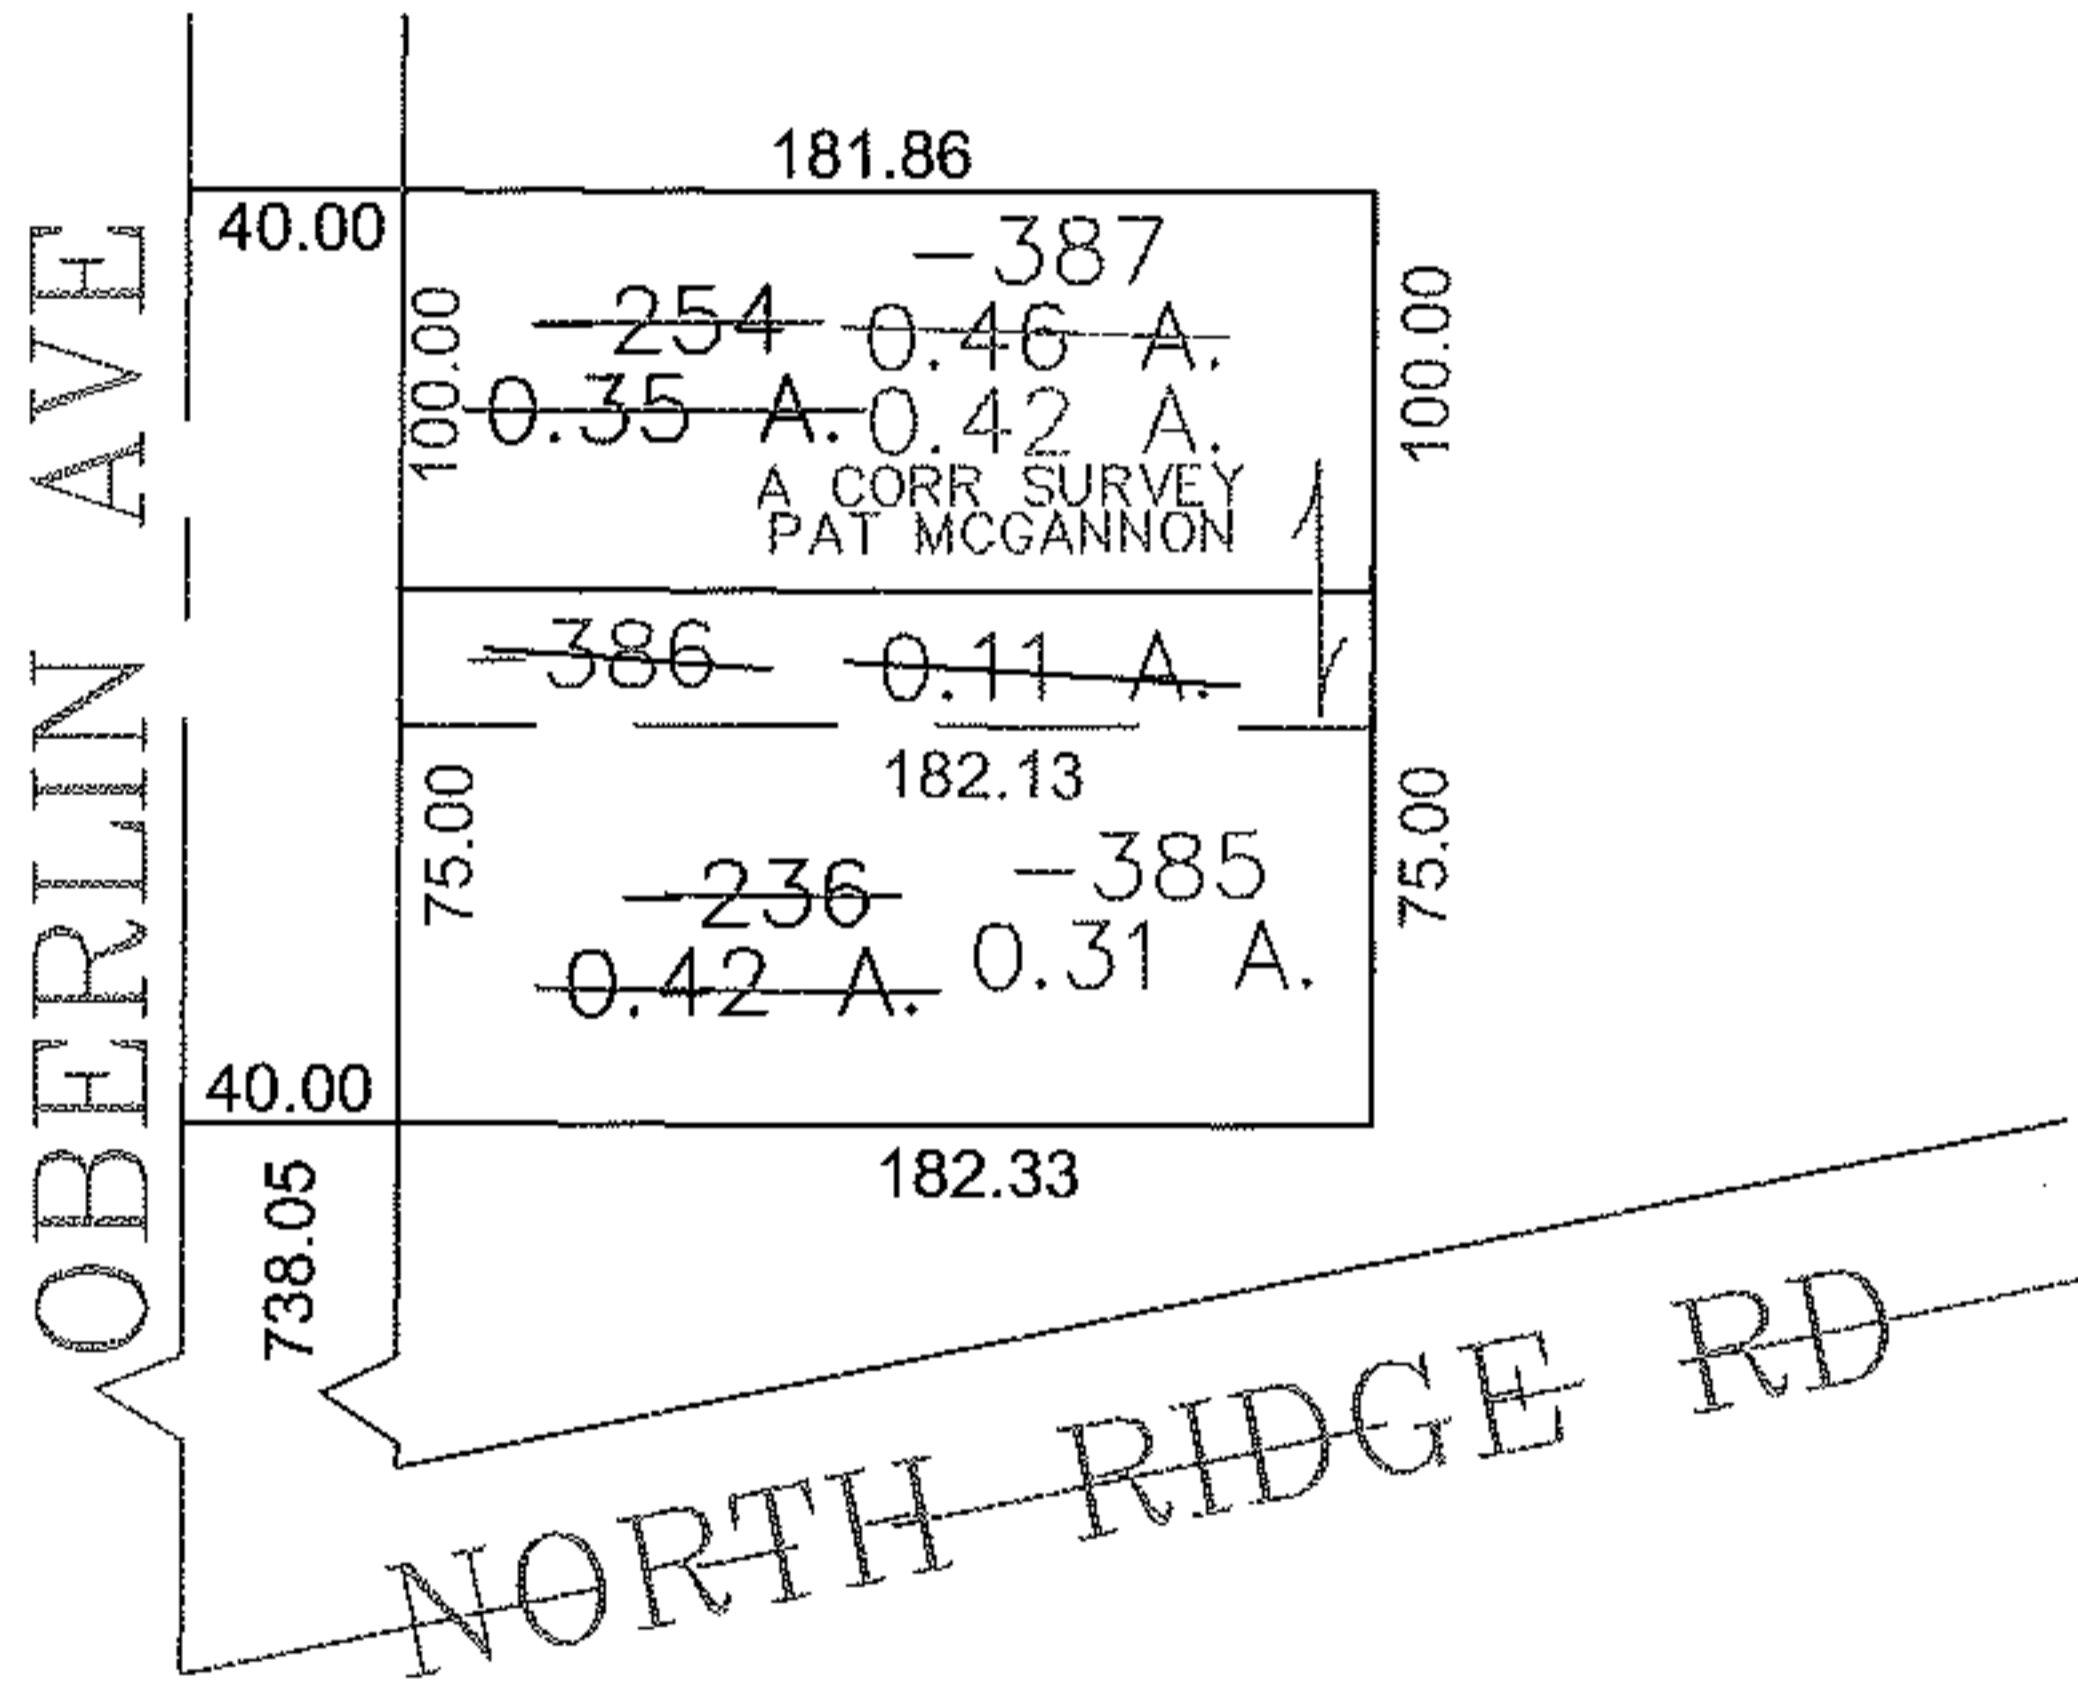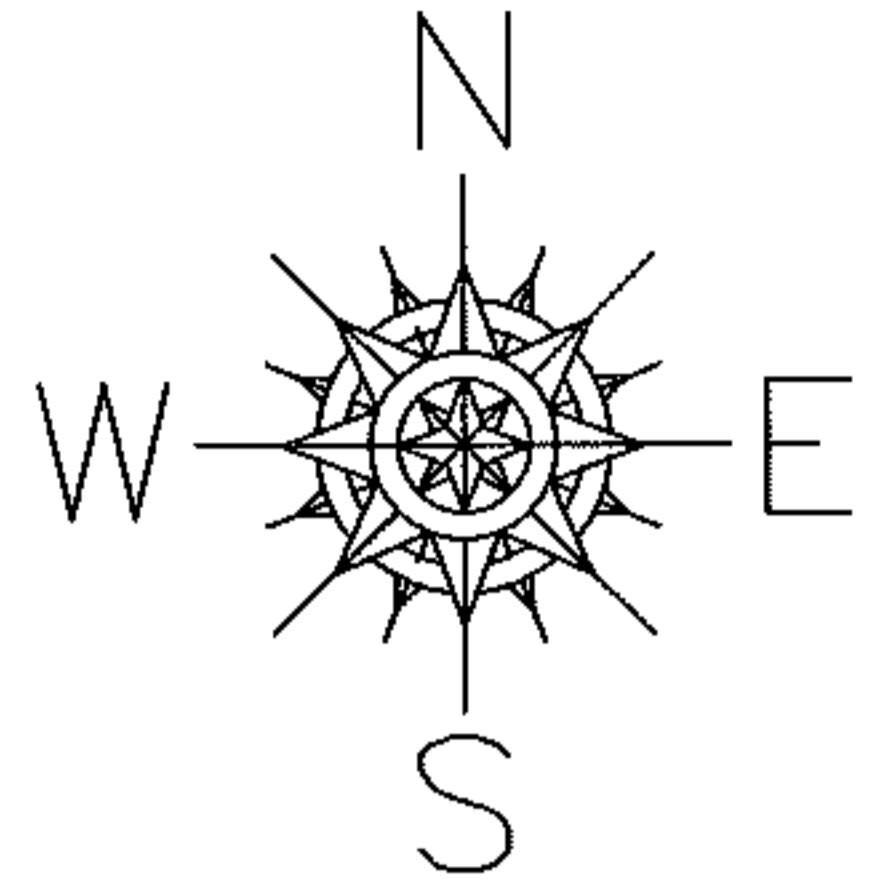

SPLITS/DEEDS PROCESSED

LORAIN COUNTY TAX MAP DEPARTMENT  
226 MIDDLE AVE. ELYRIA, OHIO

SURVEYED BY: PATRICK MCGANNON

CLOSURE: 0.00 : 10.000

MAP PAGE(S): 02-01-008-B

APPROVED BY: JAH DATE: 3-16-09

SCALE: 1" = 100' PRIOR INSTRUMENT: 20040024553