


PARENT PARCEL: 21-05-008-000-029, -030 DROP FROM DUP

CHILD PARCEL: 21-05-008-000-002, -003 ADD TO DUP

STARTING POINT: CENTERLINE OF ASHLAND OBERLIN RD & O.L. 8



13-02677-X

DROP FROM DUP
21-05-008-000-029, -030
ADD TO DUP
21-05-008-000-002, -003
TO CORRECT PARCEL NUMBERS

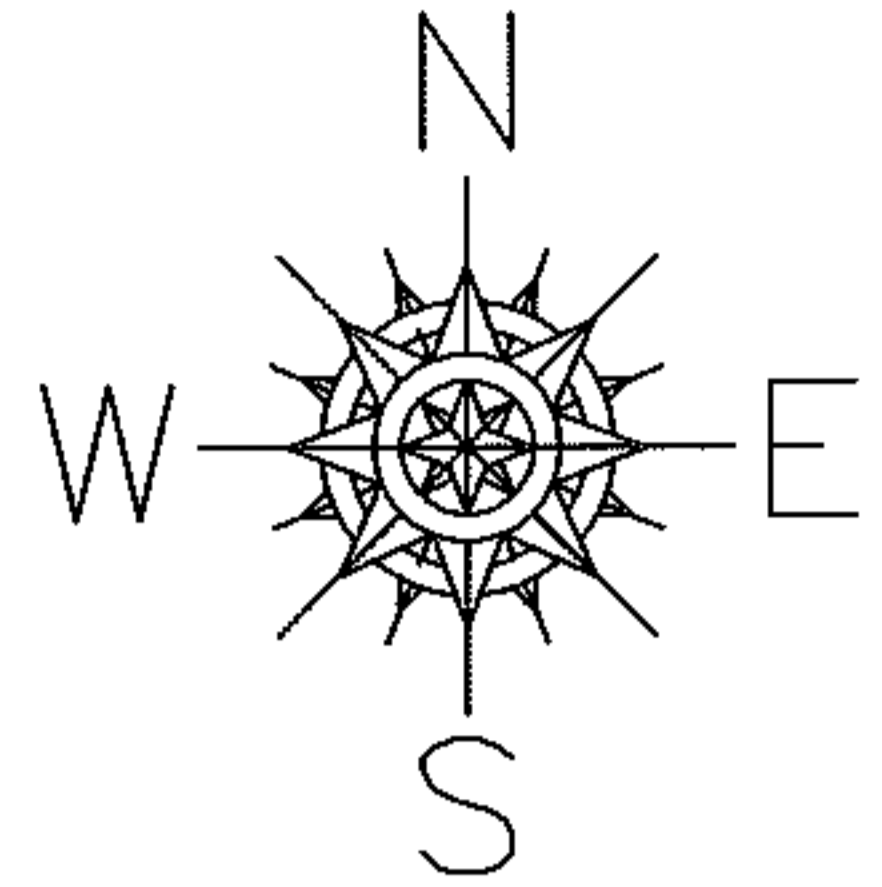

~~-003~~
~~-030~~
92.82 A.

~~-002~~
~~-029~~
3.18 A.

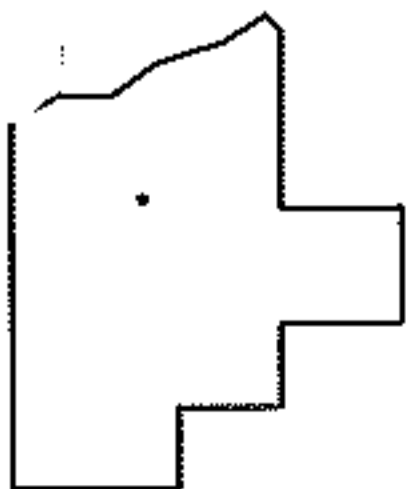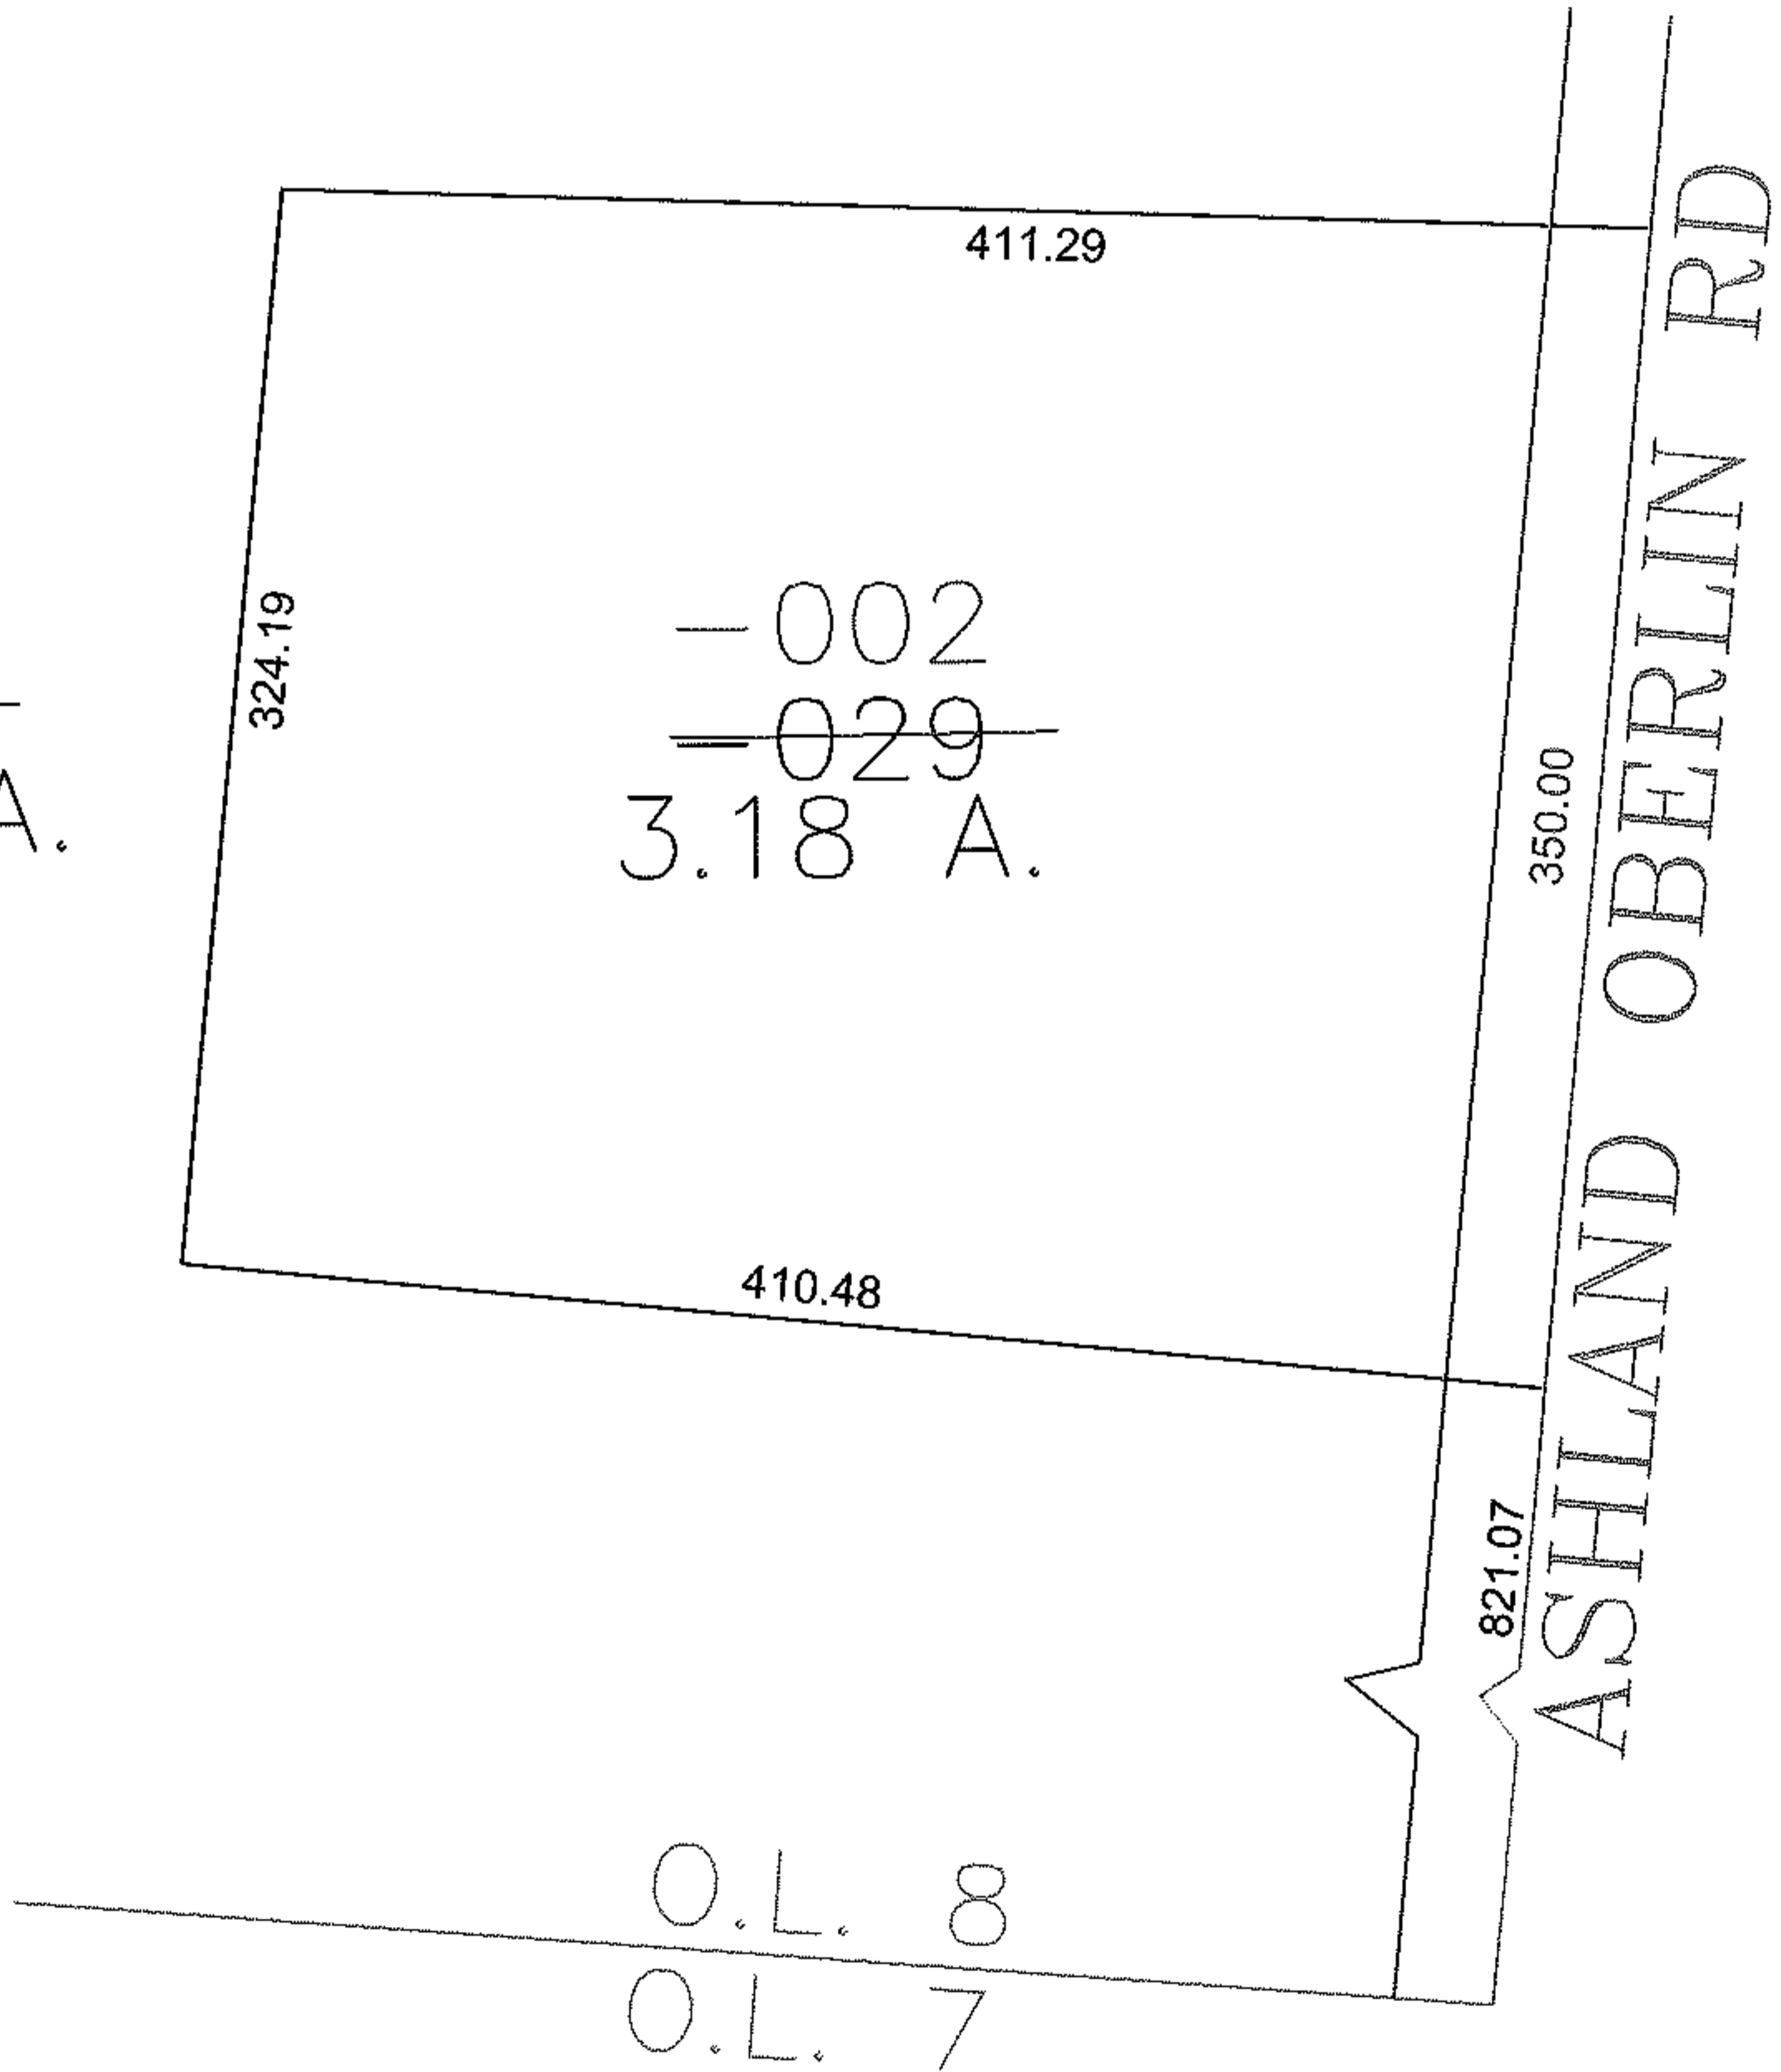

SPLITS/DEEDS PROCESSED

LORAIN COUNTY TAX MAP DEPARTMENT
226 MIDDLE AVE. ELYRIA, OHIO

SURVEYED BY: RICHARD CARLSON

CLOSURE: 0.00 : 10,000

MAP PAGE(S): 21-05-008-B

APPROVED BY: JAH DATE: 3/4/2013

SCALE: 1" = 100 PRIOR INSTRUMENT: DV 1272/99