



RASTER

PARENT PARCEL: 10-00-006-106-016, -023

CHILD PARCEL: 10-00-006-106-028, ADD TO DUP 11-00-093-101-082


STARTING POINT: CENTERLINE OF EAST RIVER RD & DEWHURST RD

09-02678

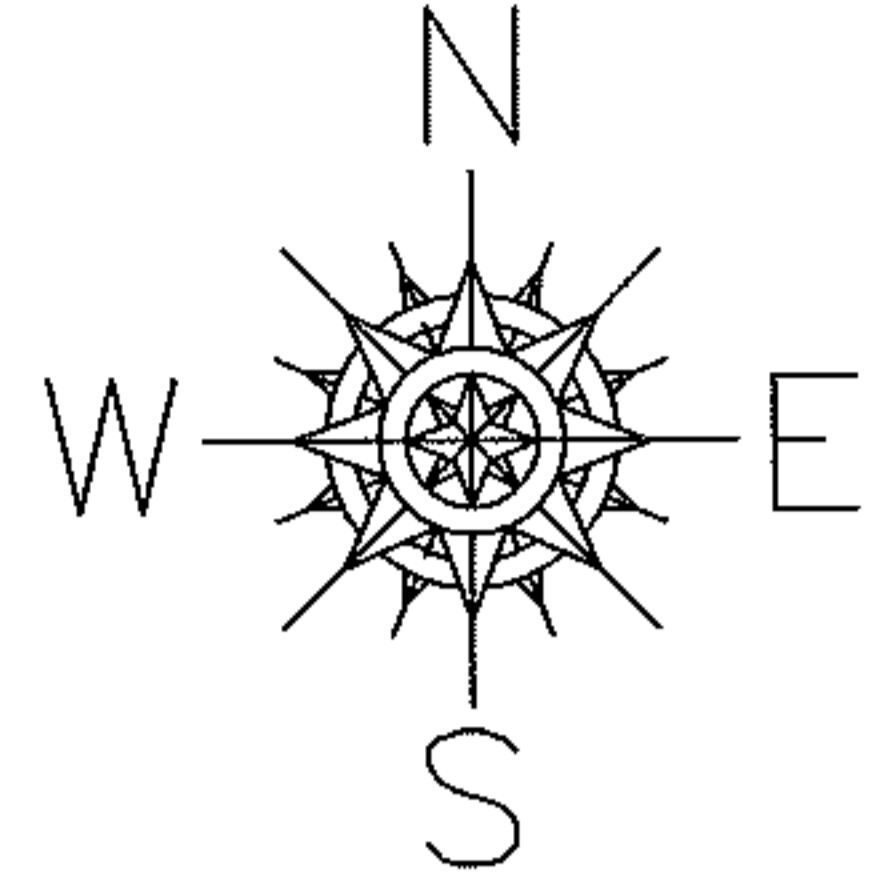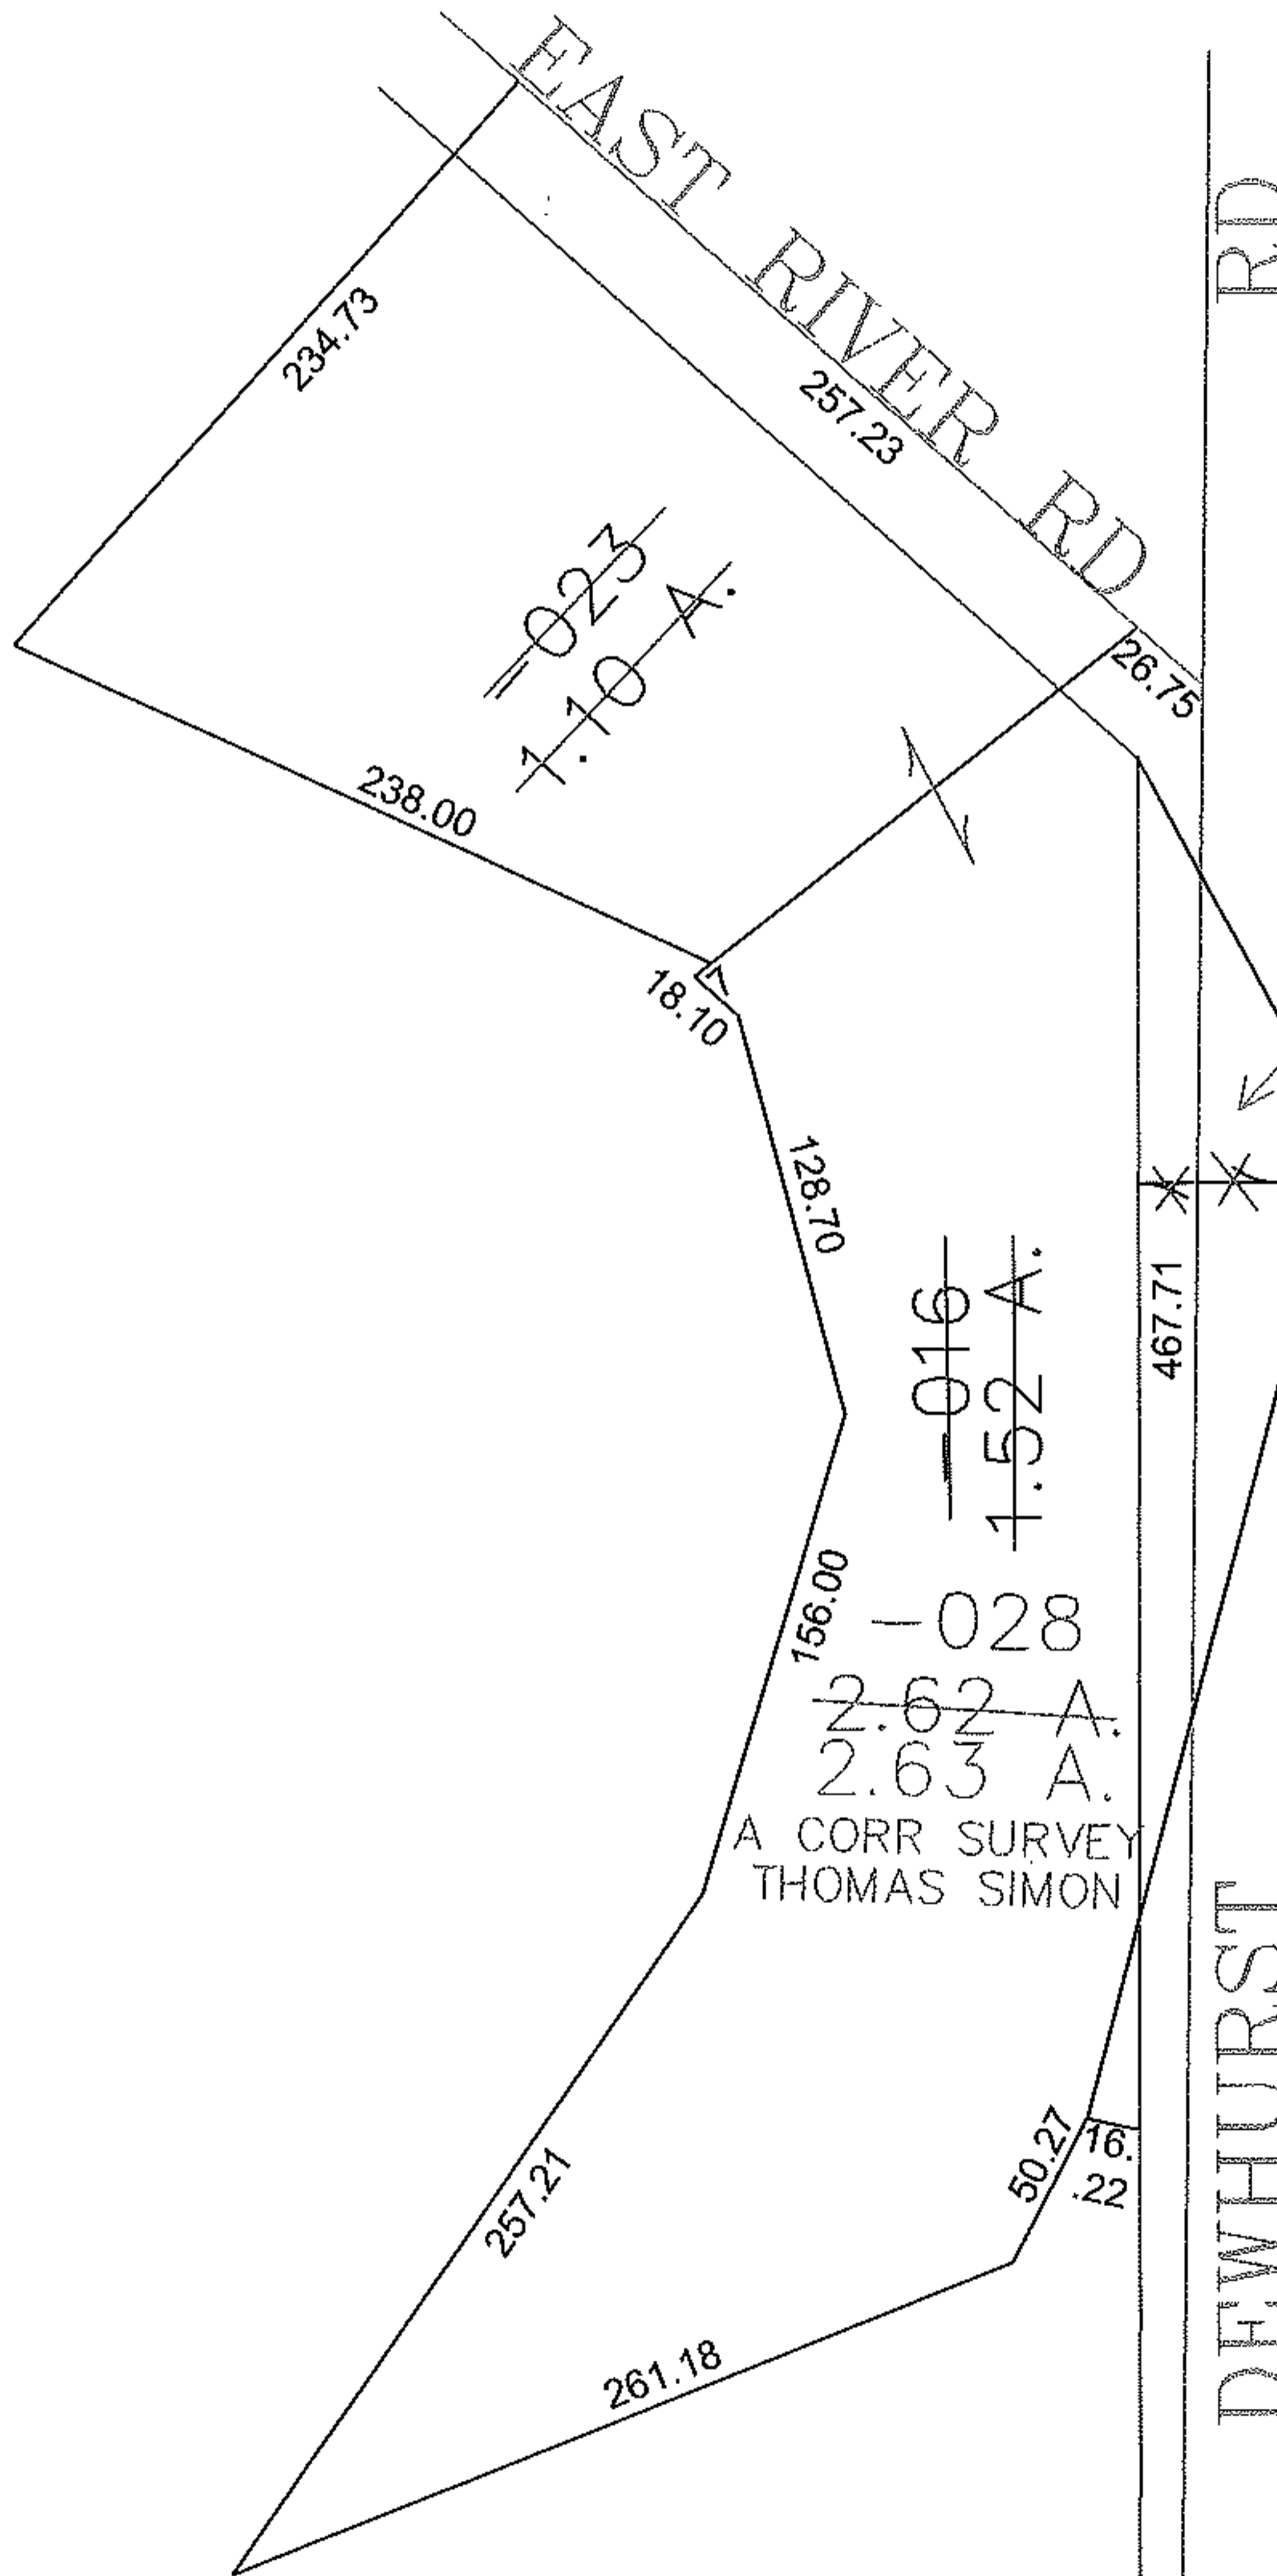

ADD TO DUP

11-00-093-101-082
0.29 A.

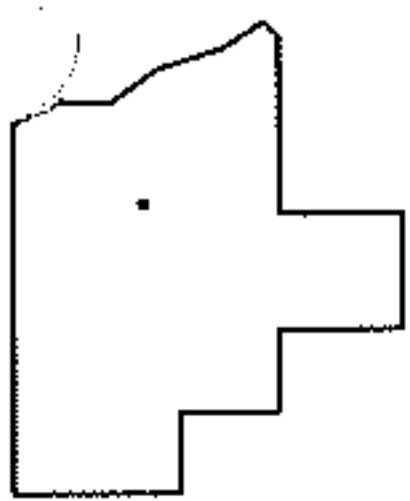

SPLITS/DEEDS PROCESSED

LORAIN COUNTY TAX MAP DEPARTMENT
226 MIDDLE AVE. ELYRIA, OHIO

SURVEYED BY: THOMAS SIMON
 CLOSURE: 0.00 : 10.000
 MAP PAGE(S): 10-00-006-D, 11-00-093-A
 APPROVED BY: JAH DATE: 3-30-09
 SCALE: 1" = 100 PRIOR INSTRUMENT: 20010791052