

PARENT PARCEL: DROP FROM DUPLICATE

CHILD PARCEL: 04-00-014-900-016

STARTING POINT: XXXXXX



NO. 13-02681-C

DROP FROM DUPLICATE

04-00-014-900-016


1.06 A.

PARCELS ON BELDEN-AVON RD. GO TO CL
PLAT ONLY DEDICATED WEST PARK RD.

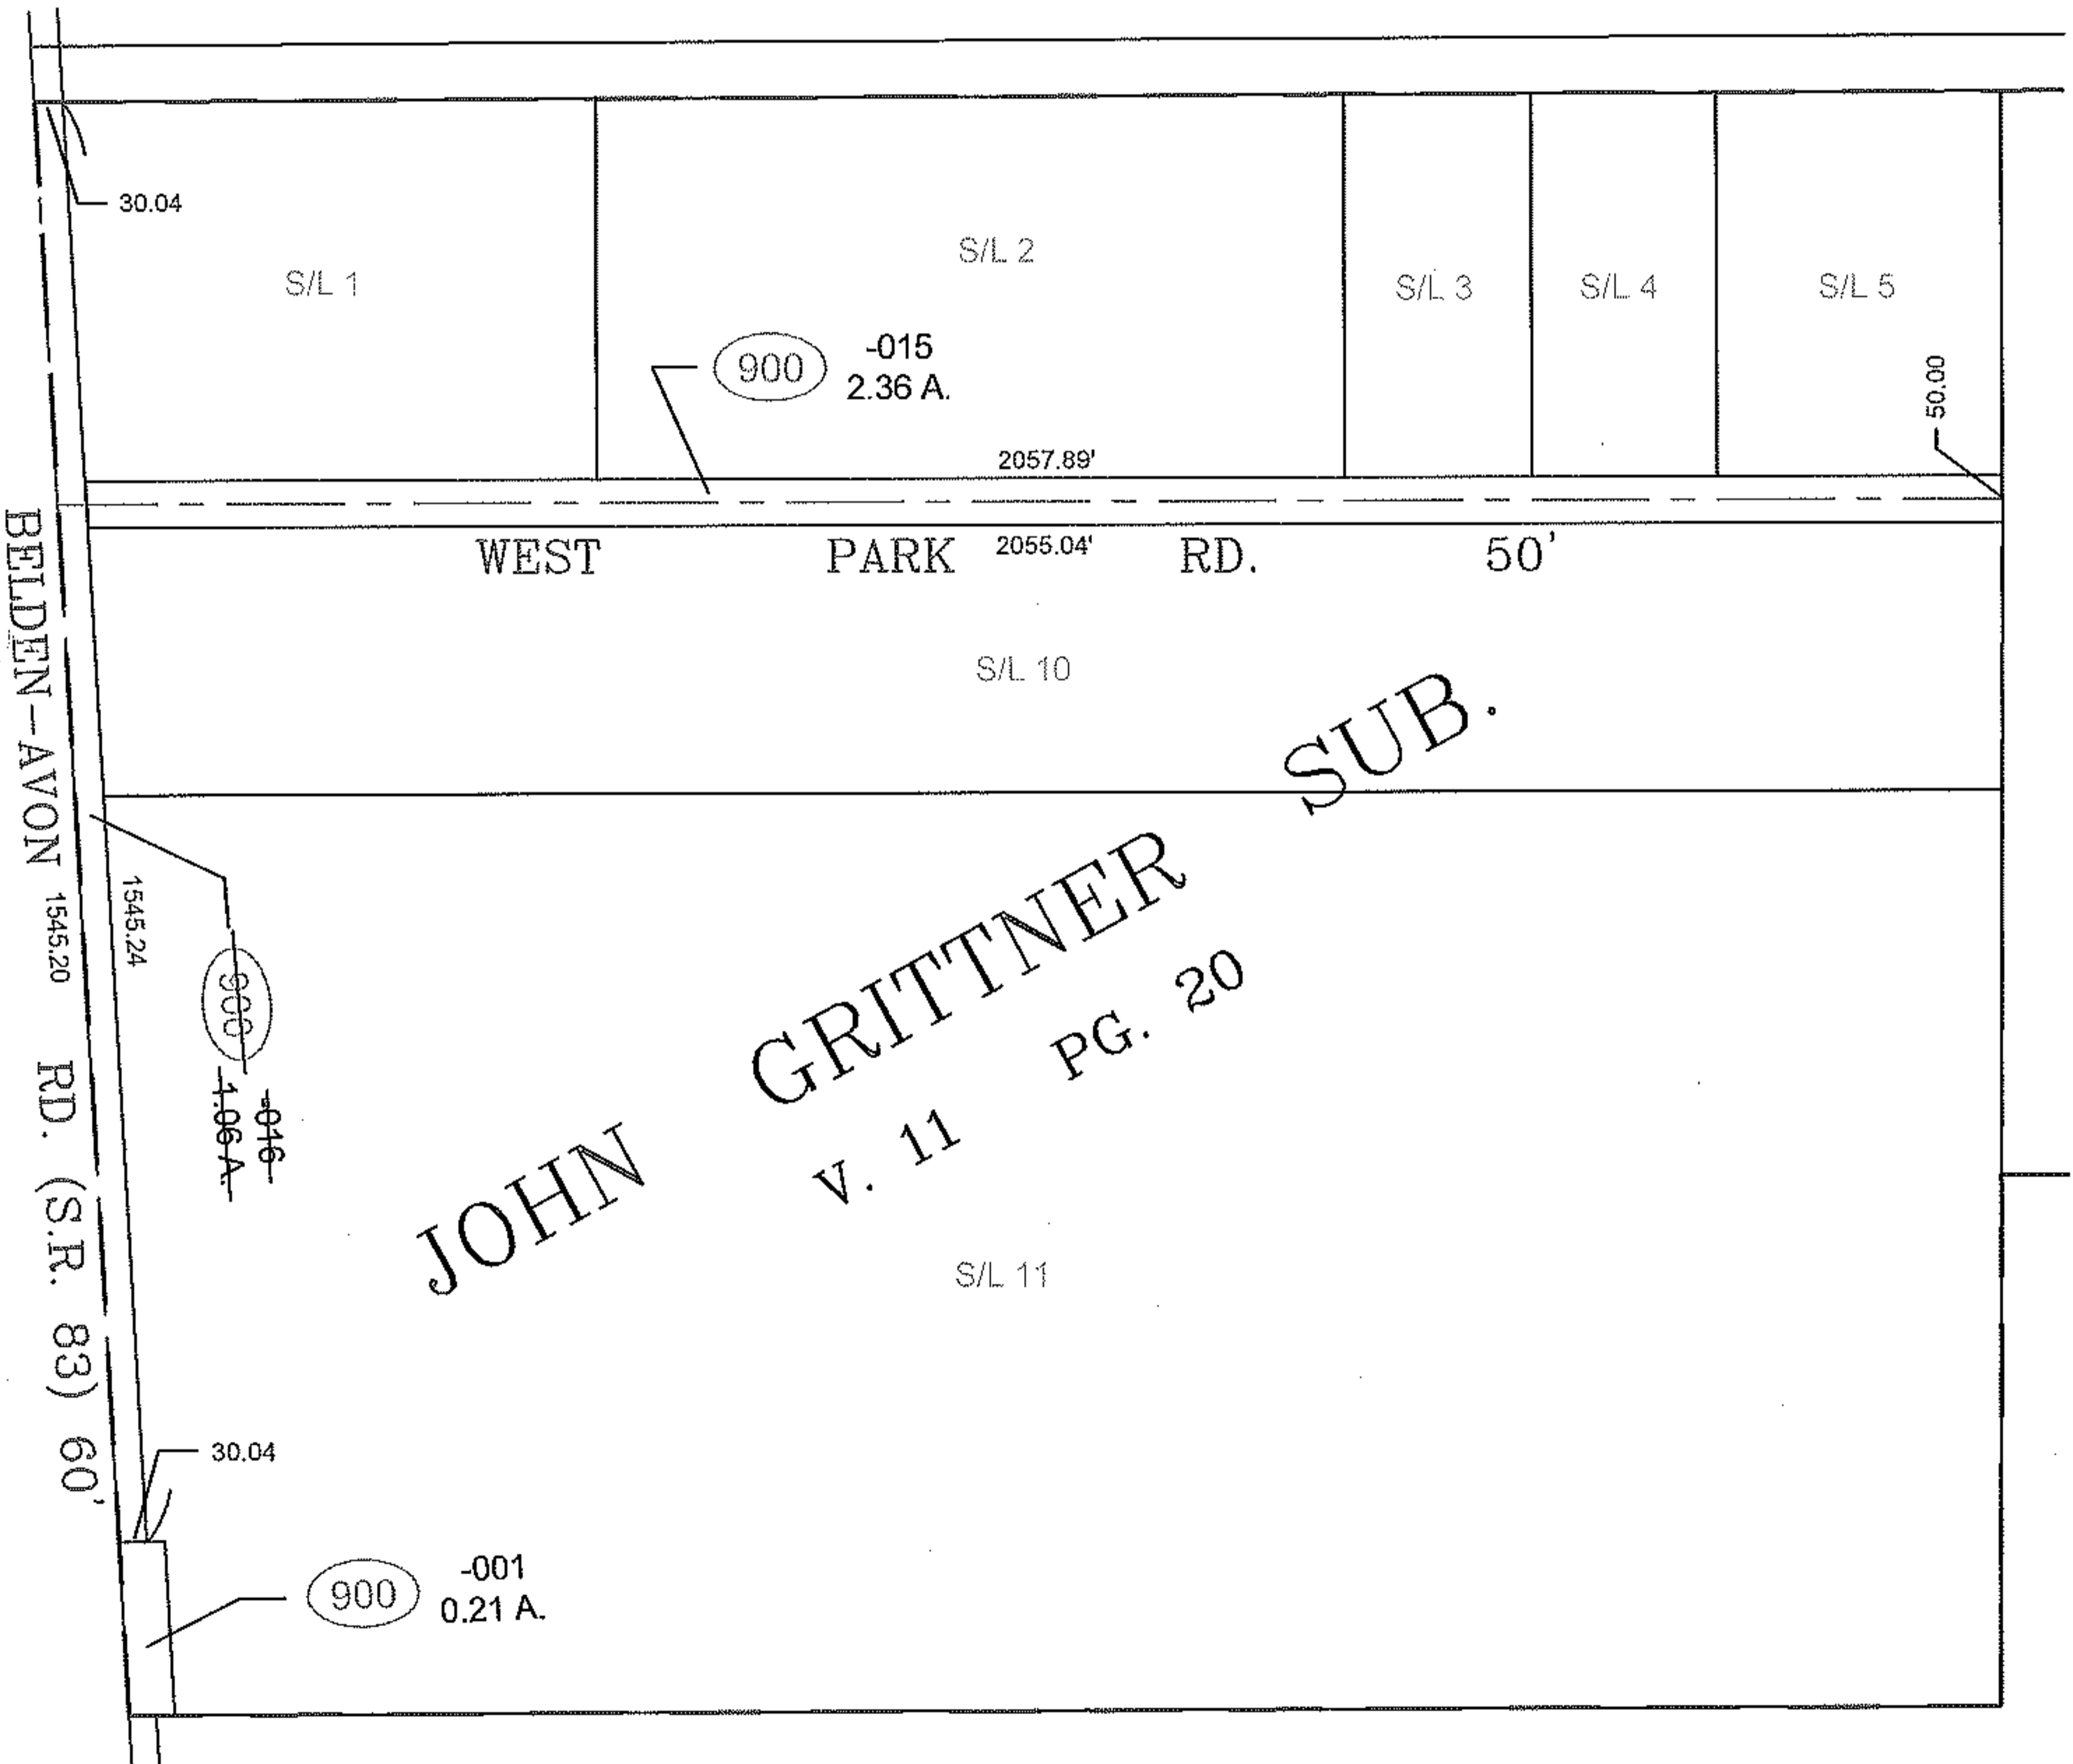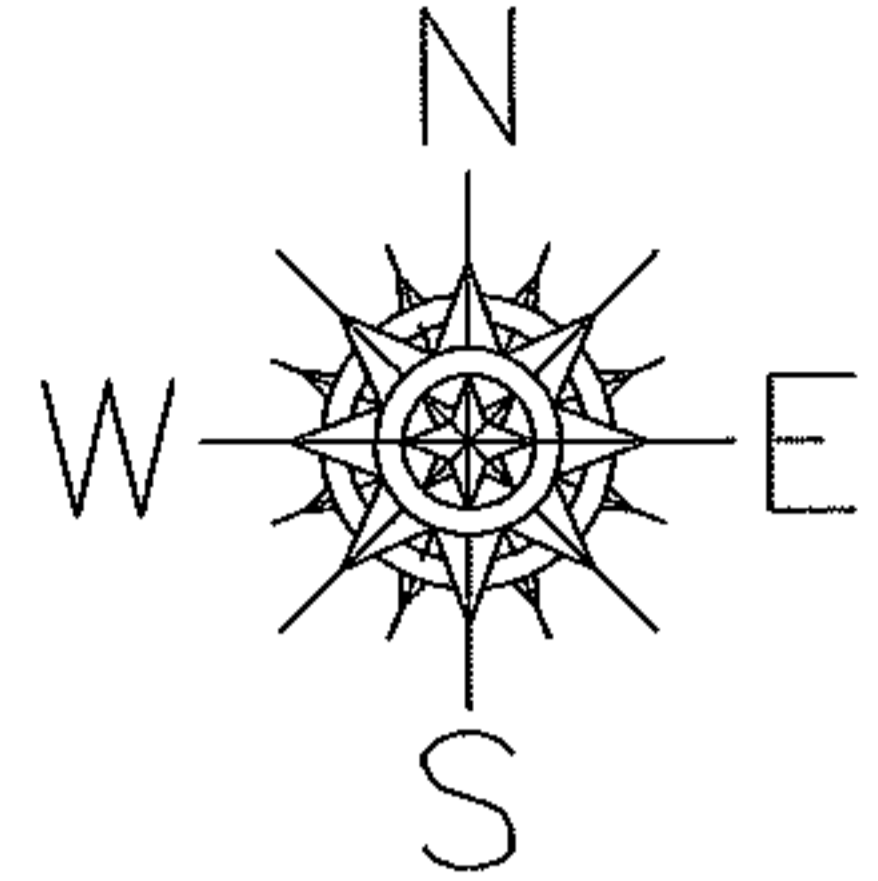

SUB.

JOHN GRITNER
V. 11 PG. 20

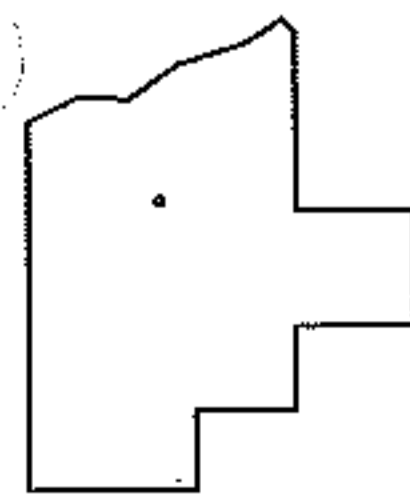

SPLITS/DEEDS PROCESSED
LORAIN COUNTY TAX MAP DEPARTMENT
226 MIDDLE AVE. ELYRIA, OHIO

SURVEYED BY: REITZ ENGINEERING
CLOSURE: 0.01 : 10,000
MAP PAGE(S): 04-00-014-C
APPROVED BY: TJS DATE: 3/7/13
SCALE: 1" = 300 PRIOR INSTRUMENT: PV 11 PG. 20