


PARENT PARCEL: 09-00-010-000-007, -009



CHILD PARCEL: _____

13-02682-X

STARTING POINT: AT A MON BOX AT THE INTERSECTION OF C/L OF ALBRECHT RD. AND C/L OF FOWL RD.

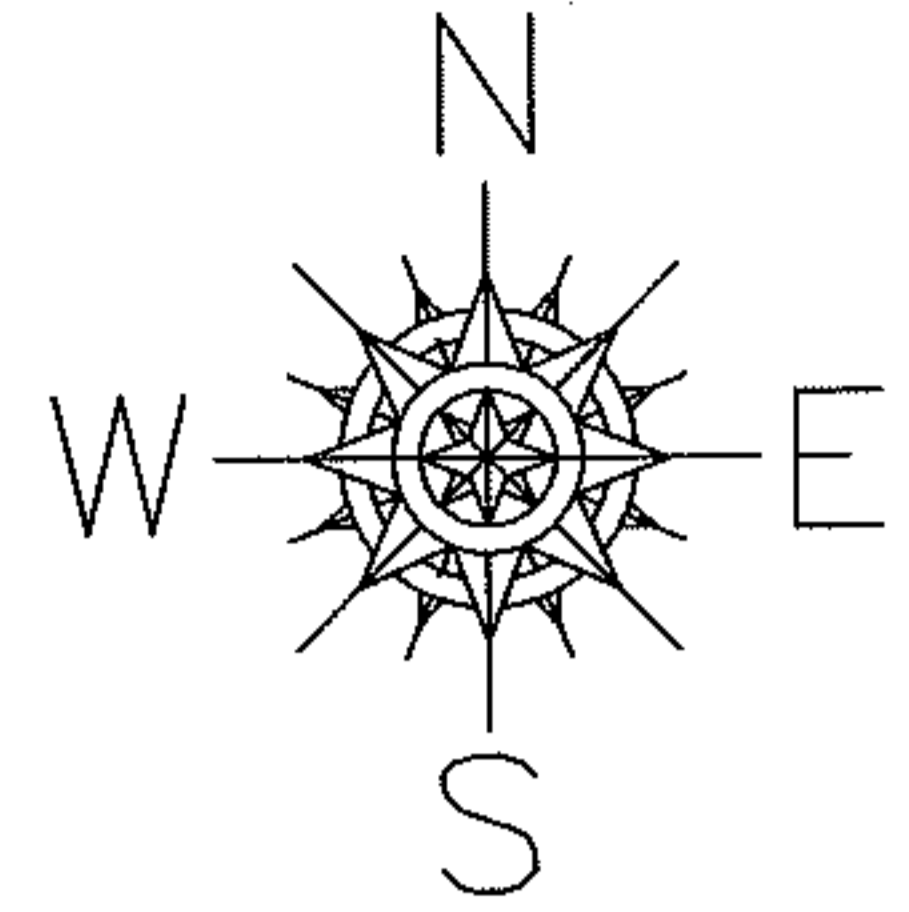

MAP CORRECTION ONLY

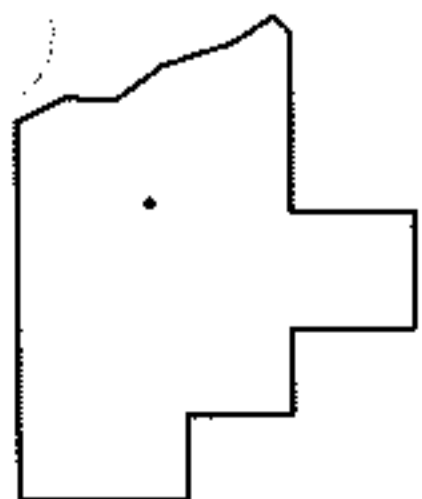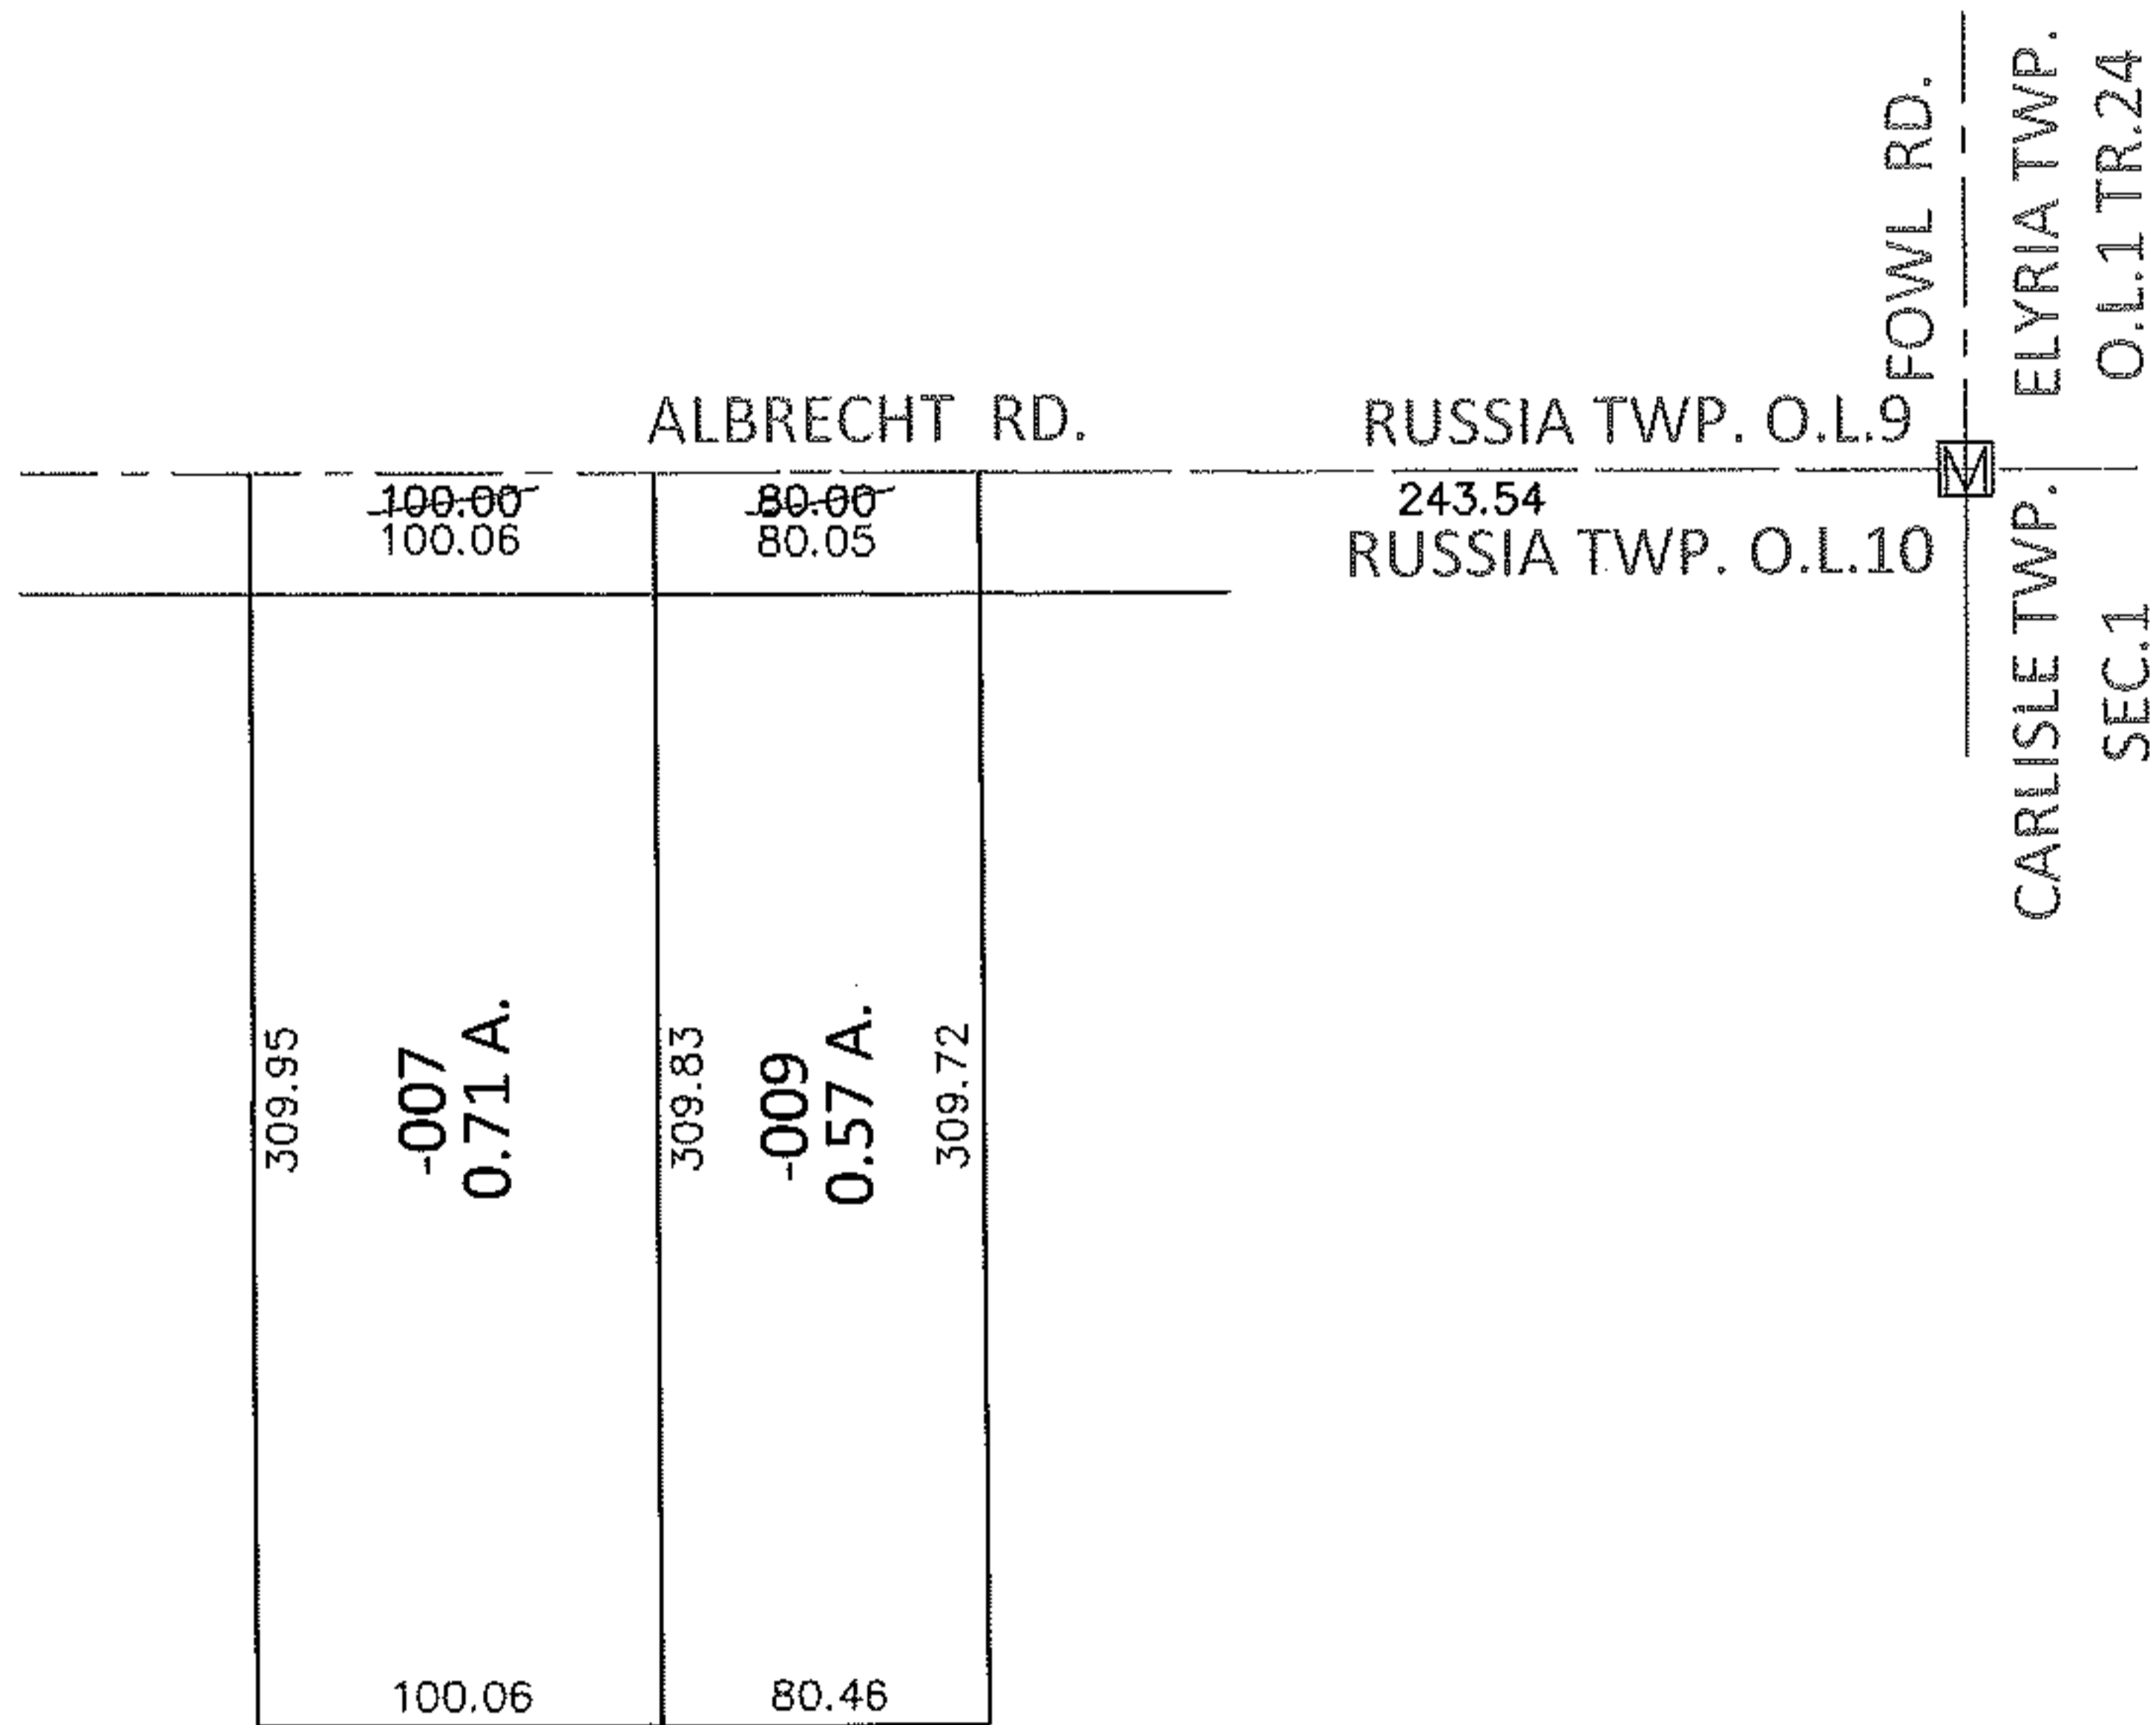

SPLITS/DEEDS PROCESSED

LORAIN COUNTY TAX MAP DEPARTMENT
226 MIDDLE AVE. ELYRIA, OHIO

SURVEYED BY: THOMAS A. SIMON

CLOSURE: .00:10,000

MAP PAGE(S): 9-D

APPROVED BY: RRM DATE: 3-12-13

SCALE: 1"= 100 PRIOR INST.: 20120417466