




RASTER

PARENT PARCEL: 05-00-079-000-083, -080, -081

CHILD PARCEL: 05-00-079-000-095 THRU -097 05-00-082-000-031

STARTING POINT: CENTERLINE OF MIDDLE RIDGE RD & WEST RIDGE RD

09-02683

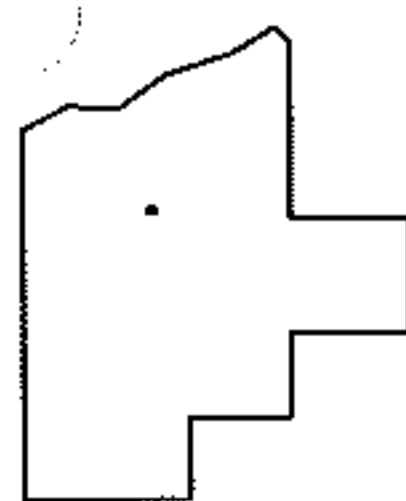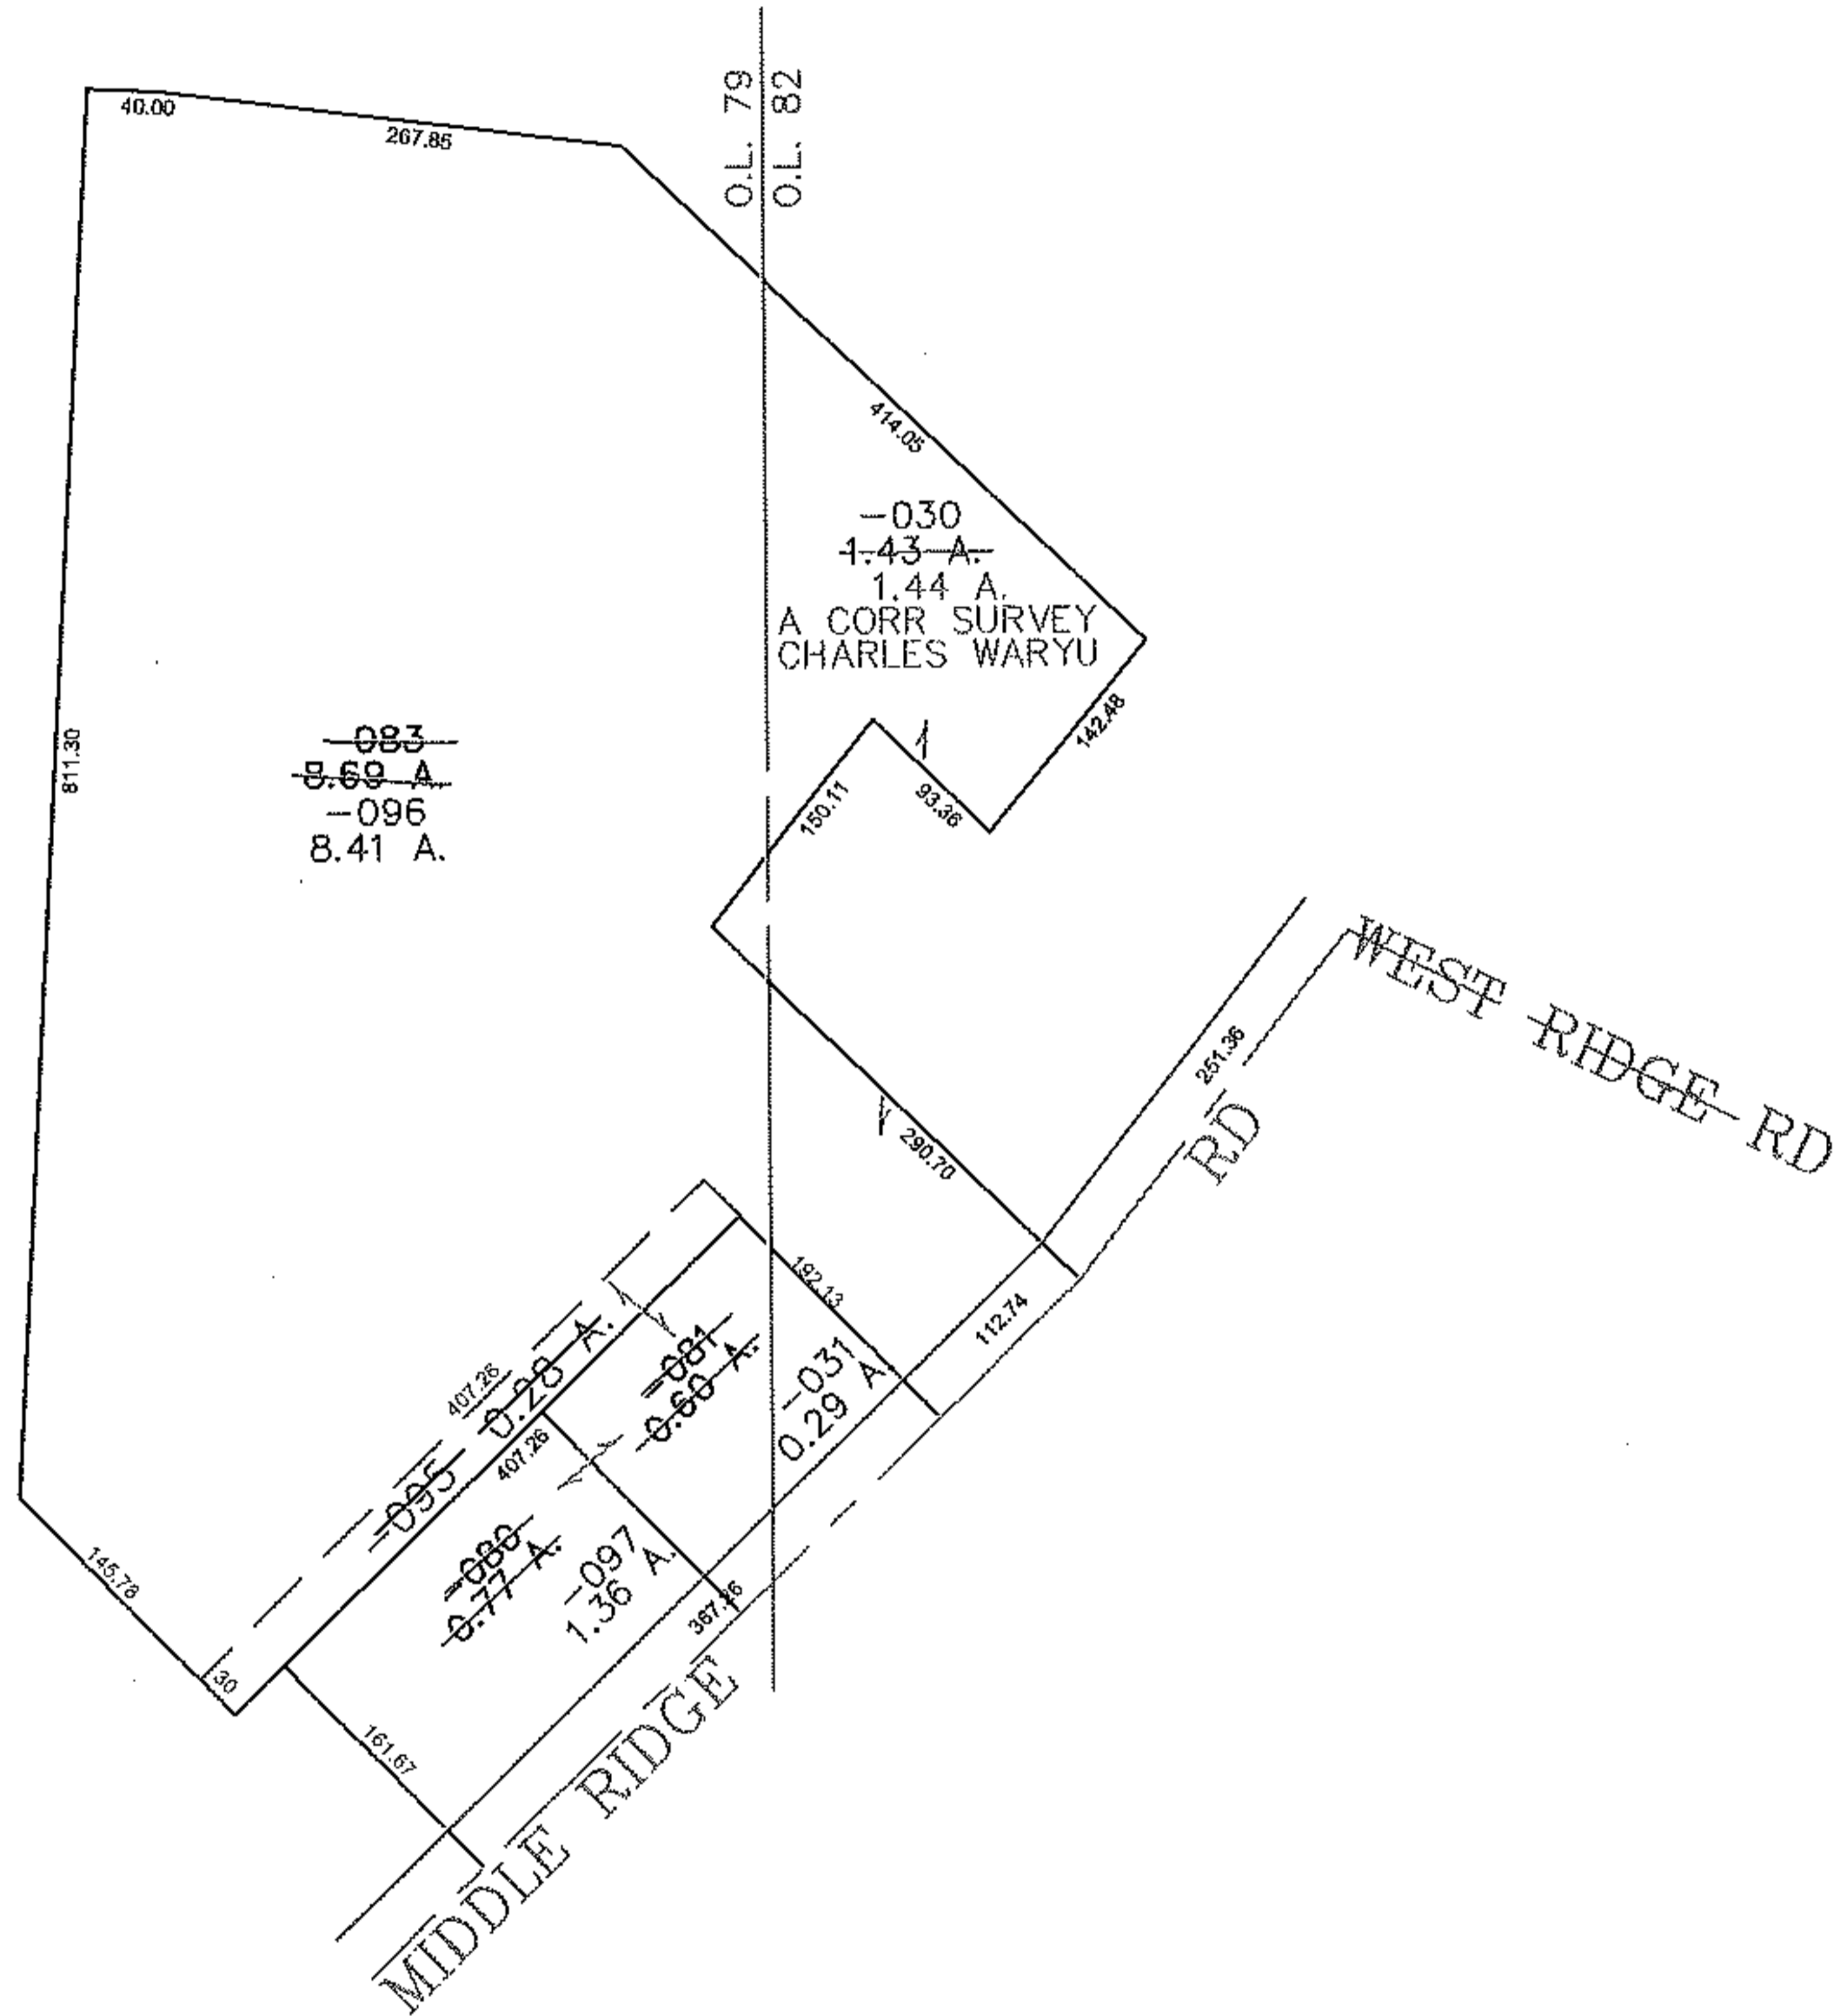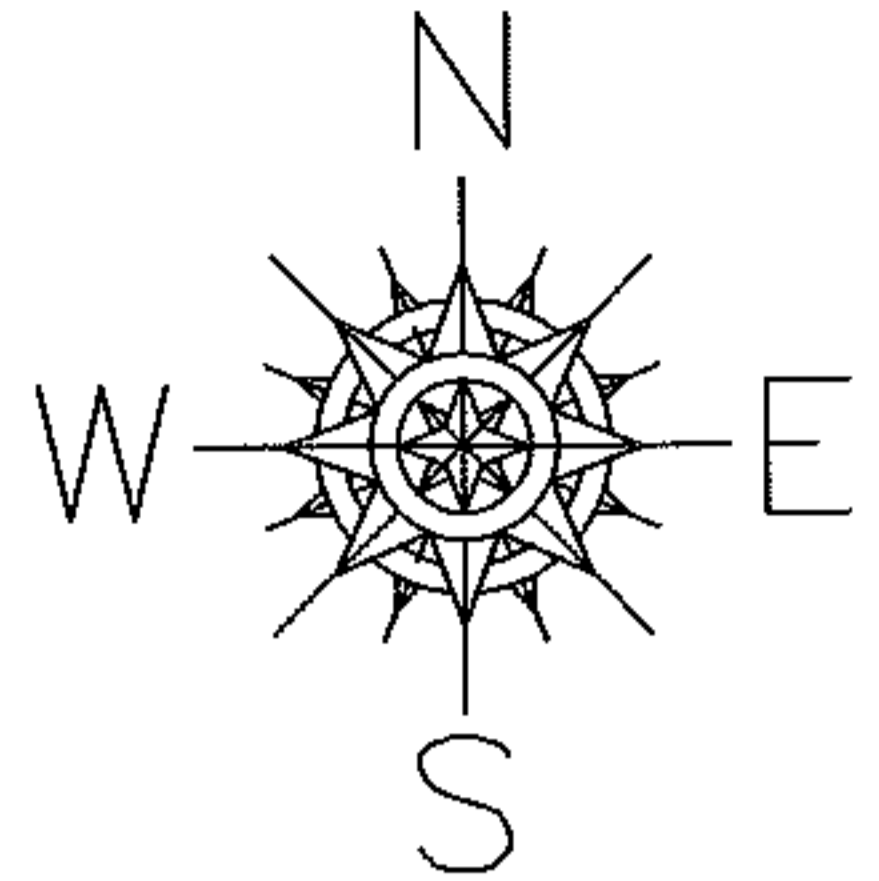

SPLITS/DEEDS PROCESSED
LORAIN COUNTY TAX MAP DEPARTMENT
 226 MIDDLE AVE. ELYRIA, OHIO

SURVEYED BY: CHARLES P WARYU
 CLOSURE: 0.00 : 10,000
 MAP PAGE(S): 05-00-079-B
 APPROVED BY: JAH DATE: 4-8-09
 SCALE: 1" = 200 PRIOR INSTRUMENT: DV 1262/148