


PARENT PARCEL: 10-00-008-111-002  
 CHILD PARCEL: XX-XX-XXX-XXX-XXX  
 STARTING POINT: XXXXXX

13-02684-C

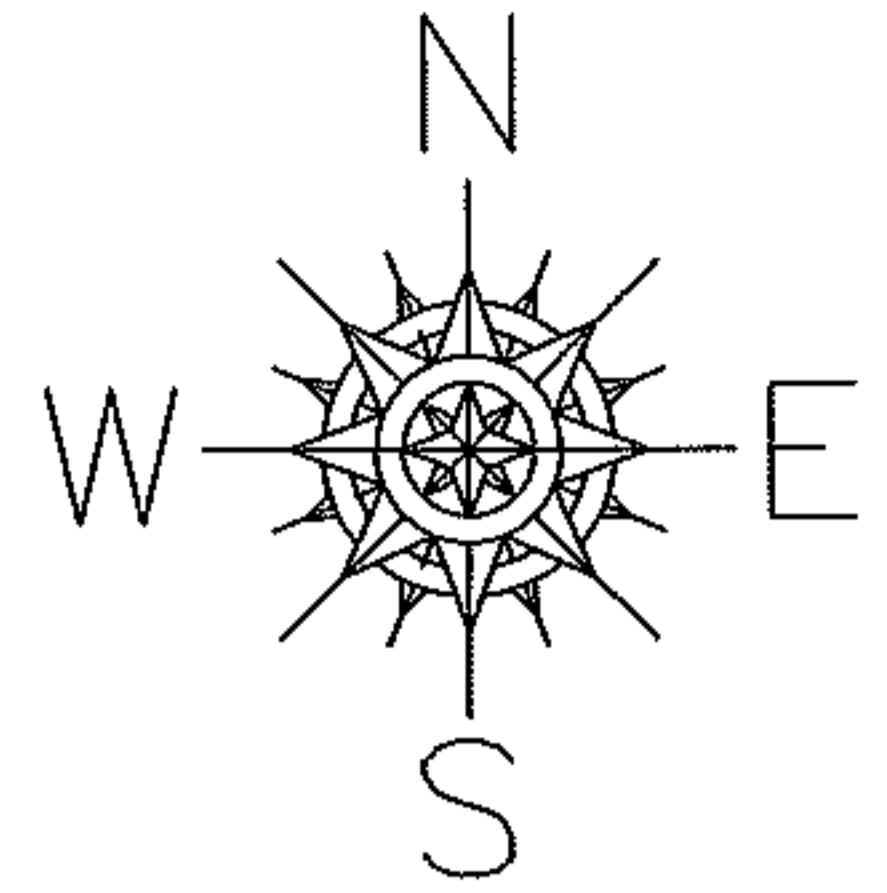

ACREAGE CORRECTION


10-00-008-111-002

~~0.33 A.~~

0.32 A.

CORR. PER DEED

O.R. 367/801

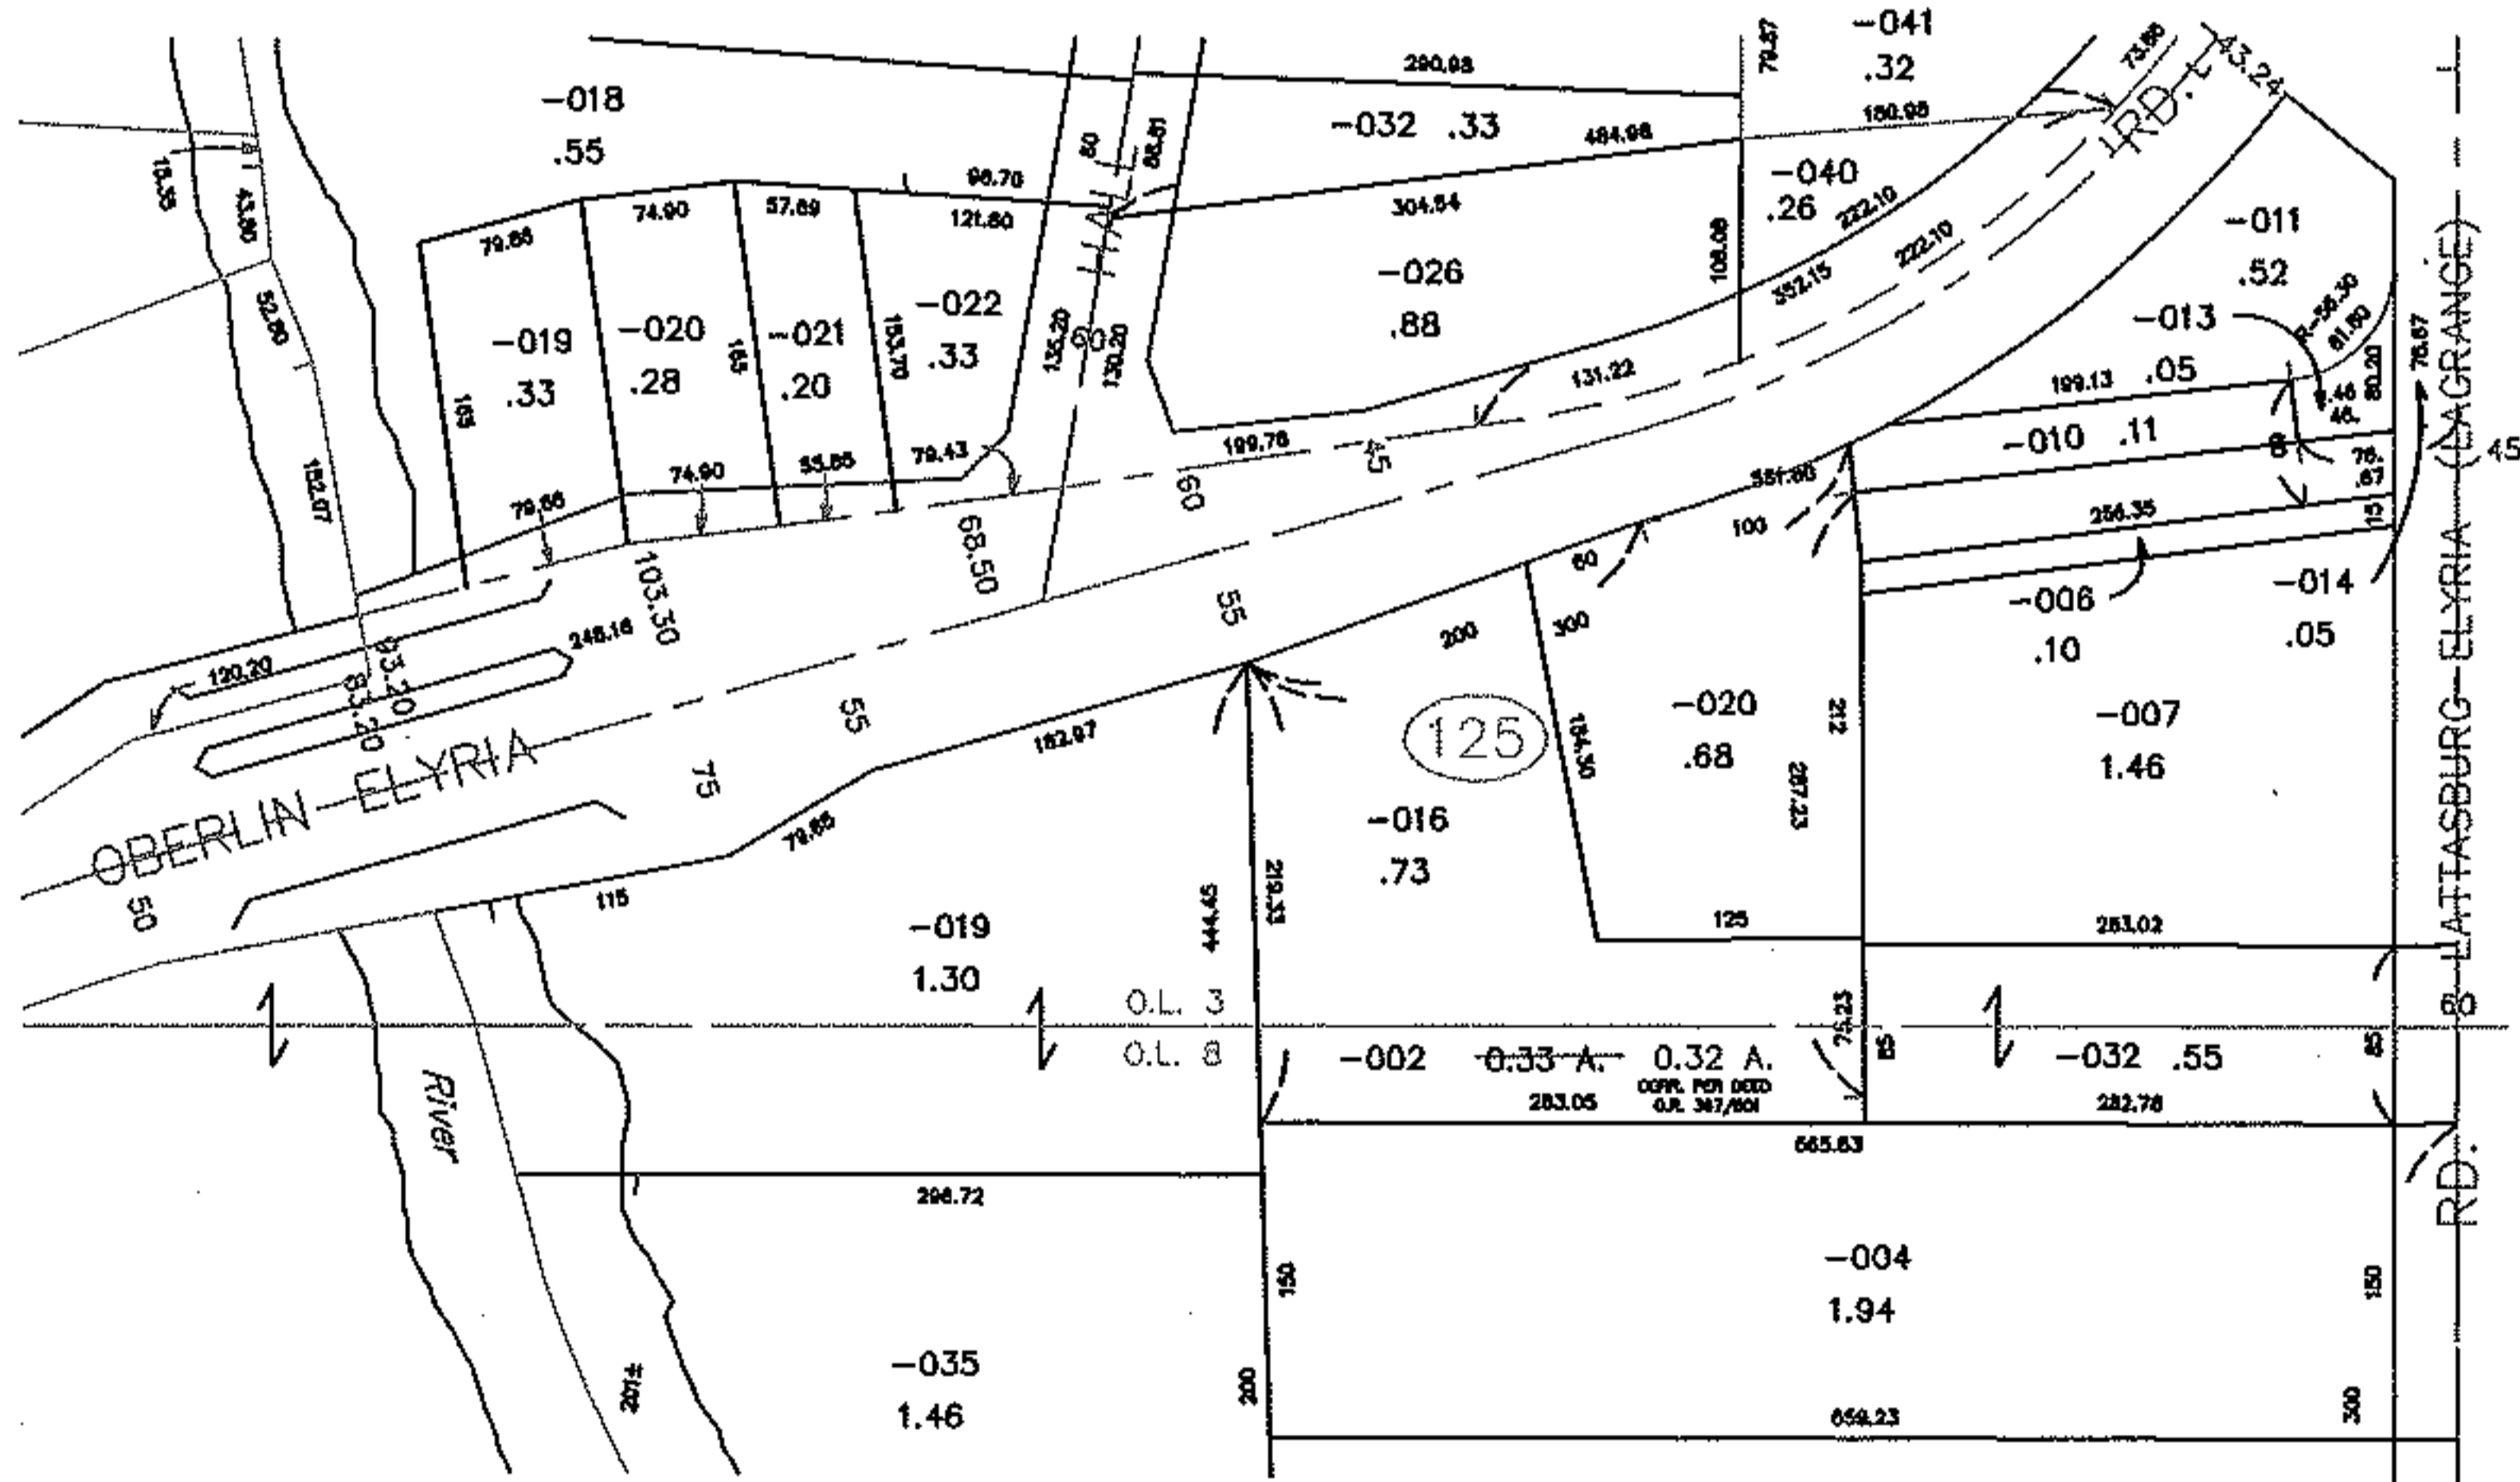

SPLITS/DEEDS PROCESSED  
 LORAIN COUNTY TAX MAP DEPARTMENT  
 226 MIDDLE AVE. ELYRIA, OHIO

SURVEYED BY: NONE  
 CLOSURE: NONE  
 MAP PAGE(S): 10-00-008  
 APPROVED BY: TJS DATE: 3/13/13  
 SCALE: 1" = 200' PRIOR INSTRUMENT: O.R. 367/801