
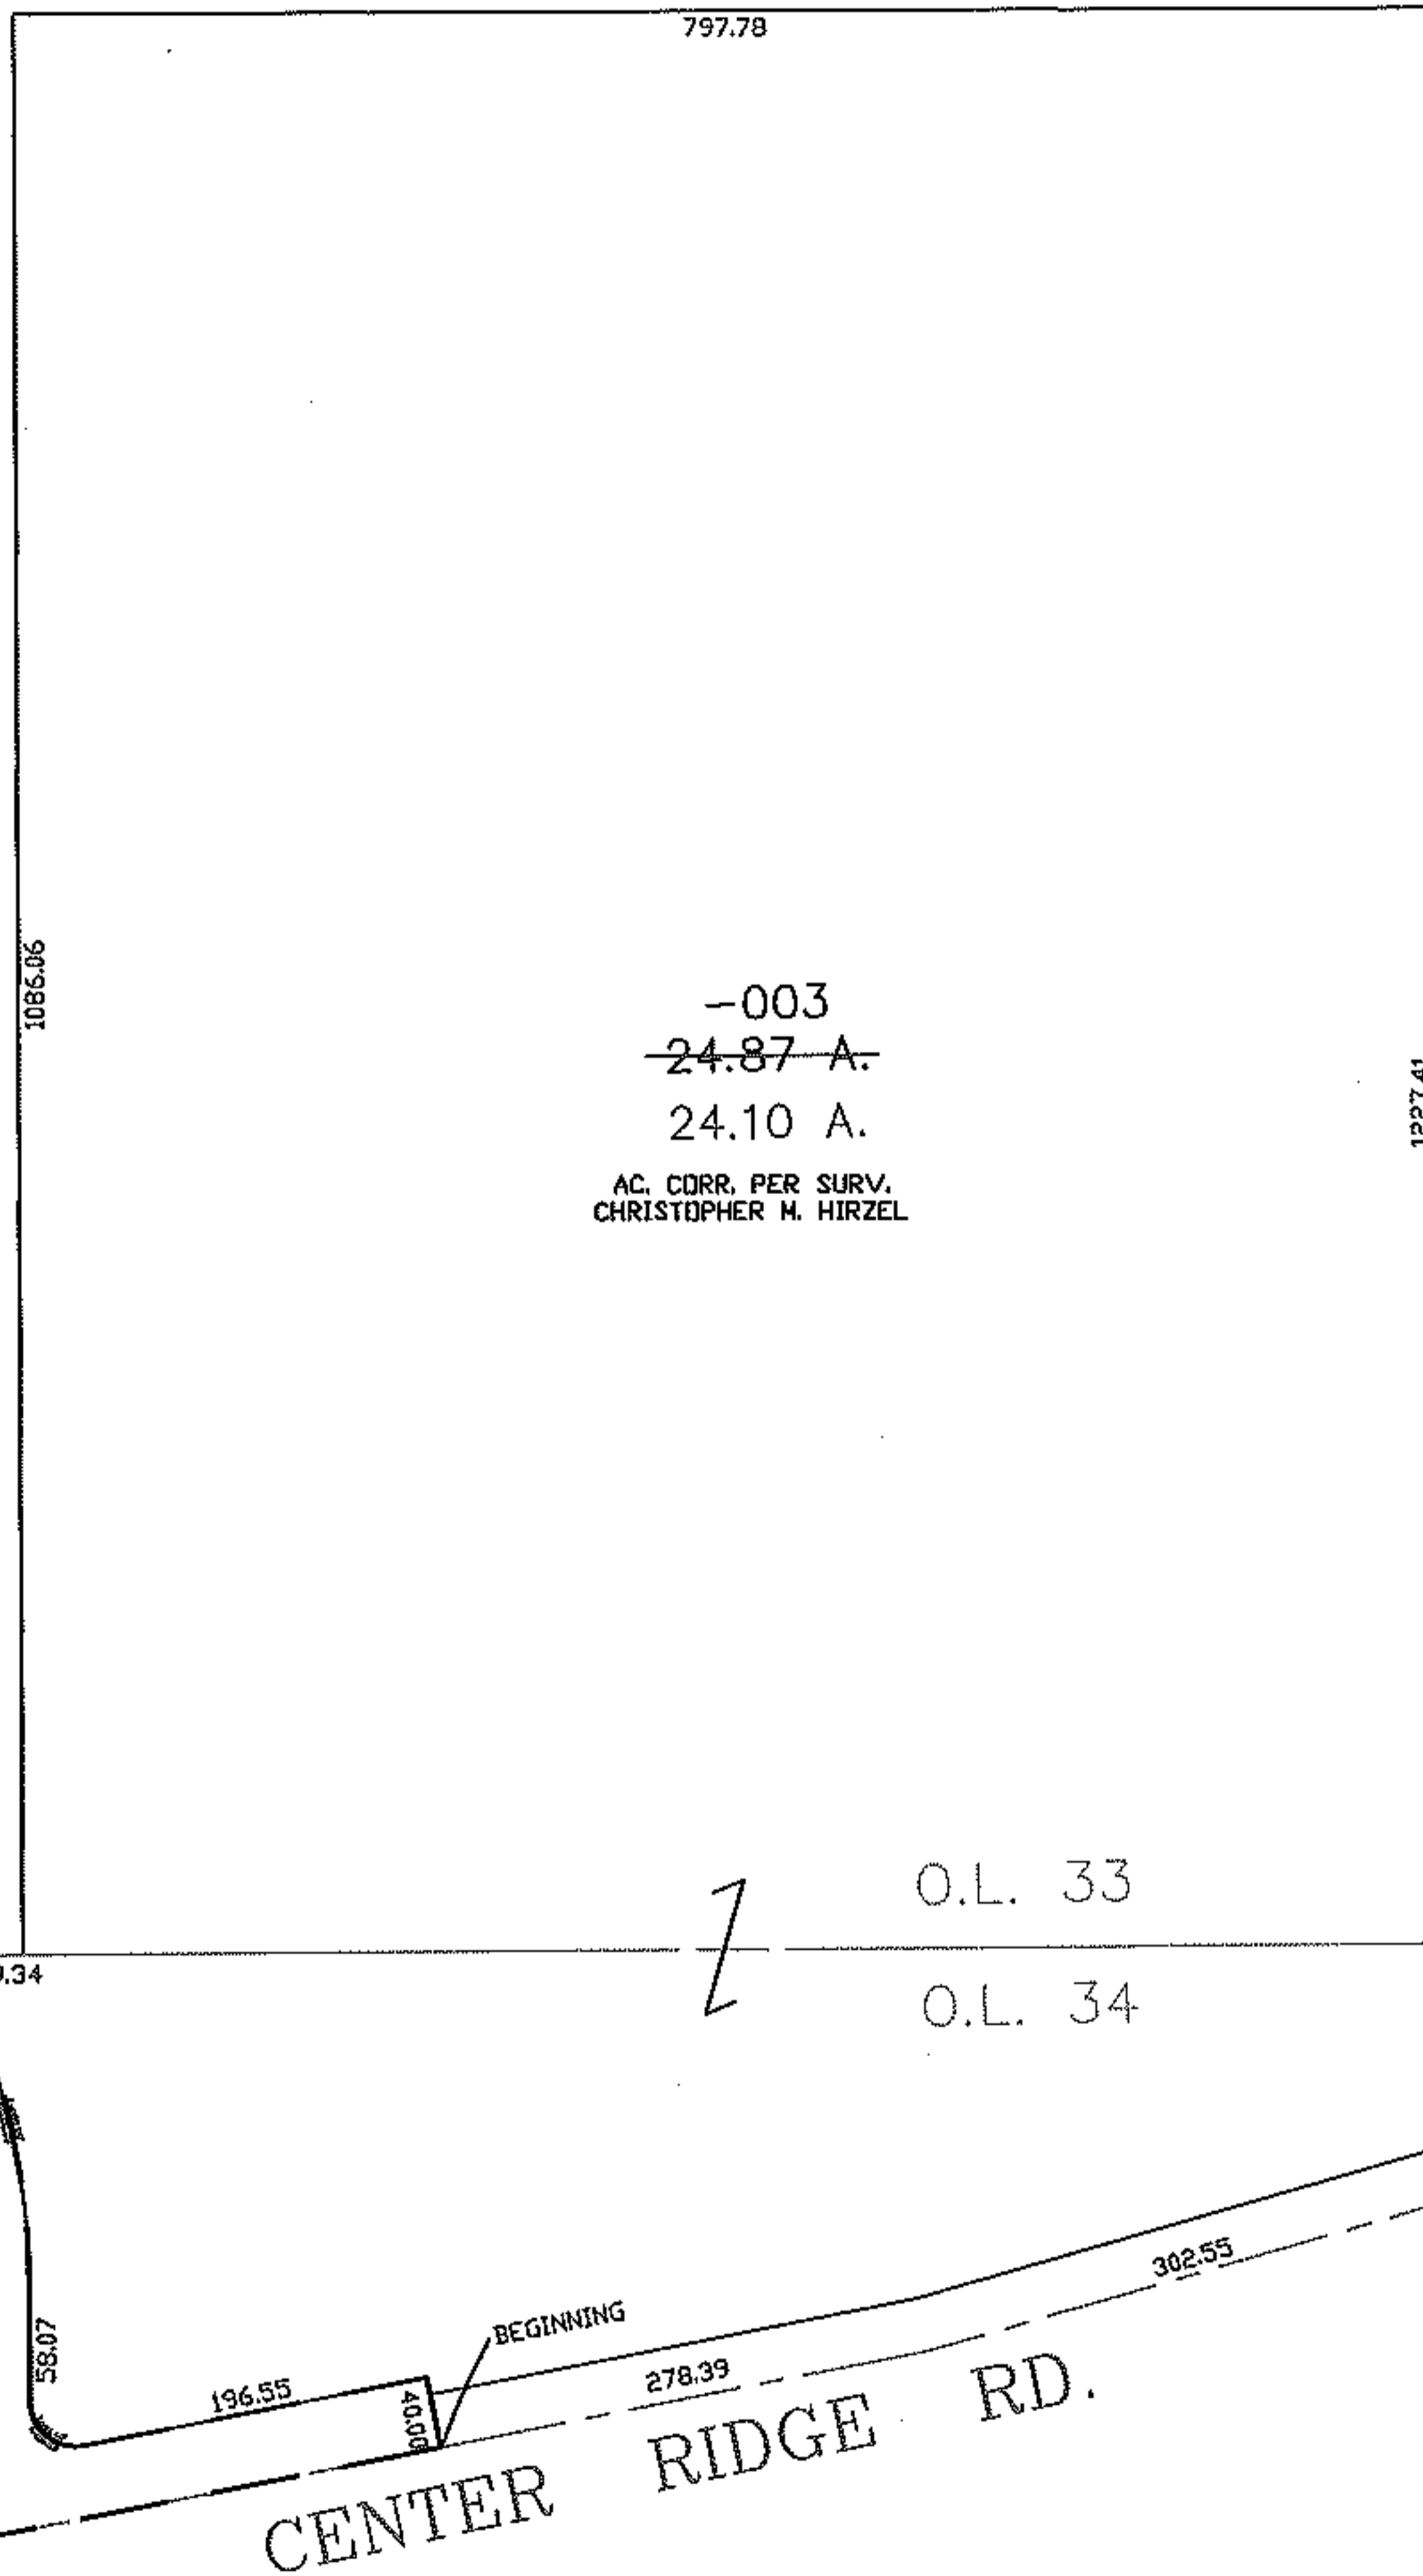


PARENT PARCEL: 07-00-033-101-003

CHILD PARCEL: XX-XX-XXX-XXX-XXX

STARTING POINT: CL OF CENTER RIDGE RD. & EAST LINE OF MEADOW LAKES BLVD. VACATION
& DEDICATION PLAT V. 93 PG. 56

13-02685-C

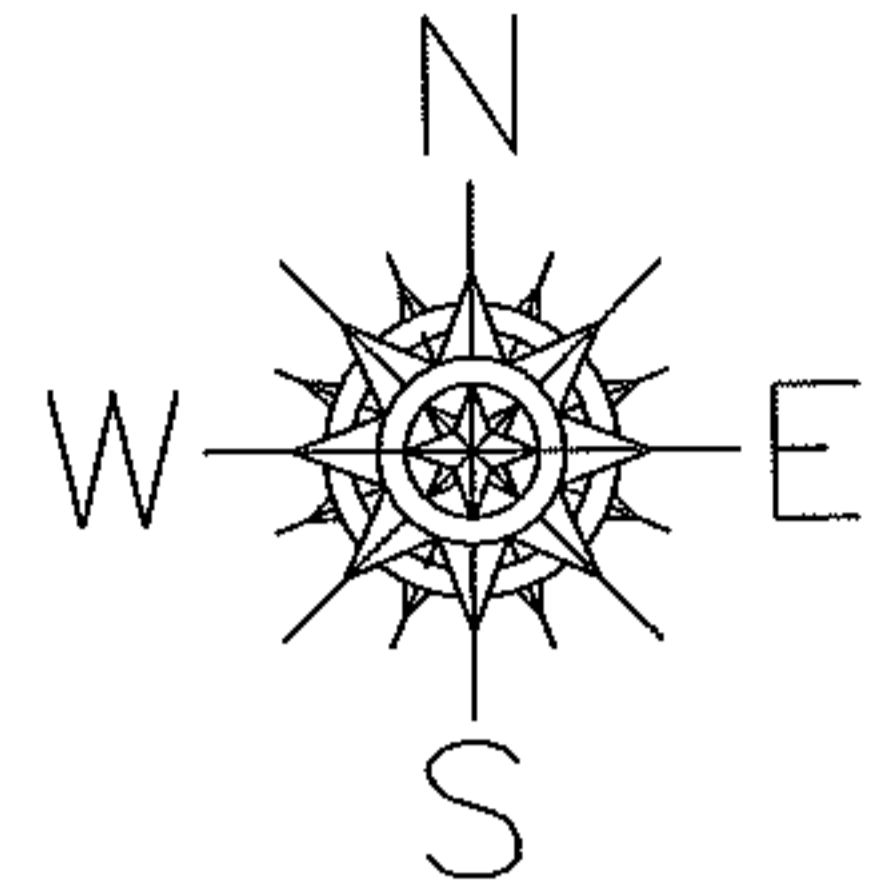

ACREAGE CORRECTION

07-00-033-101-003

~~24.87 A.~~

24.10 A.

AC. CORR. PER SURV.
CHRISTOPHER M. HIRZEL

-003
~~24.87 A.~~
24.10 A.
AC. CORR. PER SURV.
CHRISTOPHER M. HIRZEL

MEADOW LAKES
BLVD.

CENTER RIDGE RD.



SPLITS/DEEDS PROCESSED
LORAIN COUNTY TAX MAP DEPARTMENT
226 MIDDLE AVE. ELYRIA, OHIO

SURVEYED BY: CHRISTOPHER M. HIRZEL

CLOSURE: 0.01 : 10.000

MAP PAGE(S): 7-00-033 & -034

APPROVED BY: TJS DATE: 3/13/13

SCALE: 1" = 200' PRIOR INSTRUMENT: 20090297996