




MASTER

PARENT PARCEL: 10-00-008-101-015, -016-, -017

09-02686

CHILD PARCEL: 10-00-008-101-030

STARTING POINT: CENTERLINE OF OBERLIN-ELYRIA RD & WEST RIVER RD

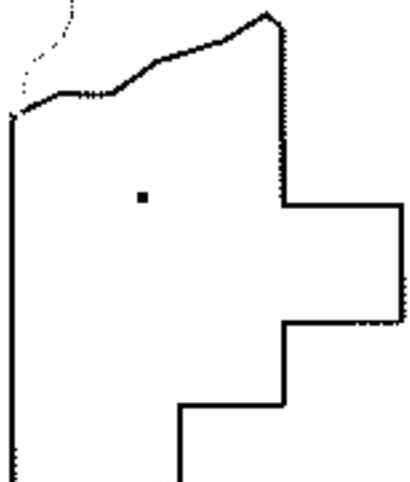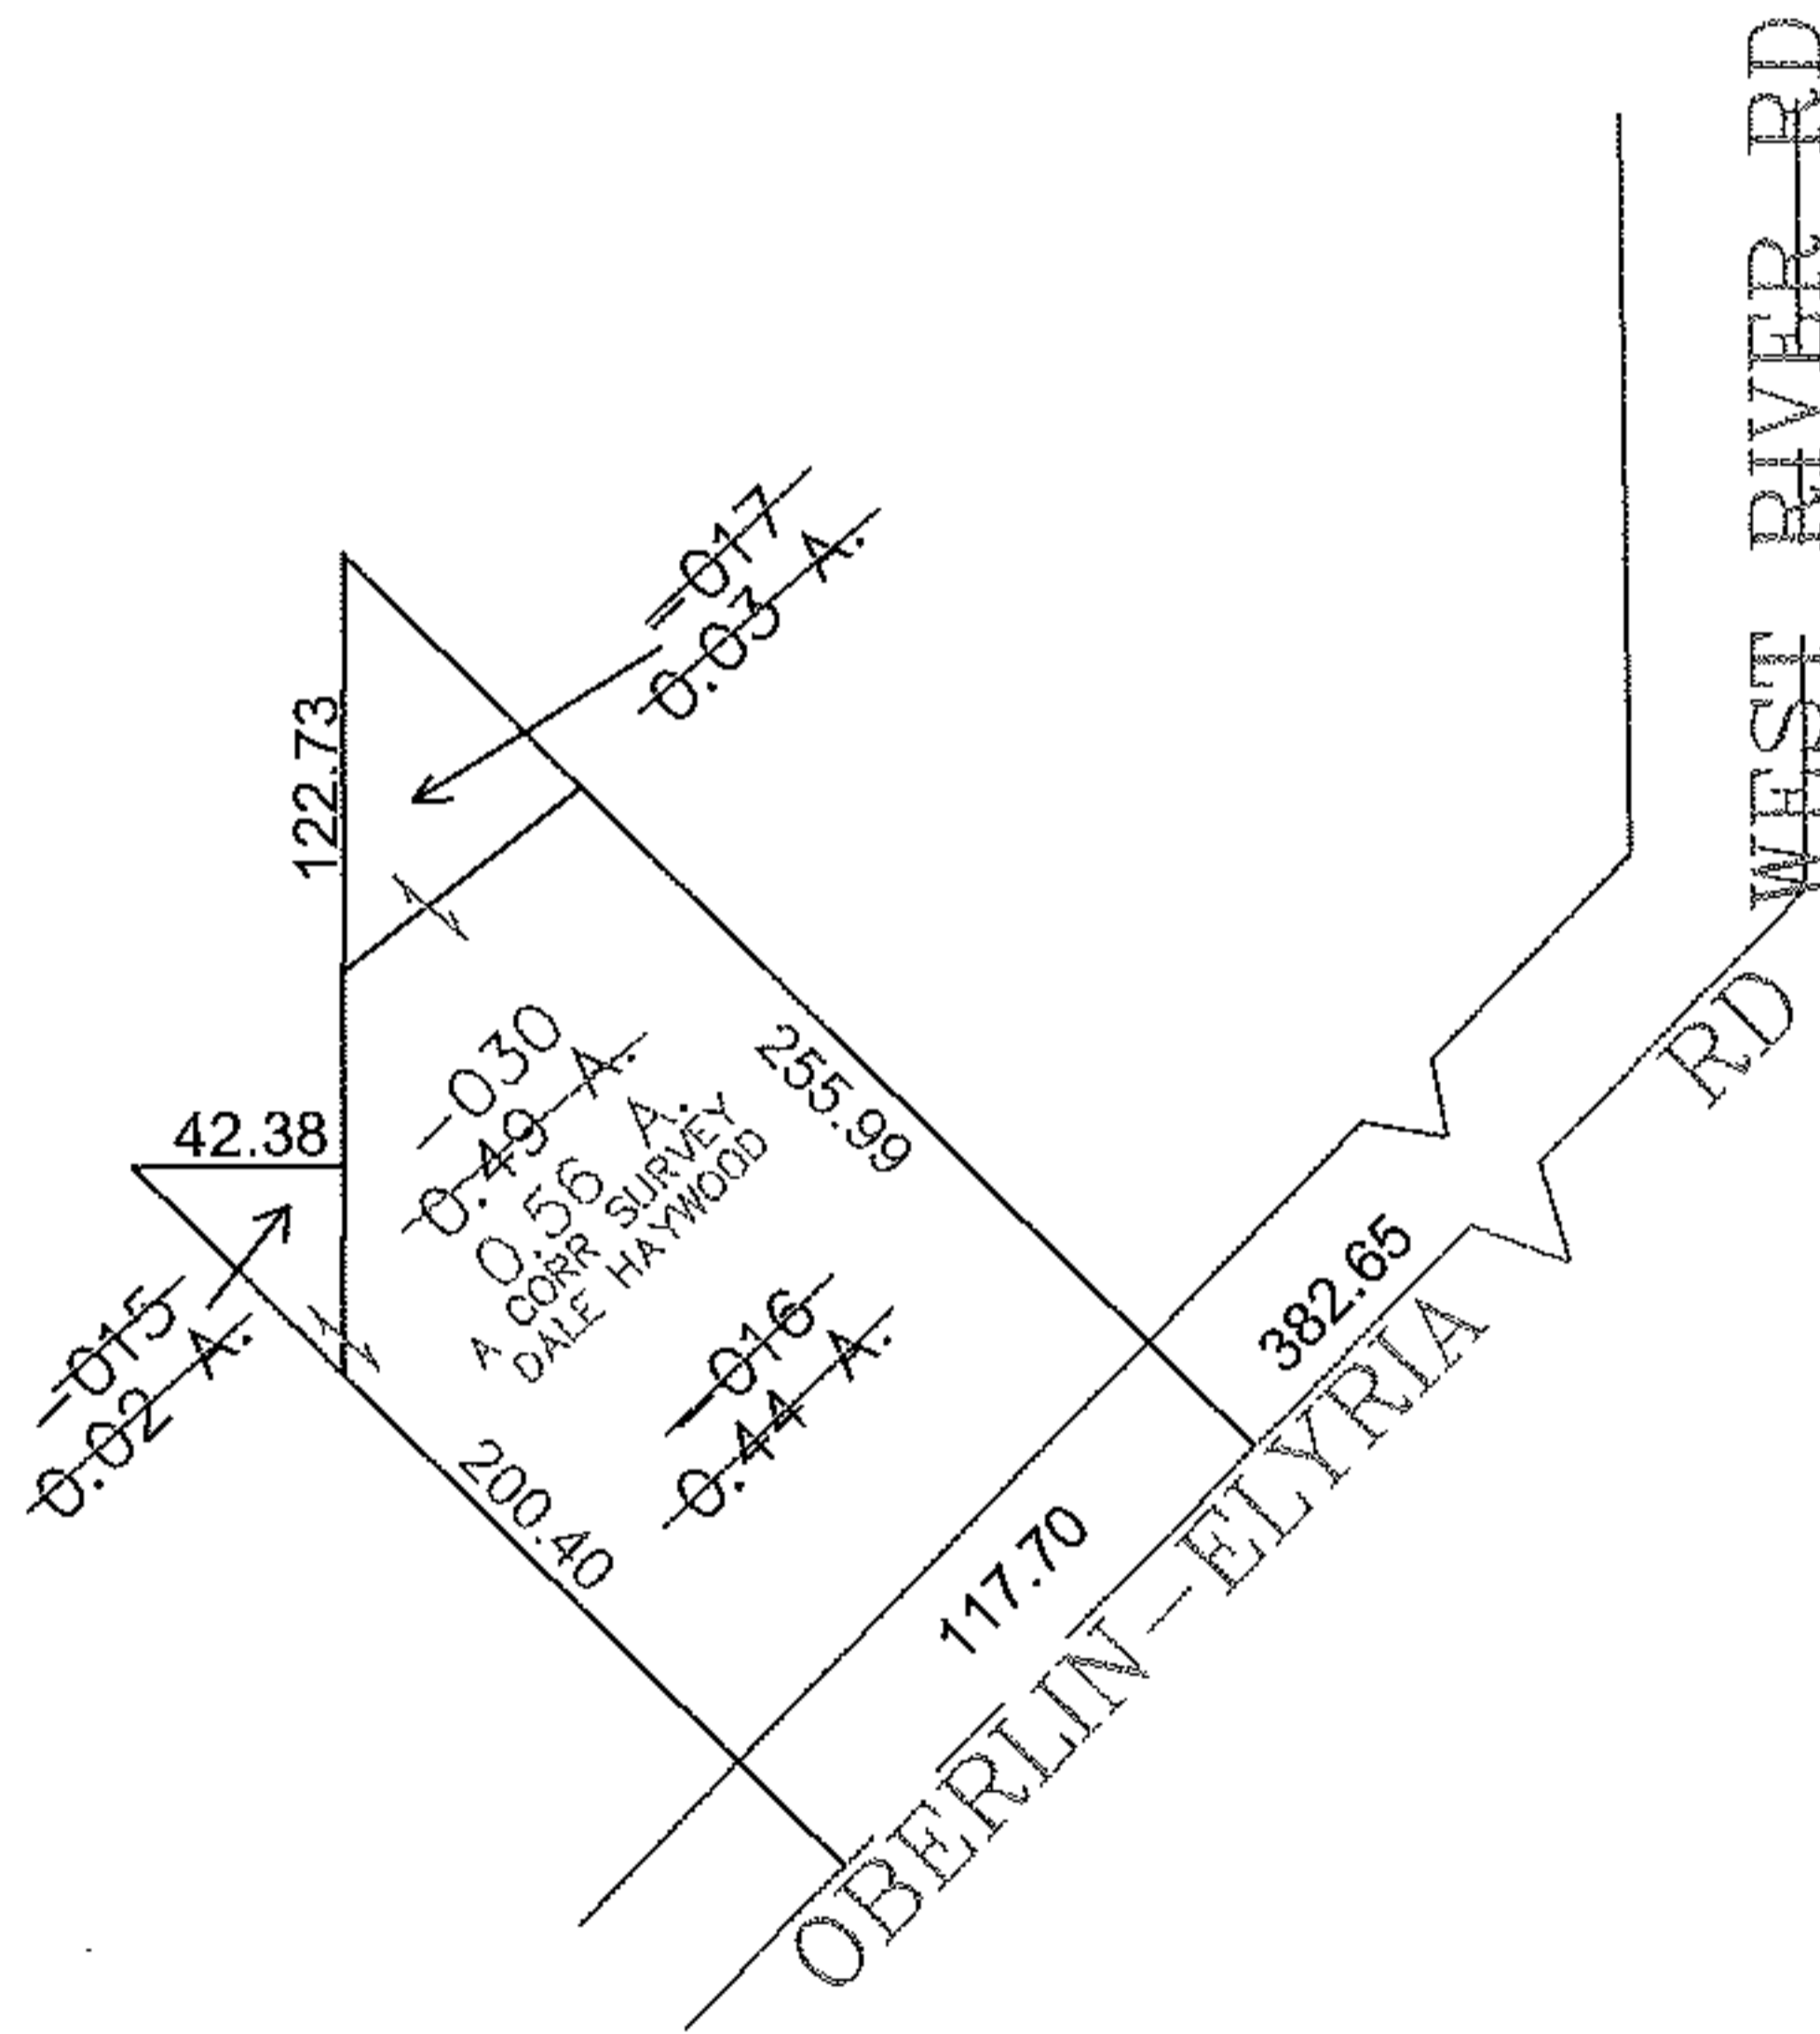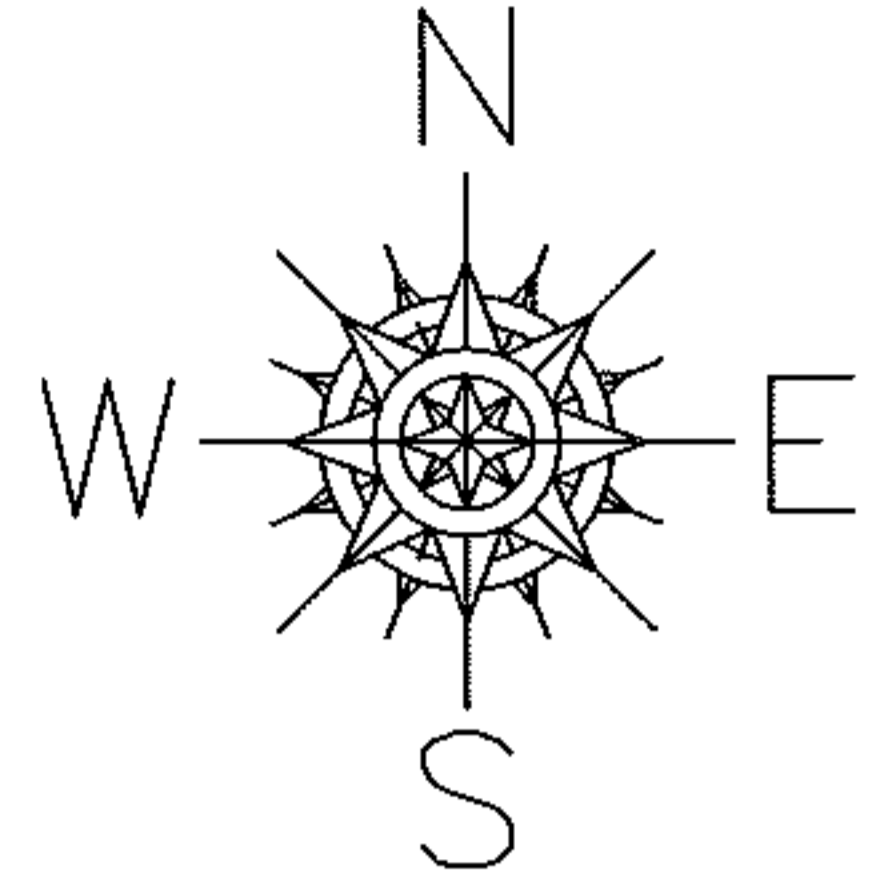

SPLITS/DEEDS PROCESSED

LORAIN COUNTY TAX MAP DEPARTMENT
226 MIDDLE AVE. ELYRIA, OHIO

SURVEYED BY: DALE HAYWOOD

CLOSURE: 0.00 : 10,000

MAP PAGE(S): 10-00-008-A

APPROVED BY: JAH DATE: 4-21-09

SCALE: 1"= 100 PRIOR INST.: 20090290154