




EASTER

PARENT PARCEL: 04-00-015-110-052 035 067 008 THRU 010 050 068 040 069

CHILD PARCEL: 04-00-015-110-267 THRU -272

STARTING POINT: CENTERLINE OF CENTER RD & DETROIT RD

09-02688

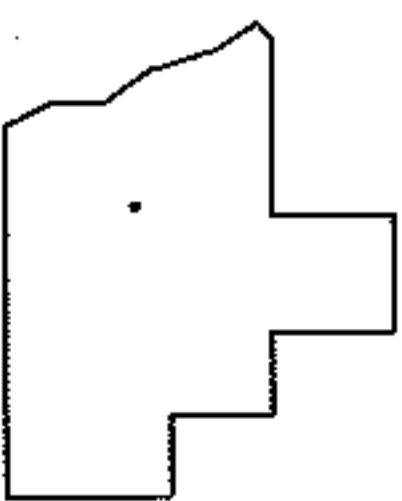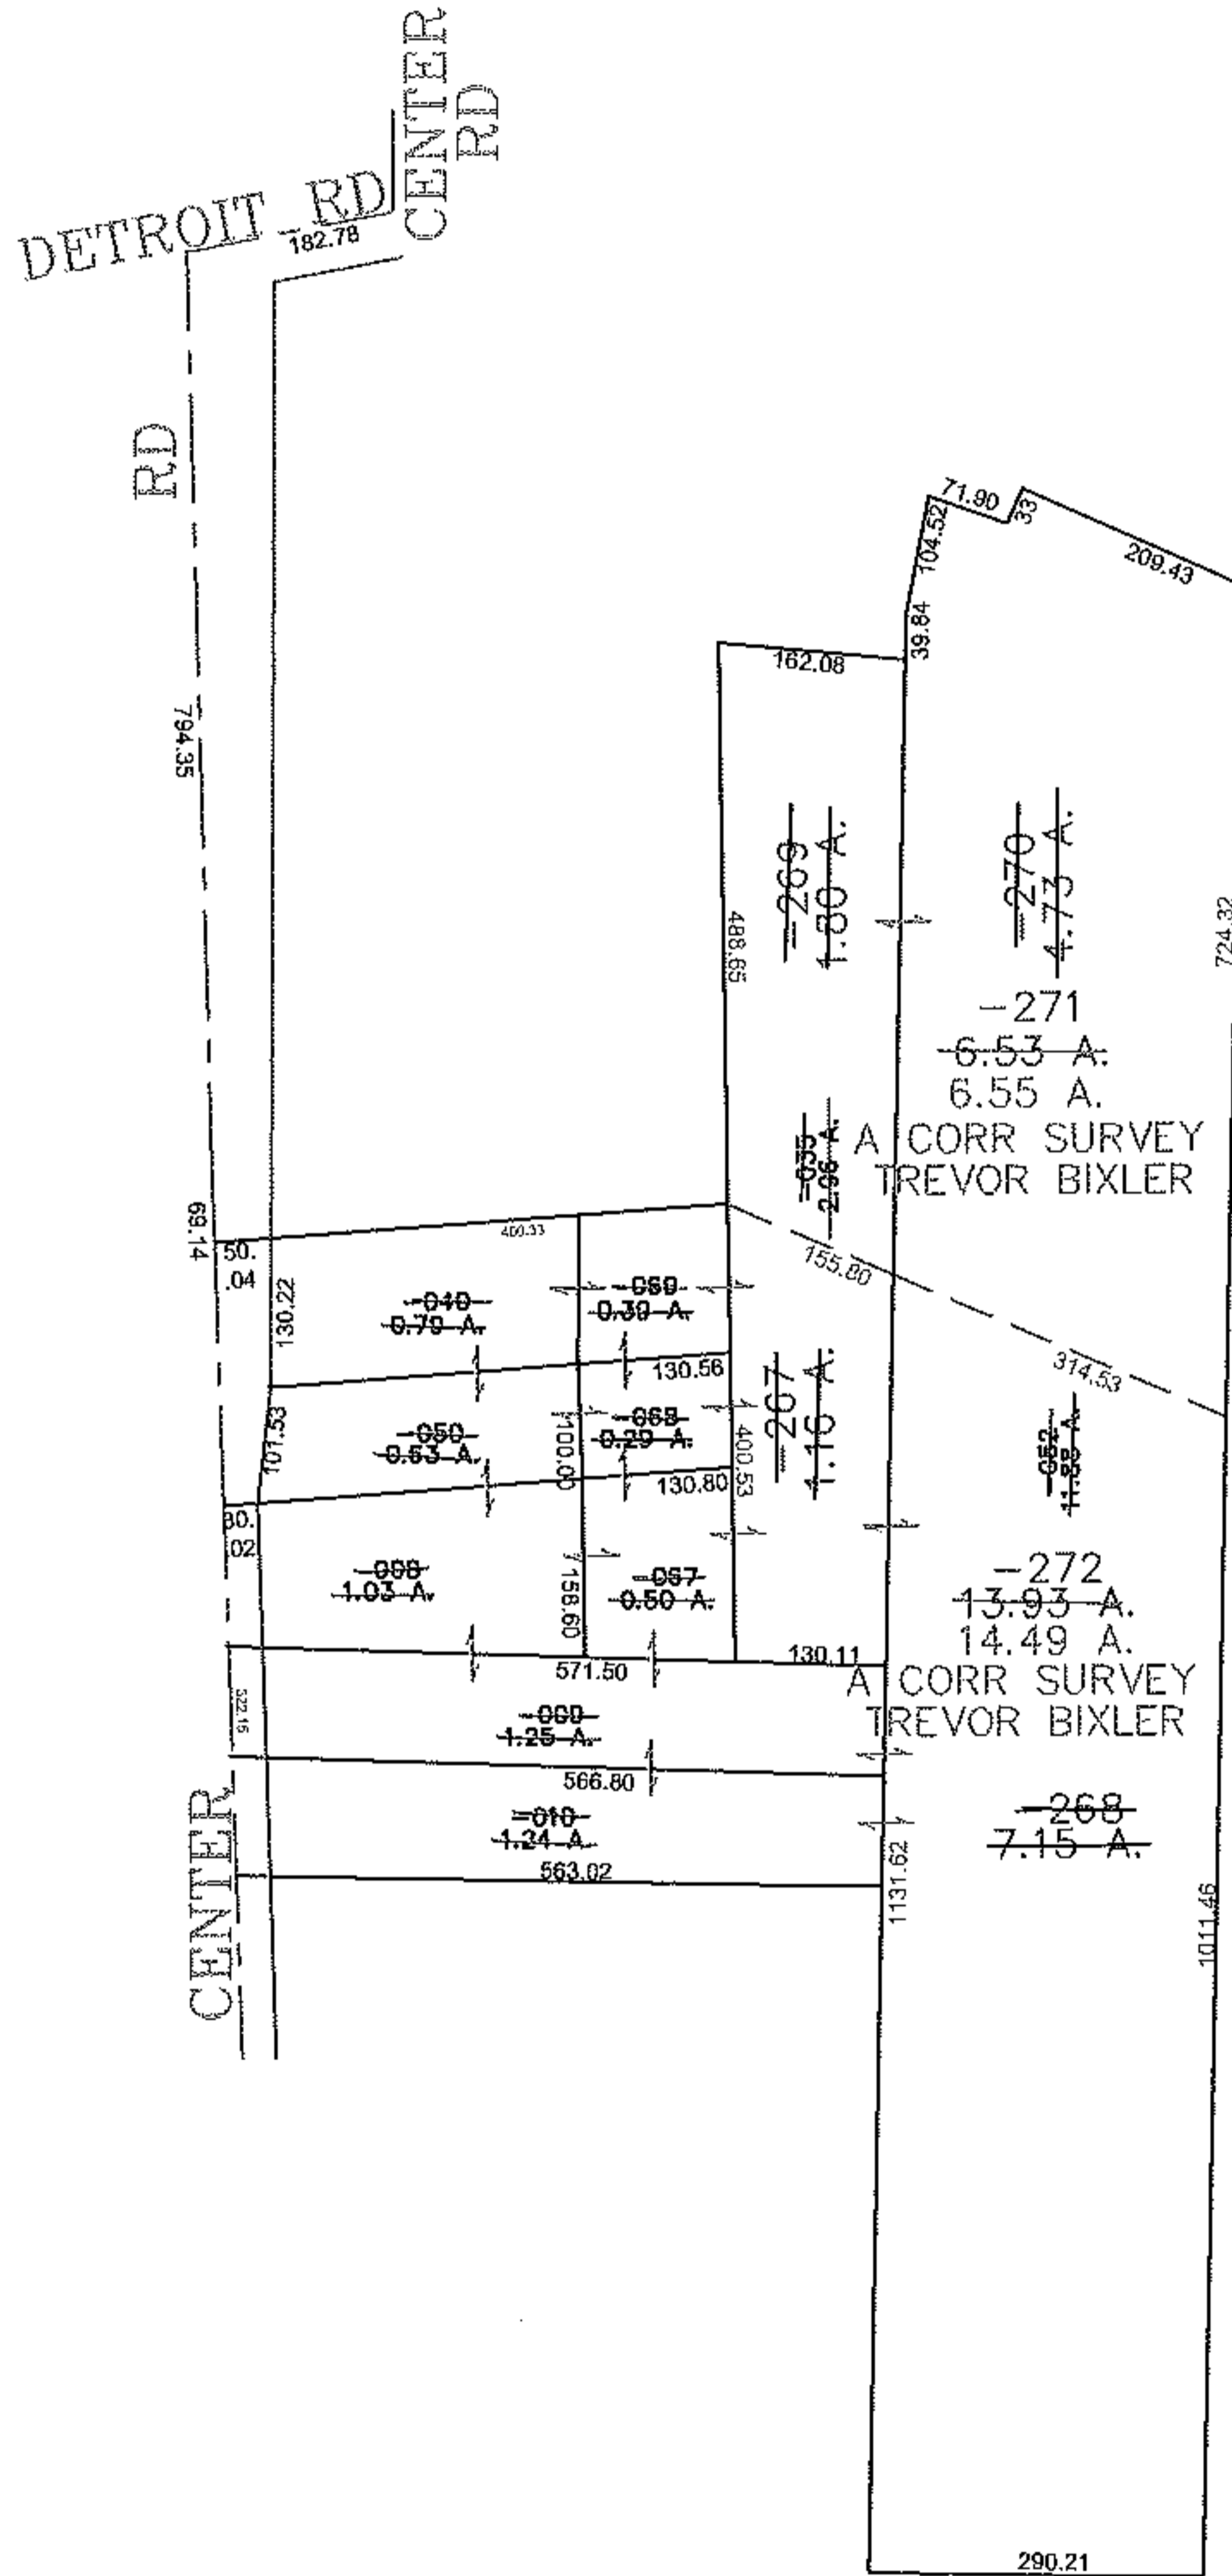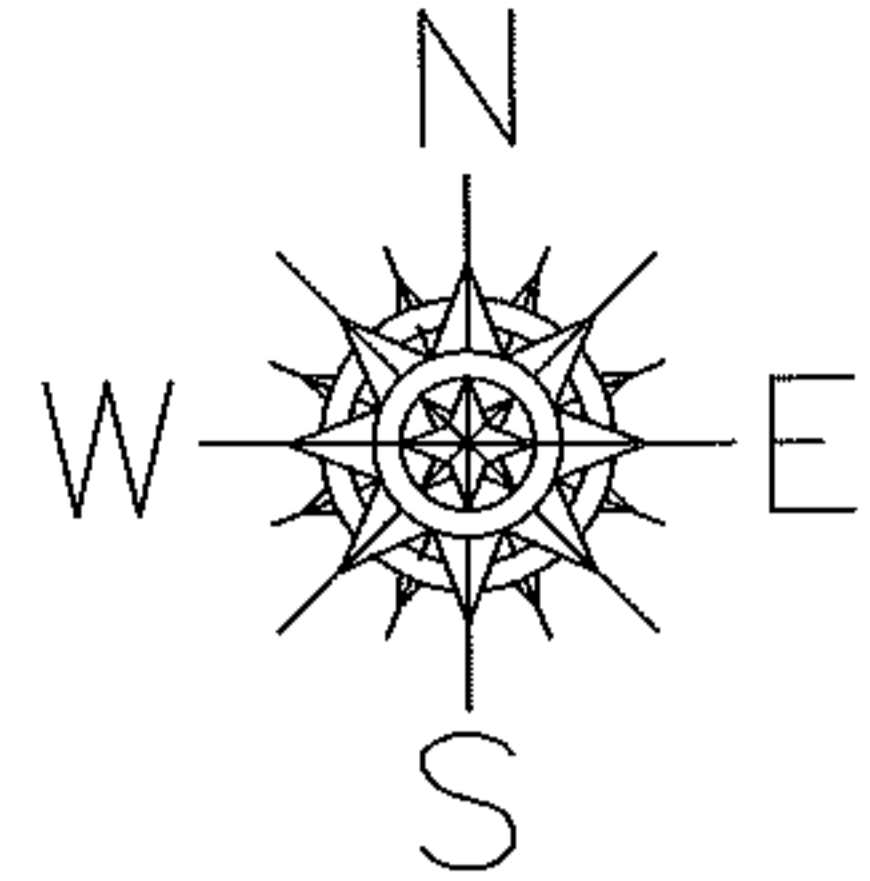

**SPLITS/DEEDS PROCESSED**  
 LORAIN COUNTY TAX MAP DEPARTMENT  
 226 MIDDLE AVE. ELYRIA, OHIO

SURVEYED BY: TREVOR BIXLER  
 CLOSURE: 0.00 : 10.000  
 MAP PAGE(S): 04-00-015-C  
 APPROVED BY: JAH DATE: 4-27-09  
 SCALE: 1" = 300 PRIOR INSTRUMENT: 20080268241