


PARENT PARCEL: 04-00-029-000-042

CHILD PARCEL: XX-XX-XXX-XXX-XXX

STARTING POINT: CL OF LEAR-NAGLE RD. & N.W. CORNER OF THE SECOND PARCEL

CONVEYED TO FRANK KREBS BY DV 115/7

13-02689-C

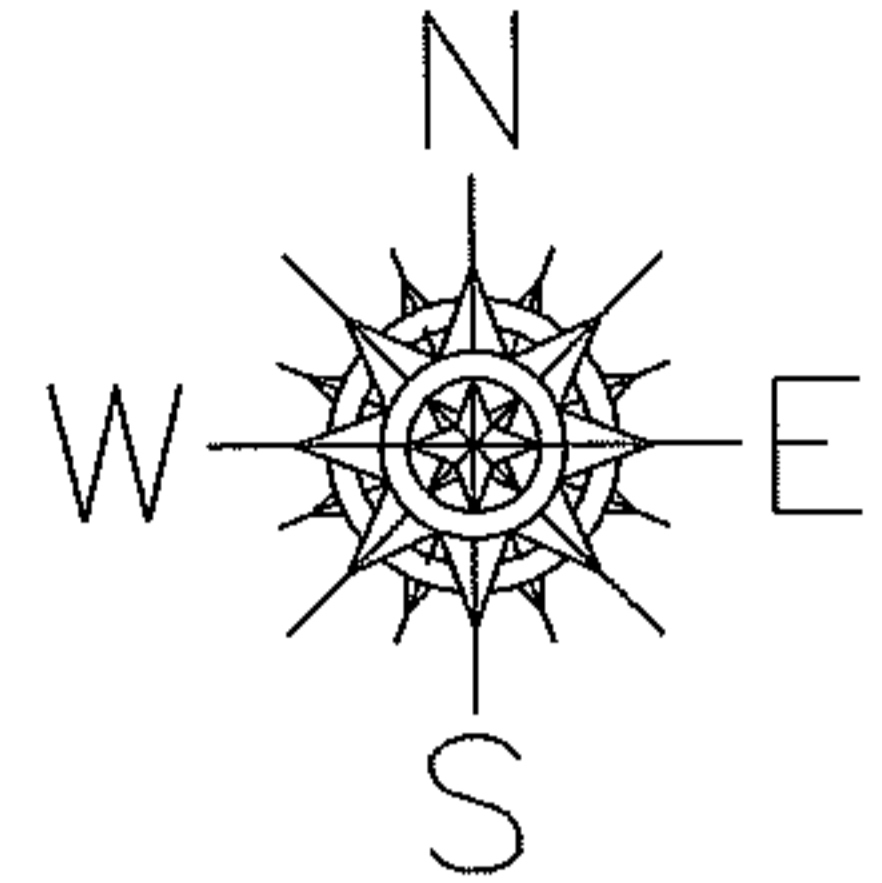


ACREAGE CORRECTION

04-00-029-000-042

~~3.06 A.~~

3.05 A.

CORR. PER DEED
DV 1226/956

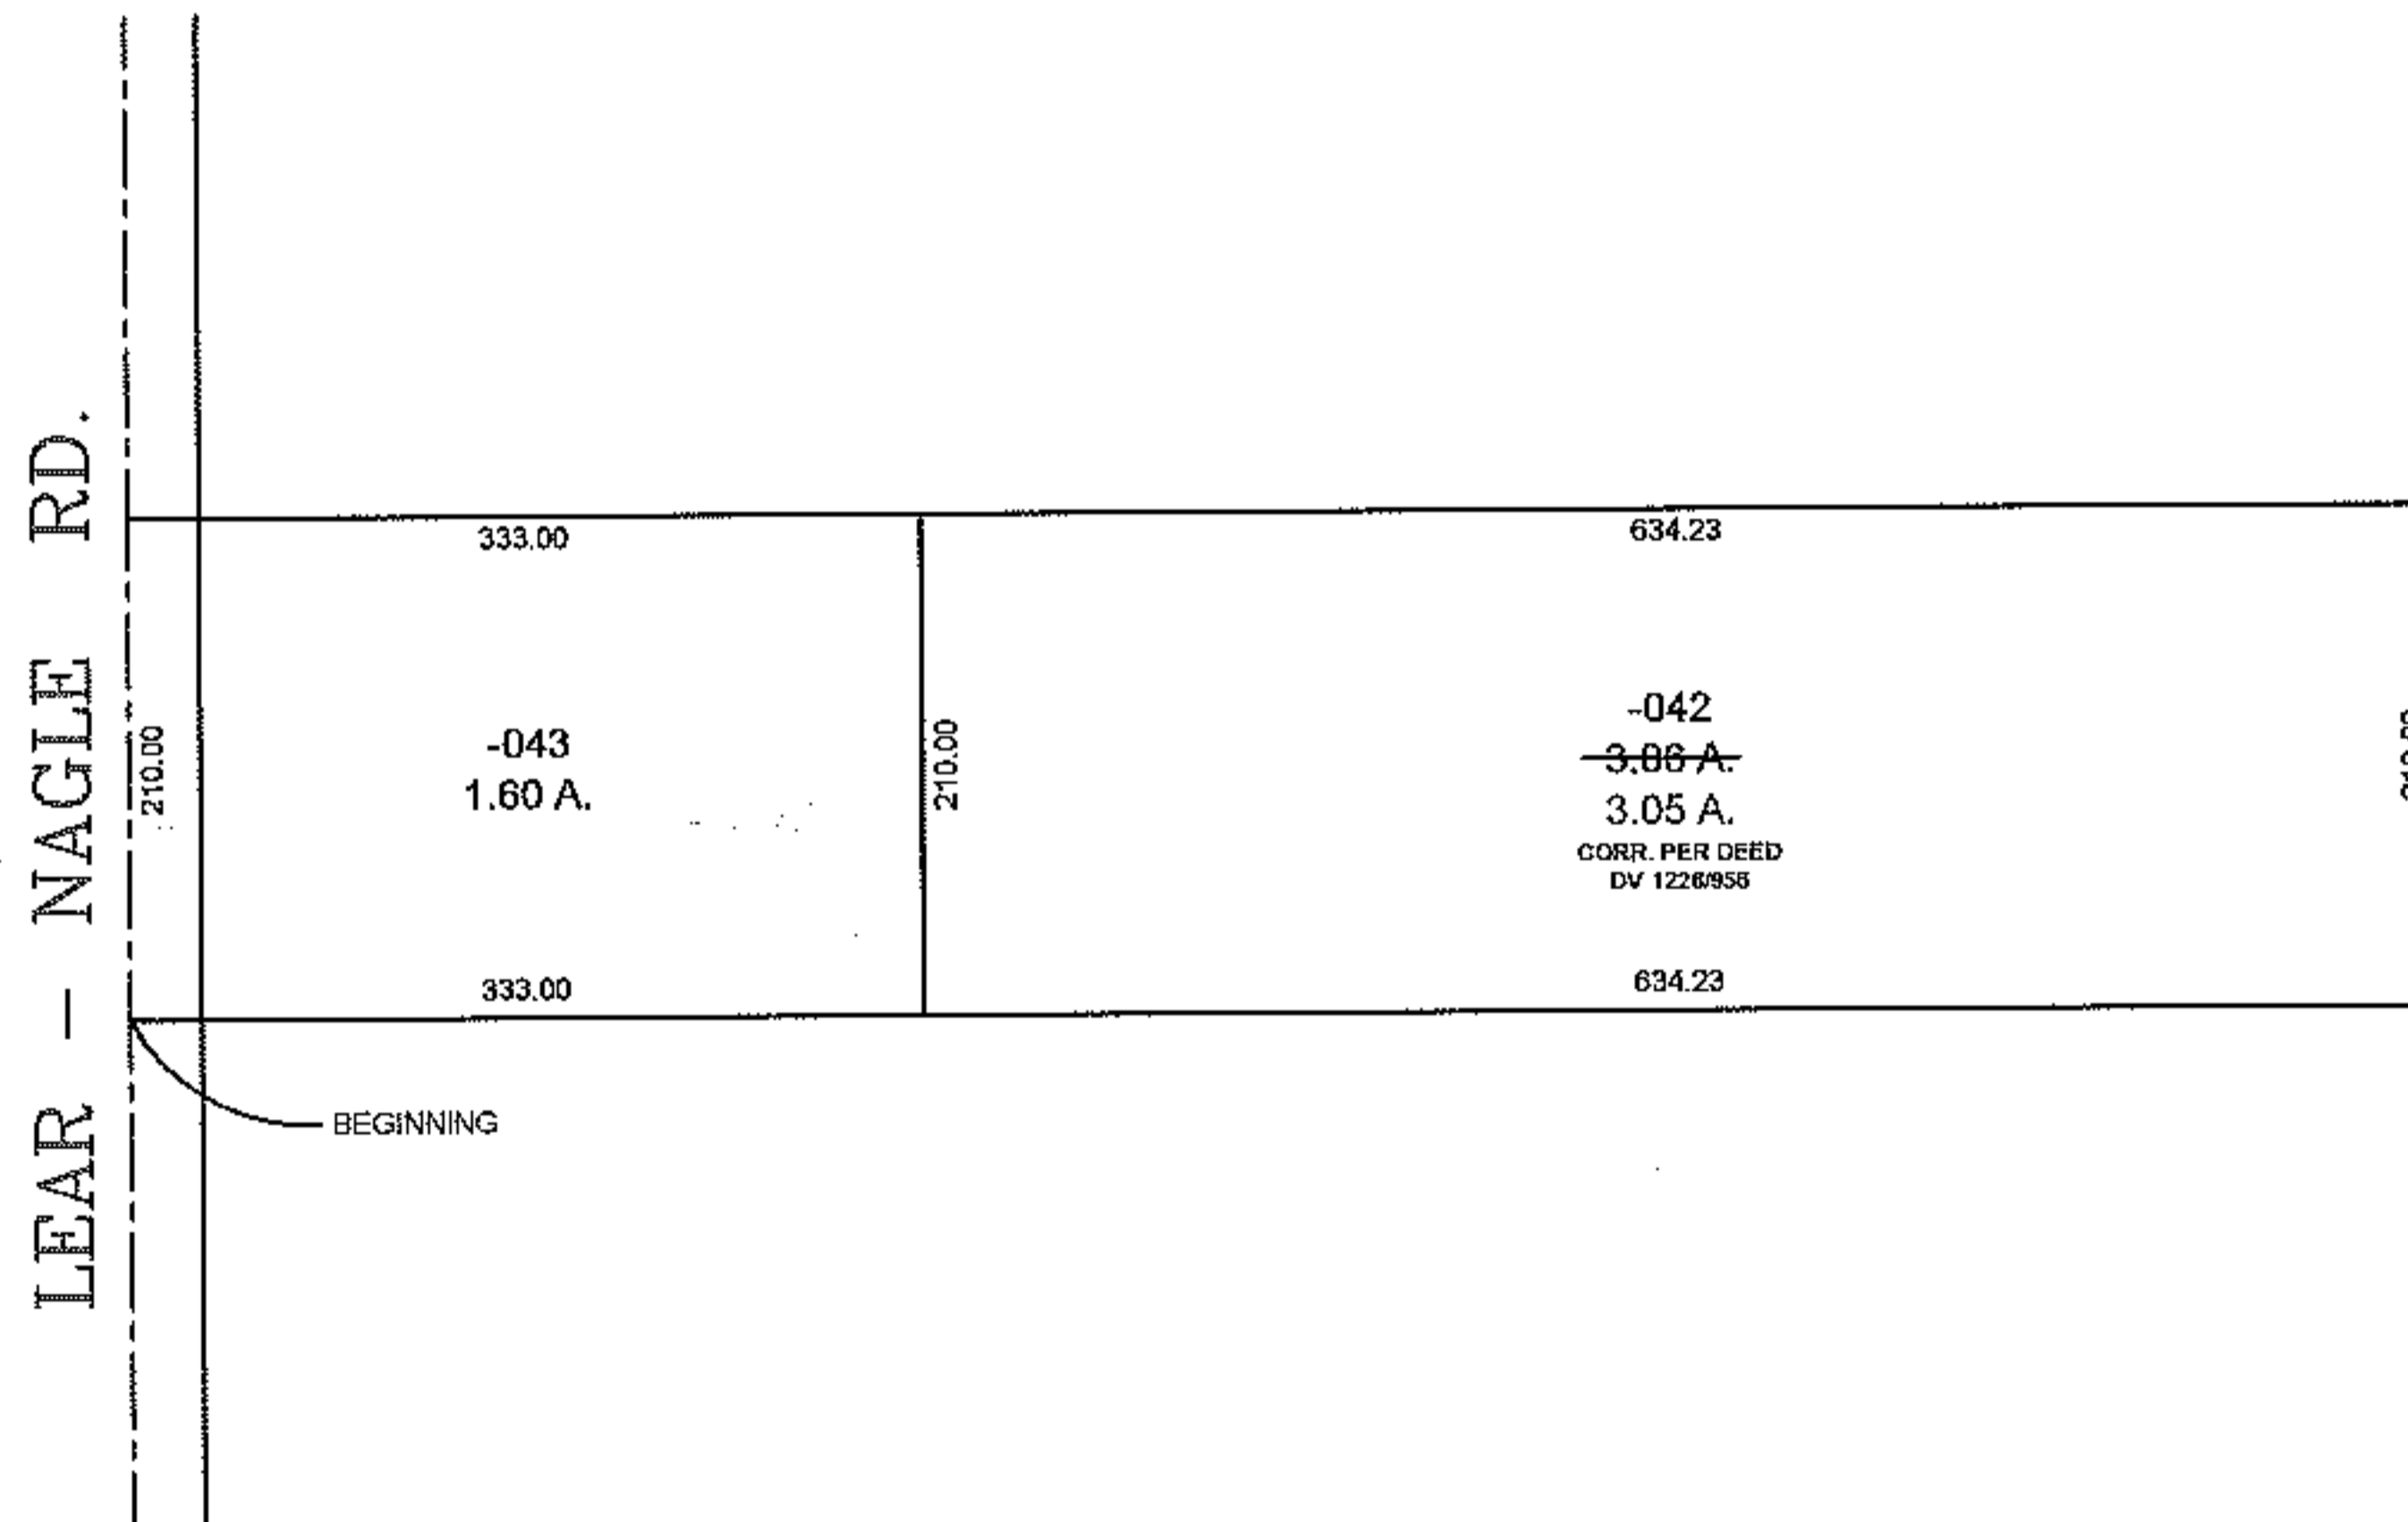

SPLITS/DEEDS PROCESSED

LORAIN COUNTY TAX MAP DEPARTMENT
226 MIDDLE AVE. ELYRIA, OHIO

SURVEYED BY: NONE

CLOSURE: NONE

MAP PAGE(S): 04-00-029

APPROVED BY: TJS DATE: 3/18/13

SCALE: 1" = 200 PRIOR INSTRUMENT: DV 1226/956