
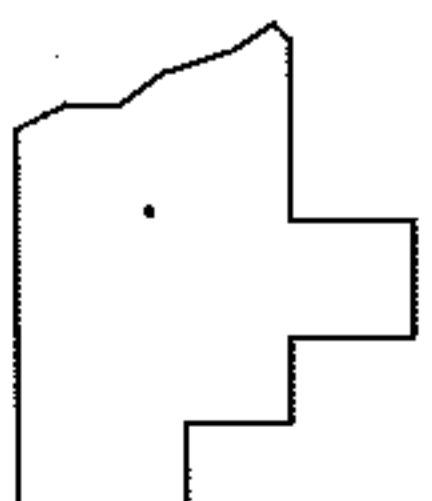
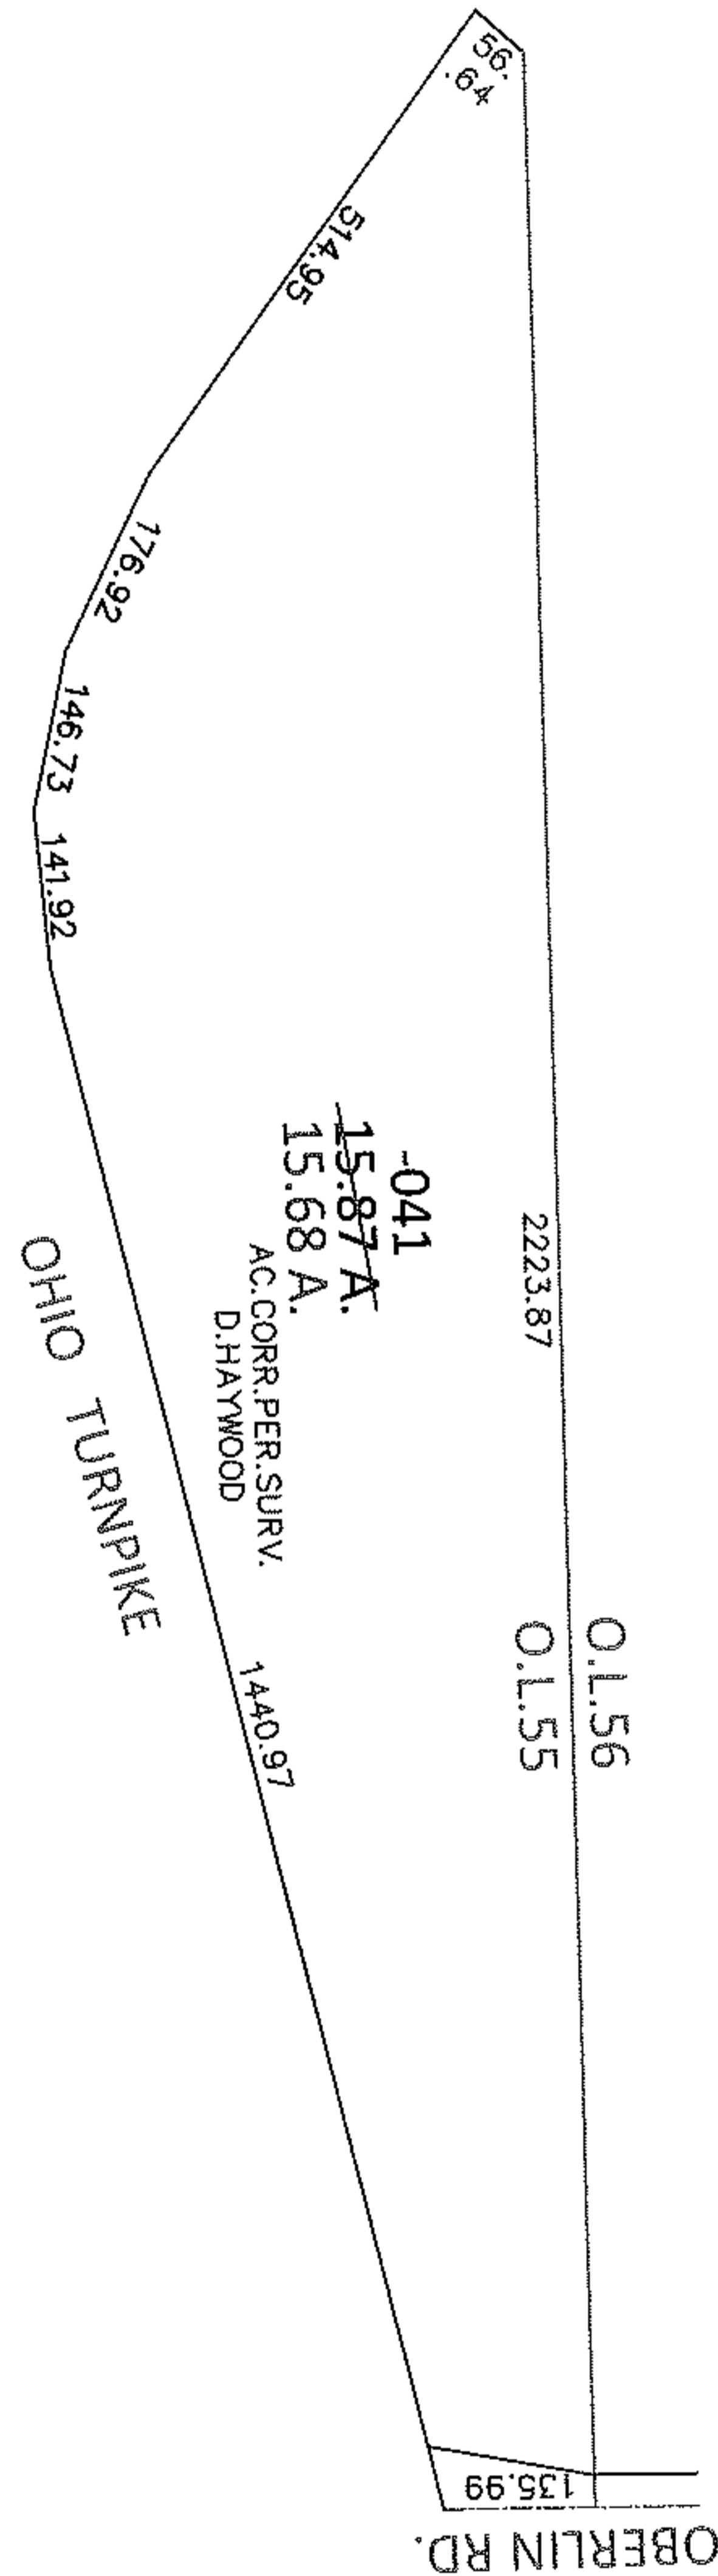


PARENT PARCEL: 05-00-055-000-041

CHILD PARCEL: _____

13-02693-D

STARTING POINT: INTERSECTION OF NORTH LINE OF O.L.55 AND C/L OF OBERLIN RD.

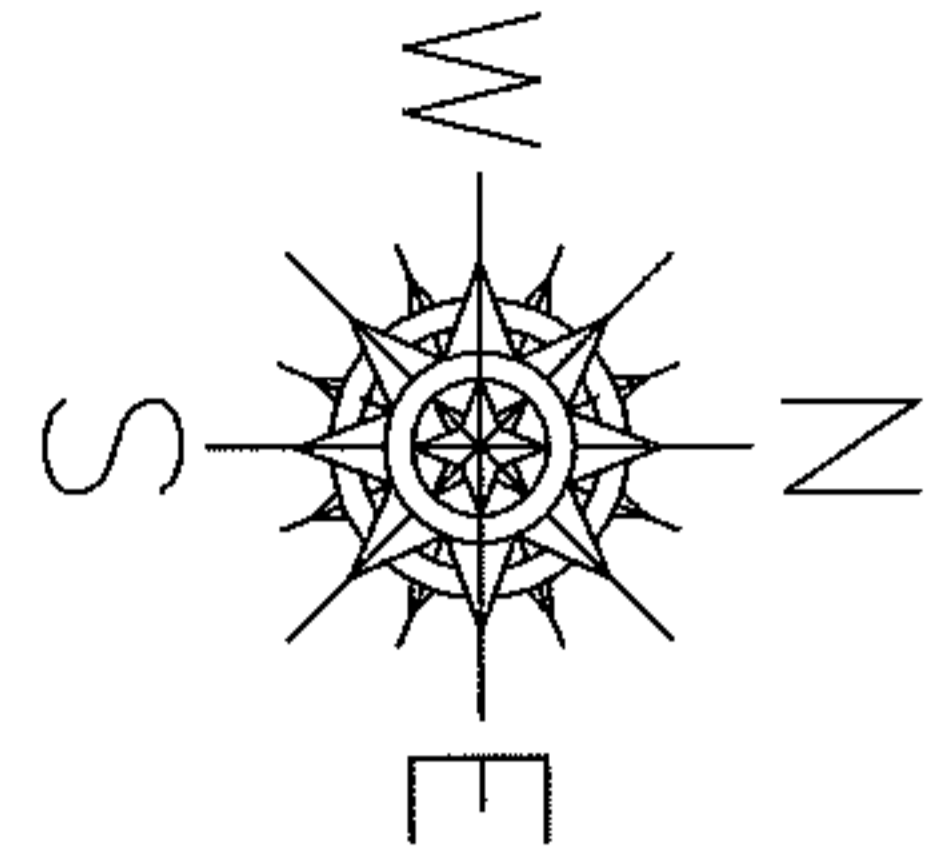

SPLITS/DEEDS PROCESSED

LORAIN COUNTY TAX MAP DEPARTMENT
226 MIDDLE AVE. ELYRIA, OHIO

SURVEYED BY: DALE R. HAYWOOD

CLOSURE: .01:10,000

MAP PAGE(S): 5-G

APPROVED BY: RRM DATE: 3-20-13

SCALE: 1" = 300 PRIOR INST.: 19970479527