



RASTER

PARENT PARCEL: 04-00-015-103-050


CHILD PARCEL: XX-XX-XXX-XXX-XXX

STARTING POINT: CENTERLINE OF DETROIT RD & MIDDLETON RD

09-02693

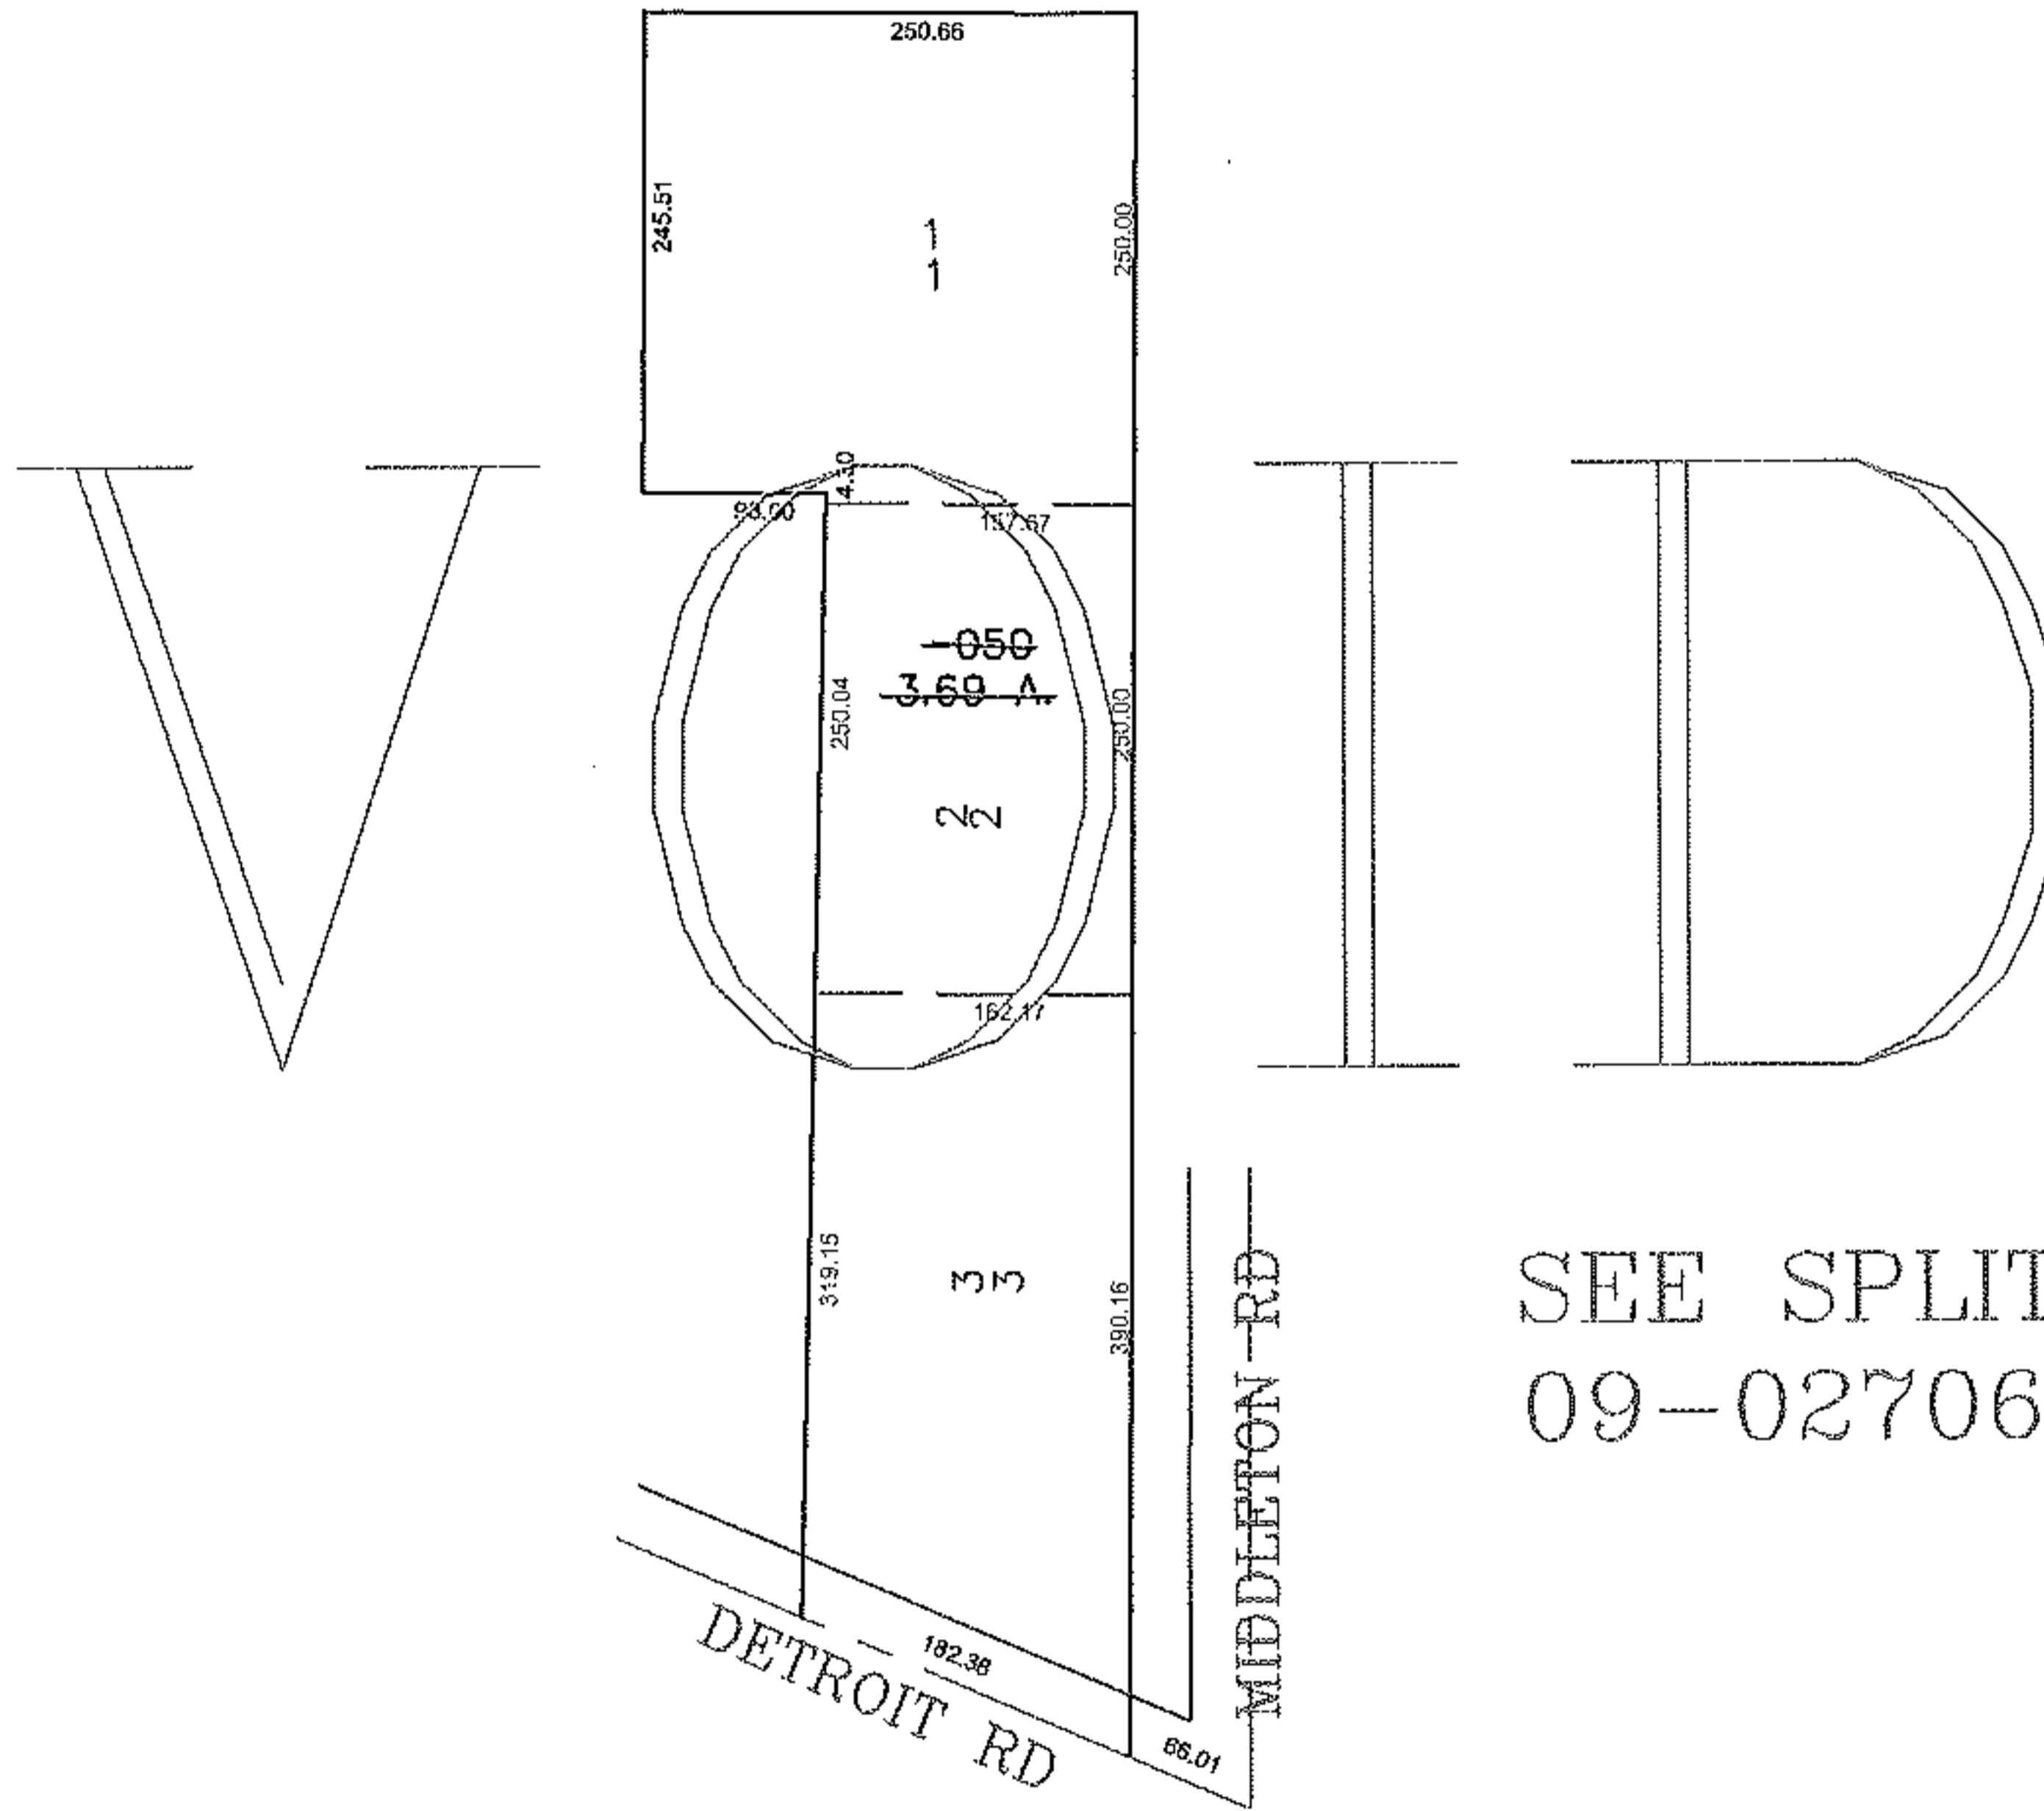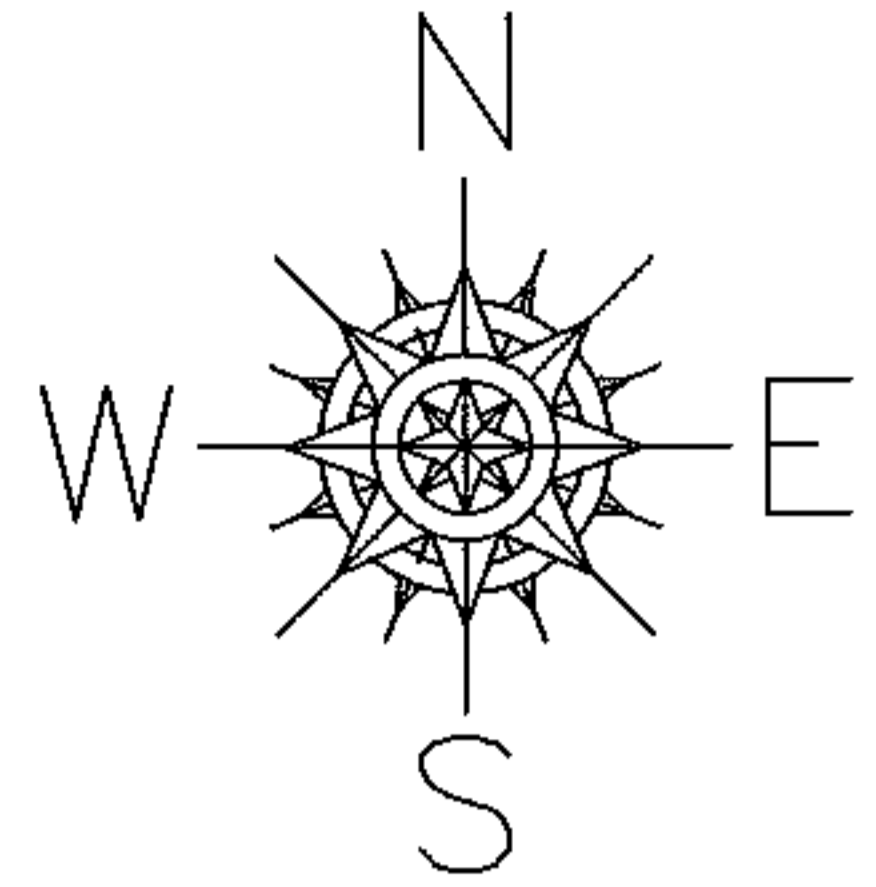

SEE SPLIT
09-02706

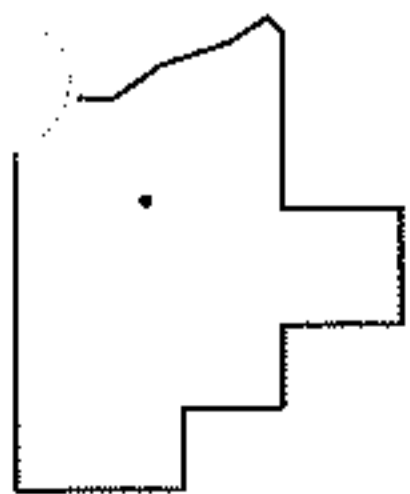

SPLITS/DEEDS PROCESSED
LORAIN COUNTY TAX MAP DEPARTMENT
226 MIDDLE AVE. ELYRIA, OHIO

SURVEYED BY: MIKE SPELLACY
CLOSURE: 0.00 : 10.000
MAP PAGE(S): 04-00-015-D
APPROVED BY: JAH DATE: XX/XX/XX
SCALE: 1" = 200 PRIOR INSTRUMENT: DV XXXX/XXX