




RASTER

PARENT PARCEL: 04-00-010-113-102, -042

CHILD PARCEL: 04-00-010-113-193

STARTING POINT: CENTERLINE OF FRENCH CREEK RD & O.L. 10

09-02694

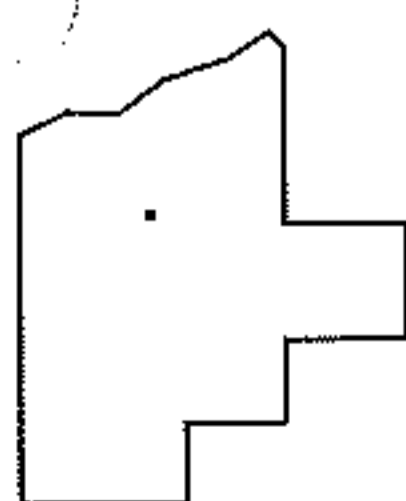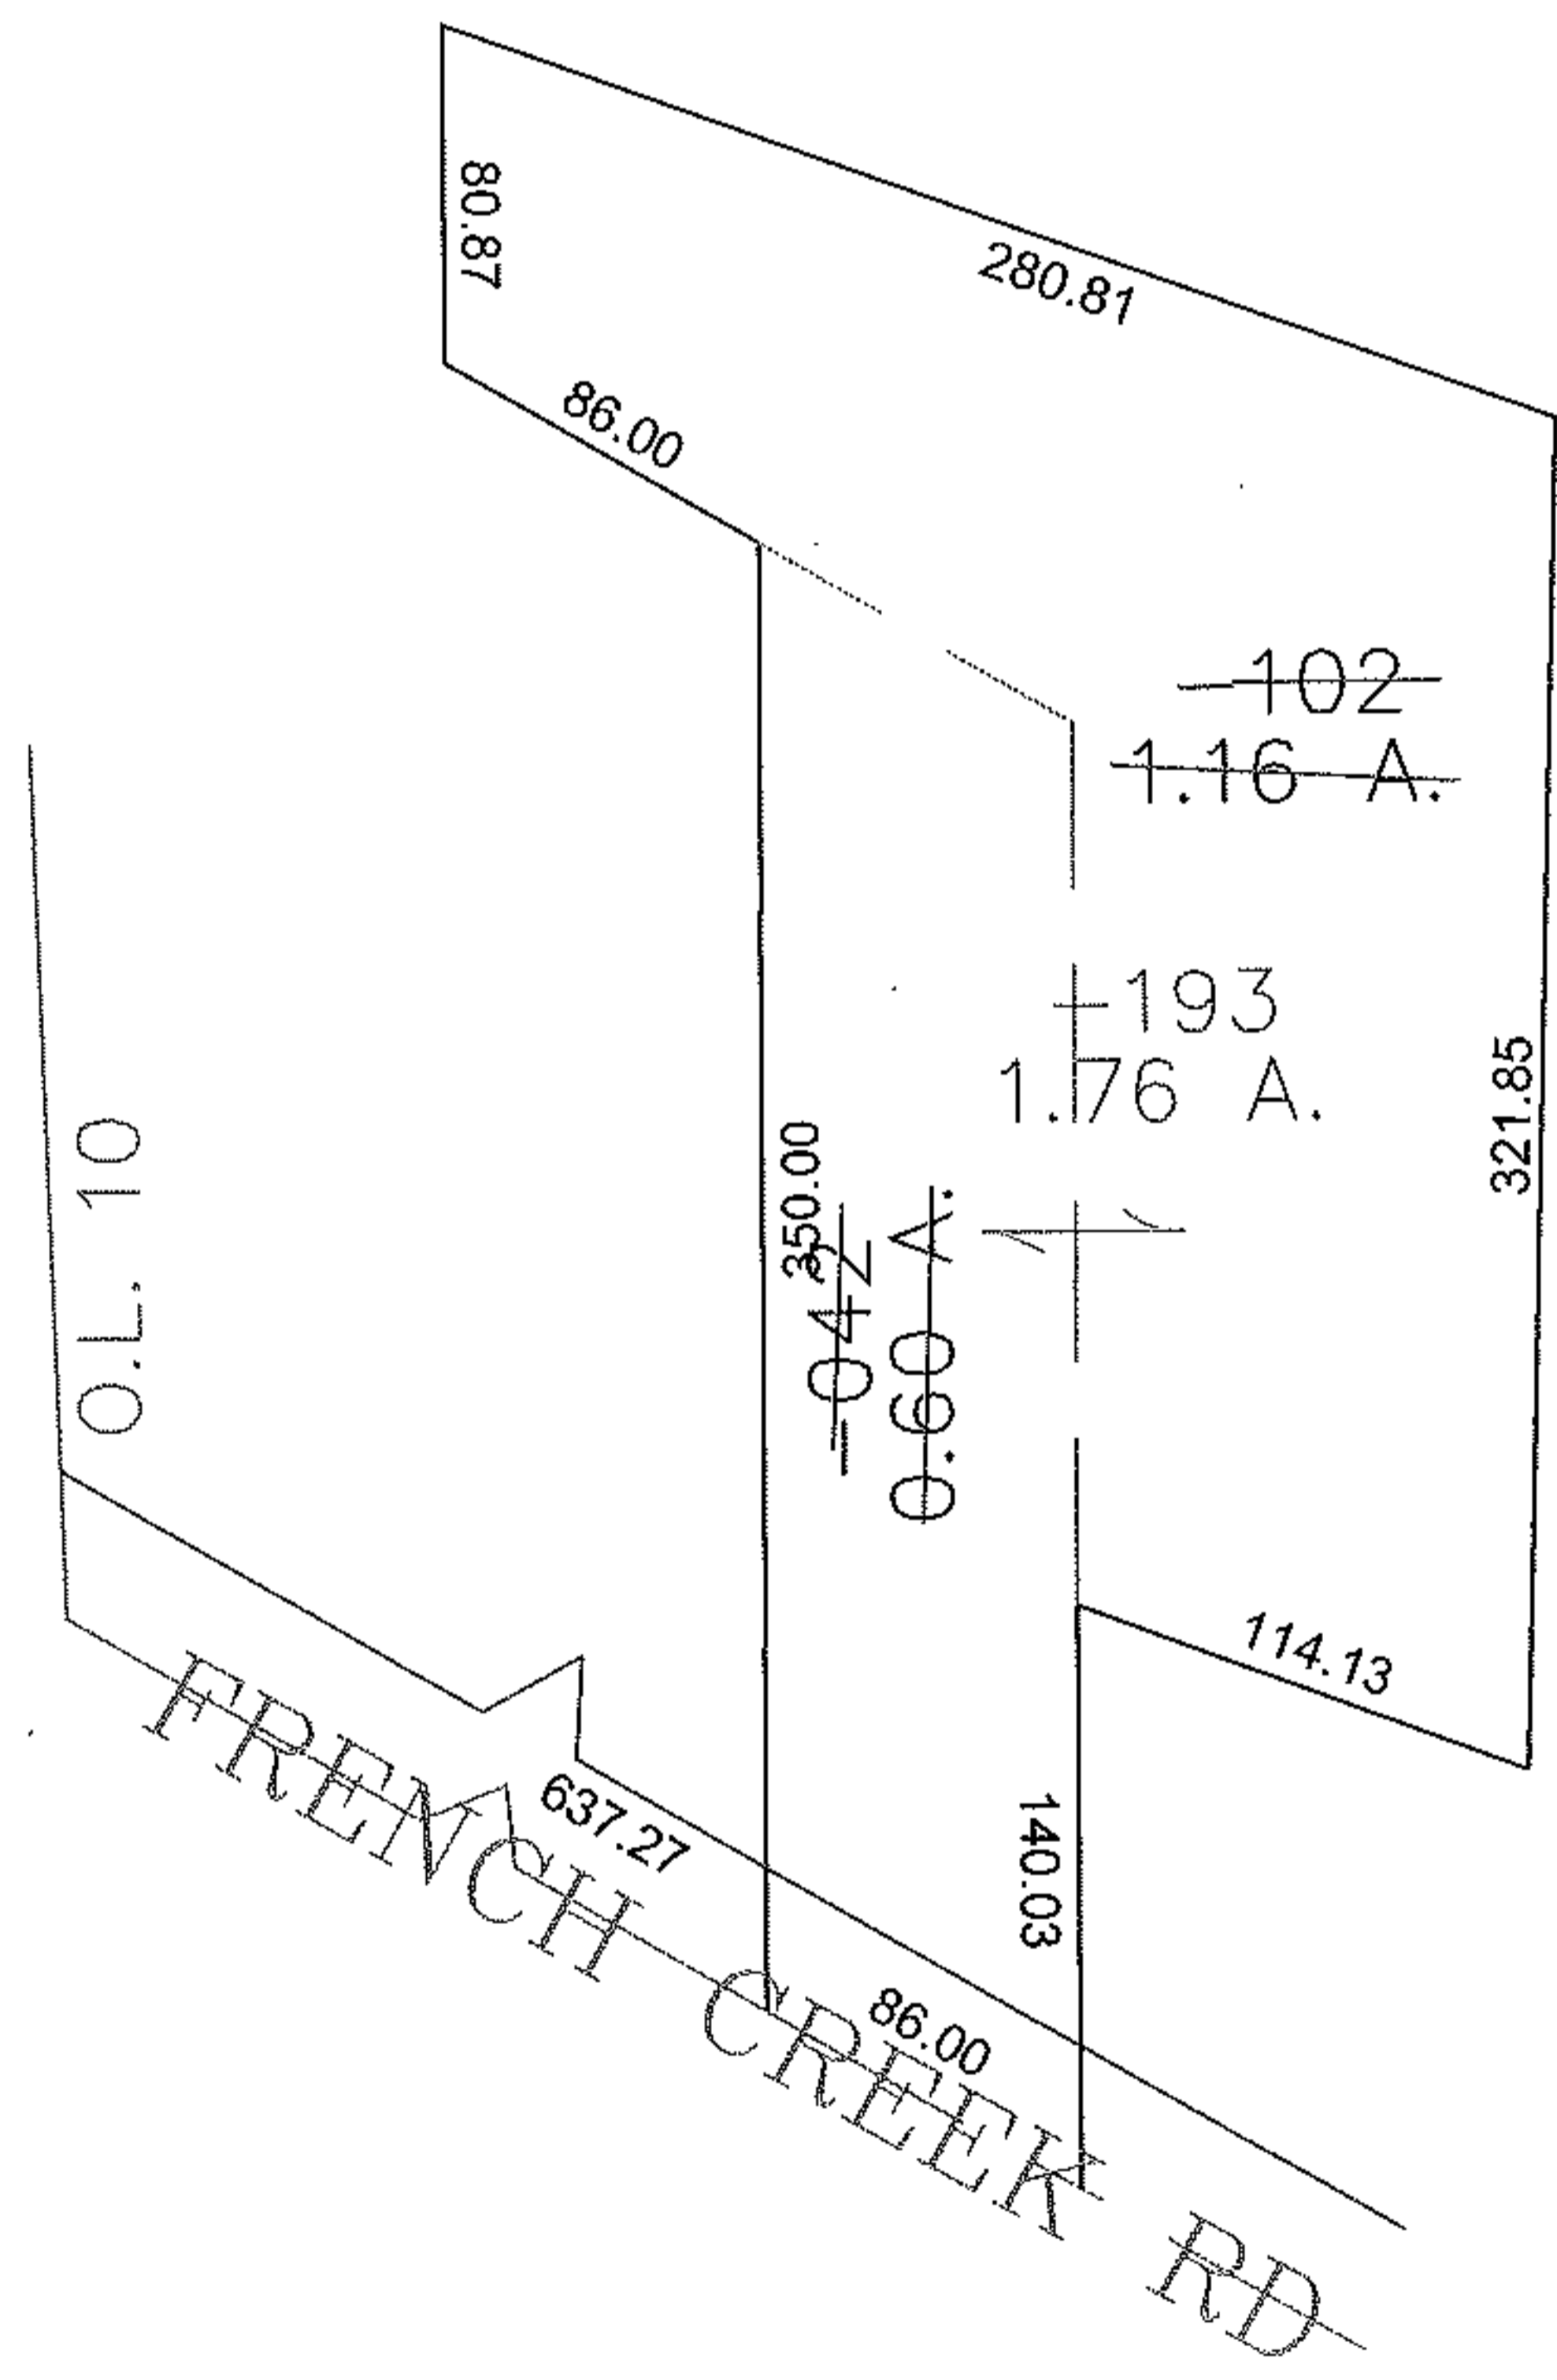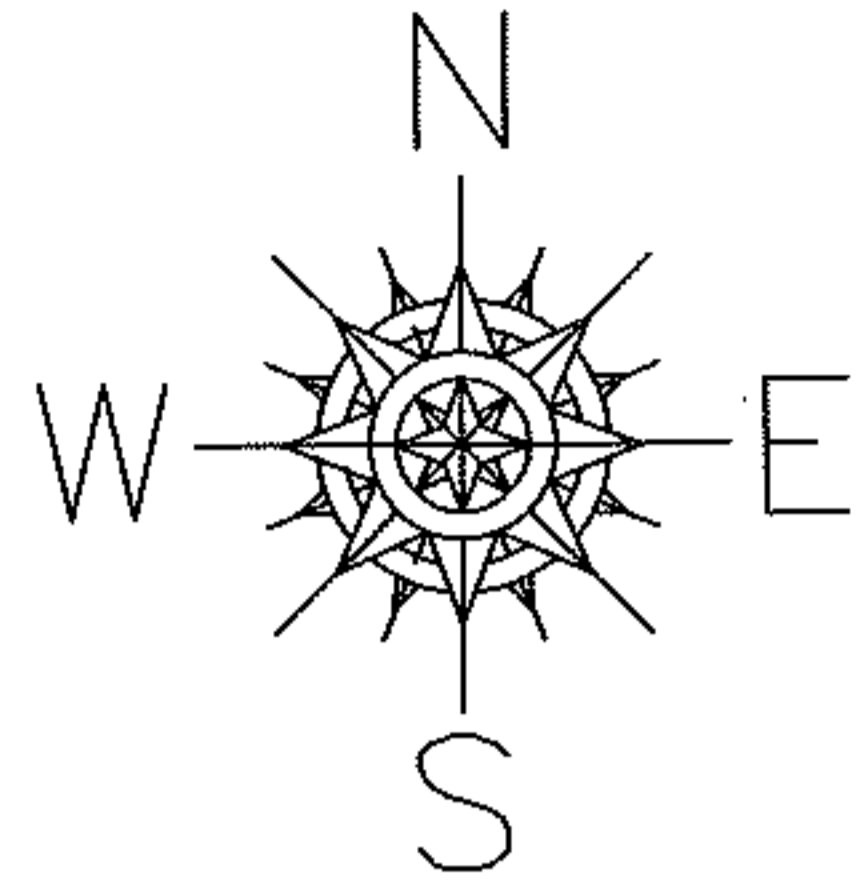

**SPLITS/DEEDS PROCESSED**

LORAIN COUNTY TAX MAP DEPARTMENT  
226 MIDDLE AVE. ELYRIA, OHIO

SURVEYED BY: PATRICK MCGANNON  
CLOSURE: 0.00 : 10.000  
MAP PAGE(S): 04-00-010-E  
APPROVED BY: JAH DATE: 5-1-09  
SCALE: 1" = 100 PRIOR INSTRUMENT: 20080268036