
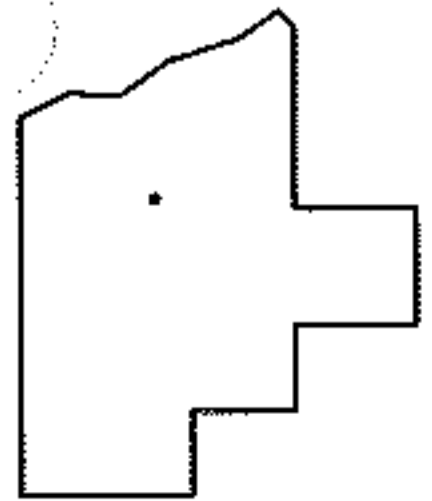
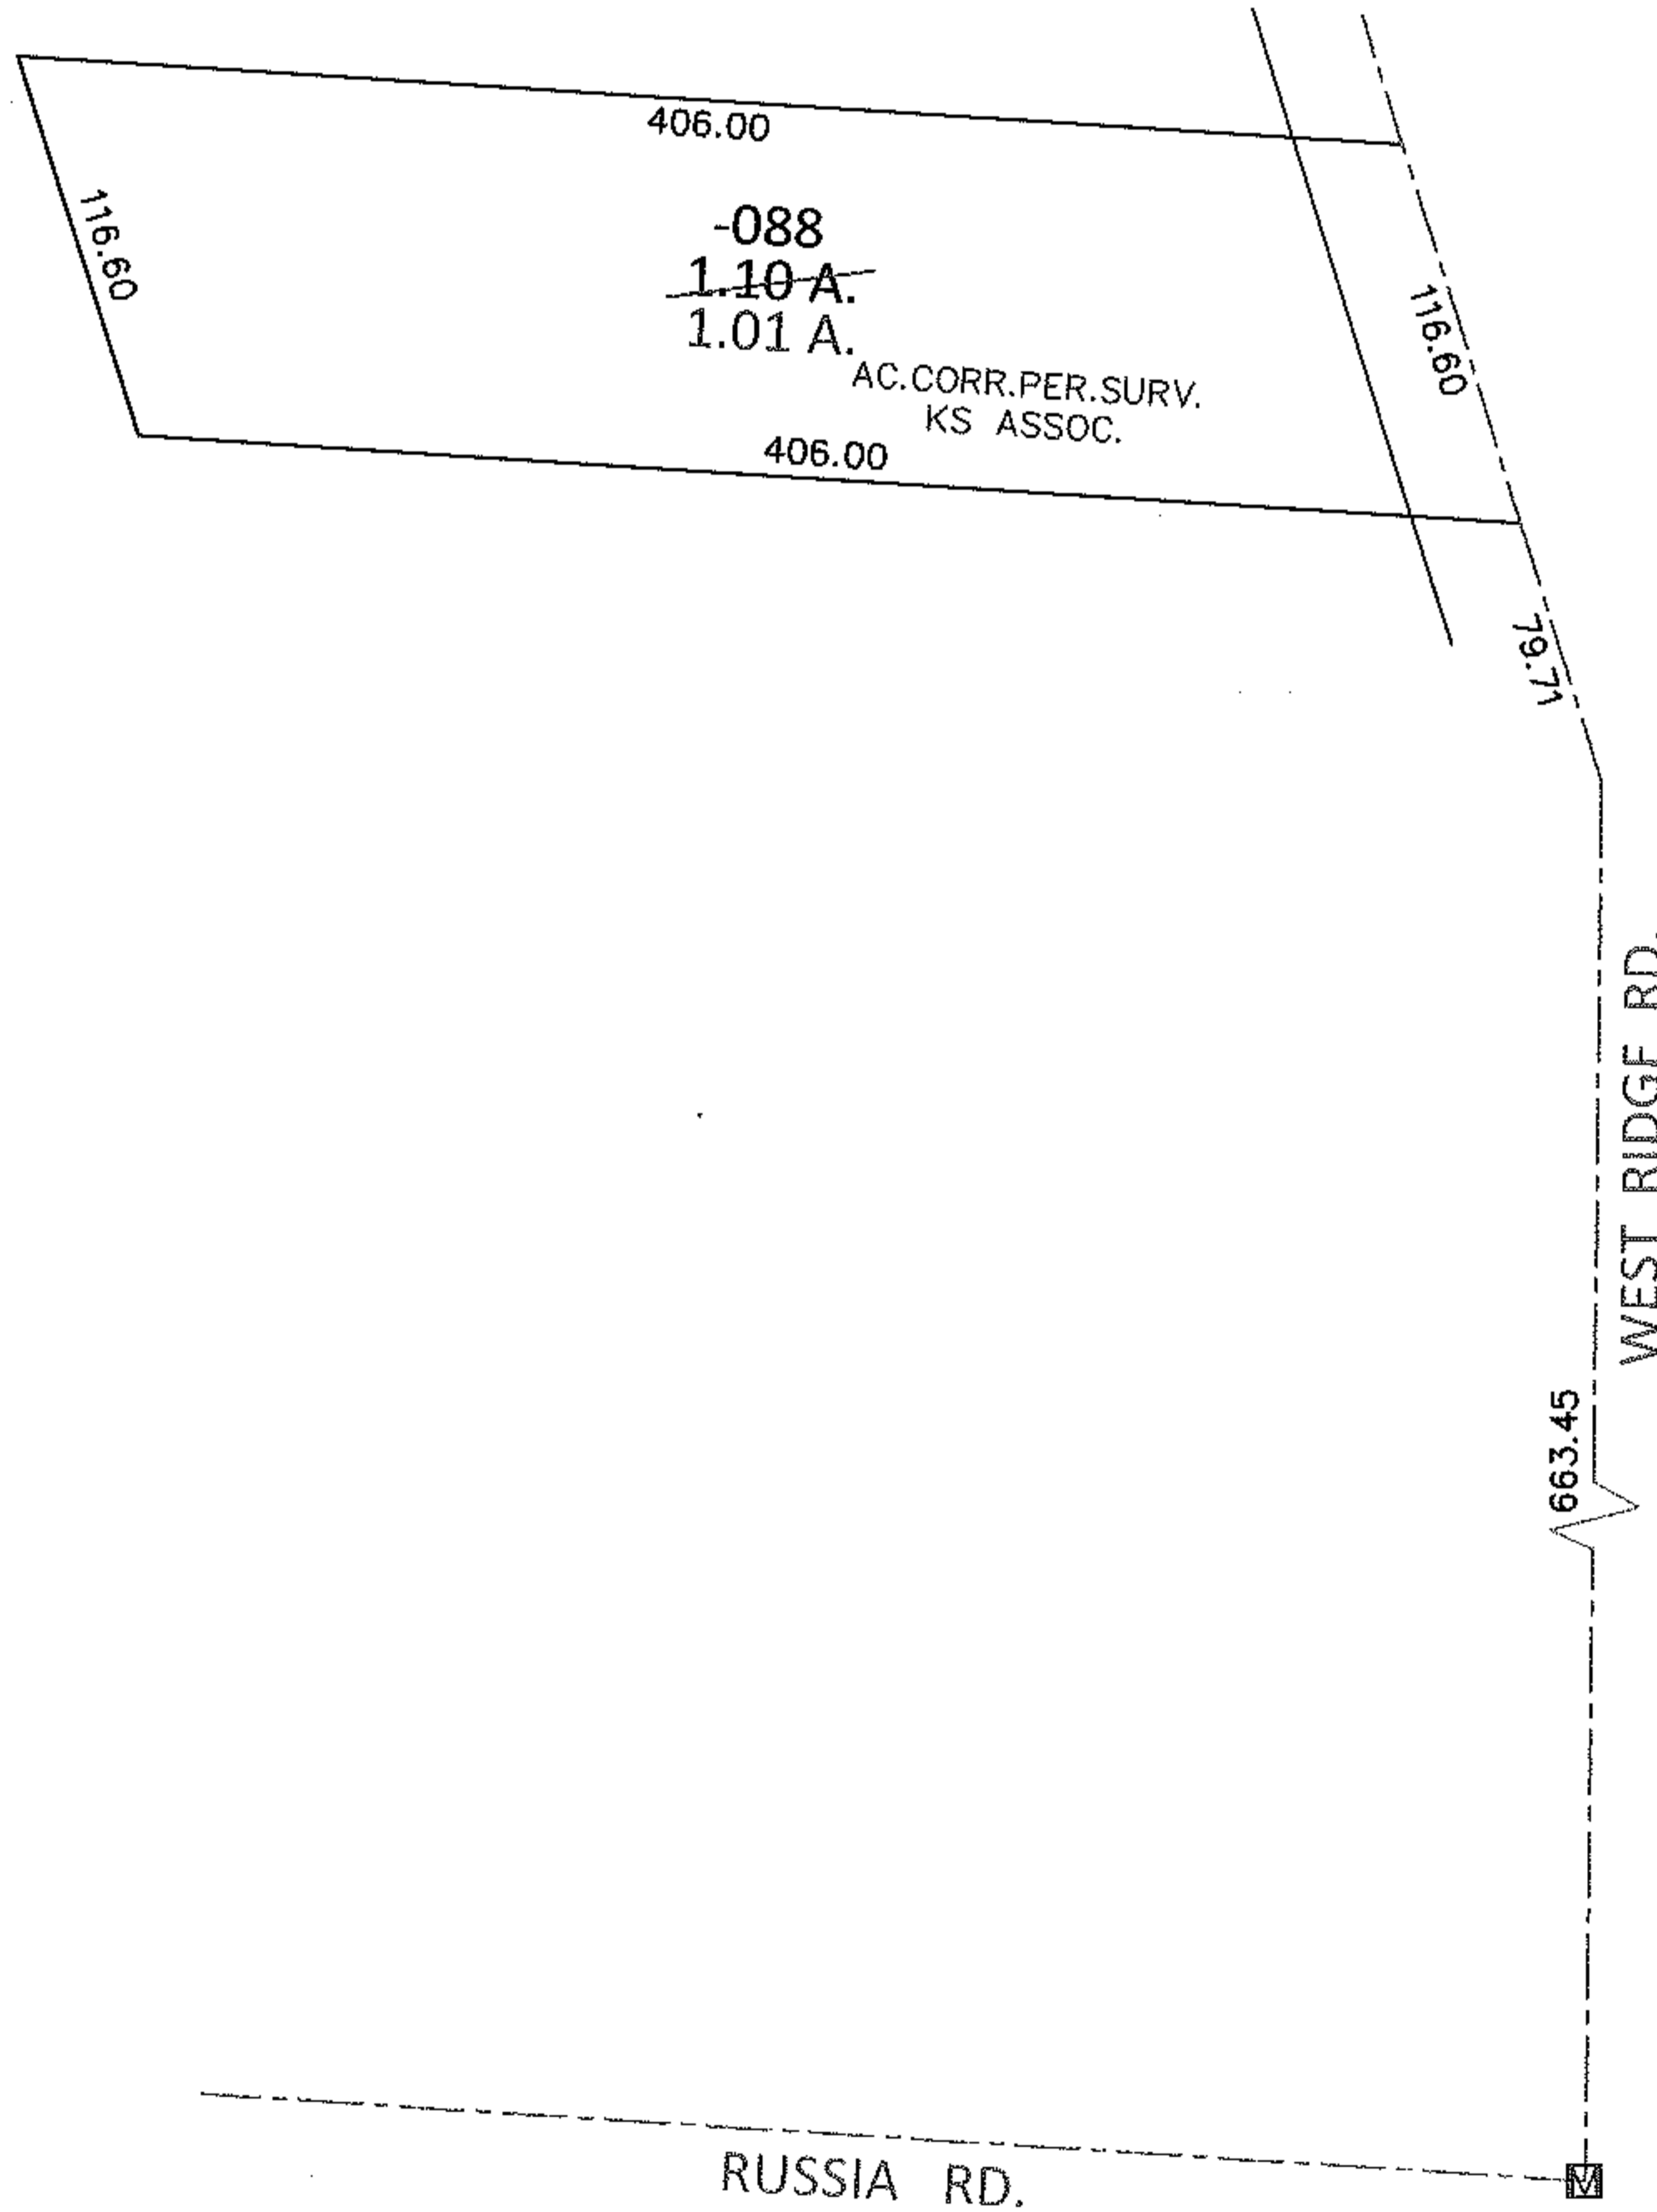


PARENT PARCEL: 10-00-001-101-088

CHILD PARCEL: _____

13-02695-A

STARTING POINT: AT A MON BOX AT THE INTERSECTION OF C/L OF RUSSIA RD. AND C/L OF WEST RIDGE RD.

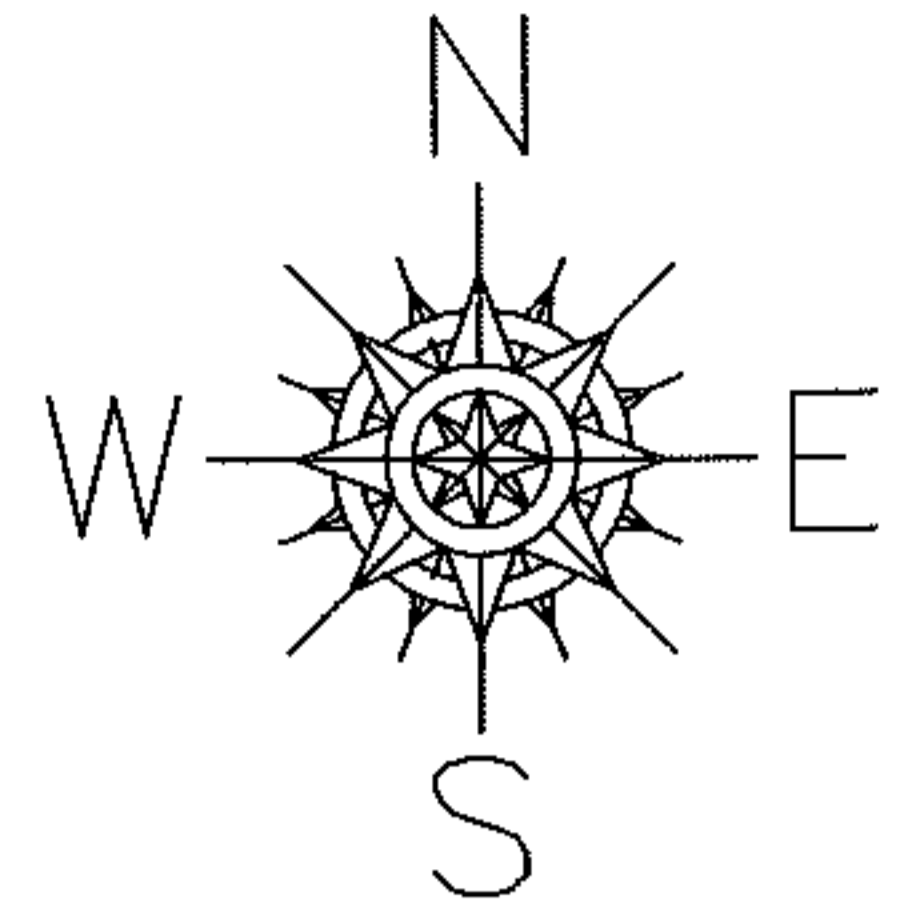

SPLITS/DEEDS PROCESSED

LORAIN COUNTY TAX MAP DEPARTMENT
226 MIDDLE AVE. ELYRIA, OHIO

SURVEYED BY: KS ASSOC.

CLOSURE: .00:10,000

MAP PAGE(S): 10-00-001-G

APPROVED BY: RRM DATE: 3-22-13

SCALE: 1"= 100 PRIOR INST.: 20130448233