
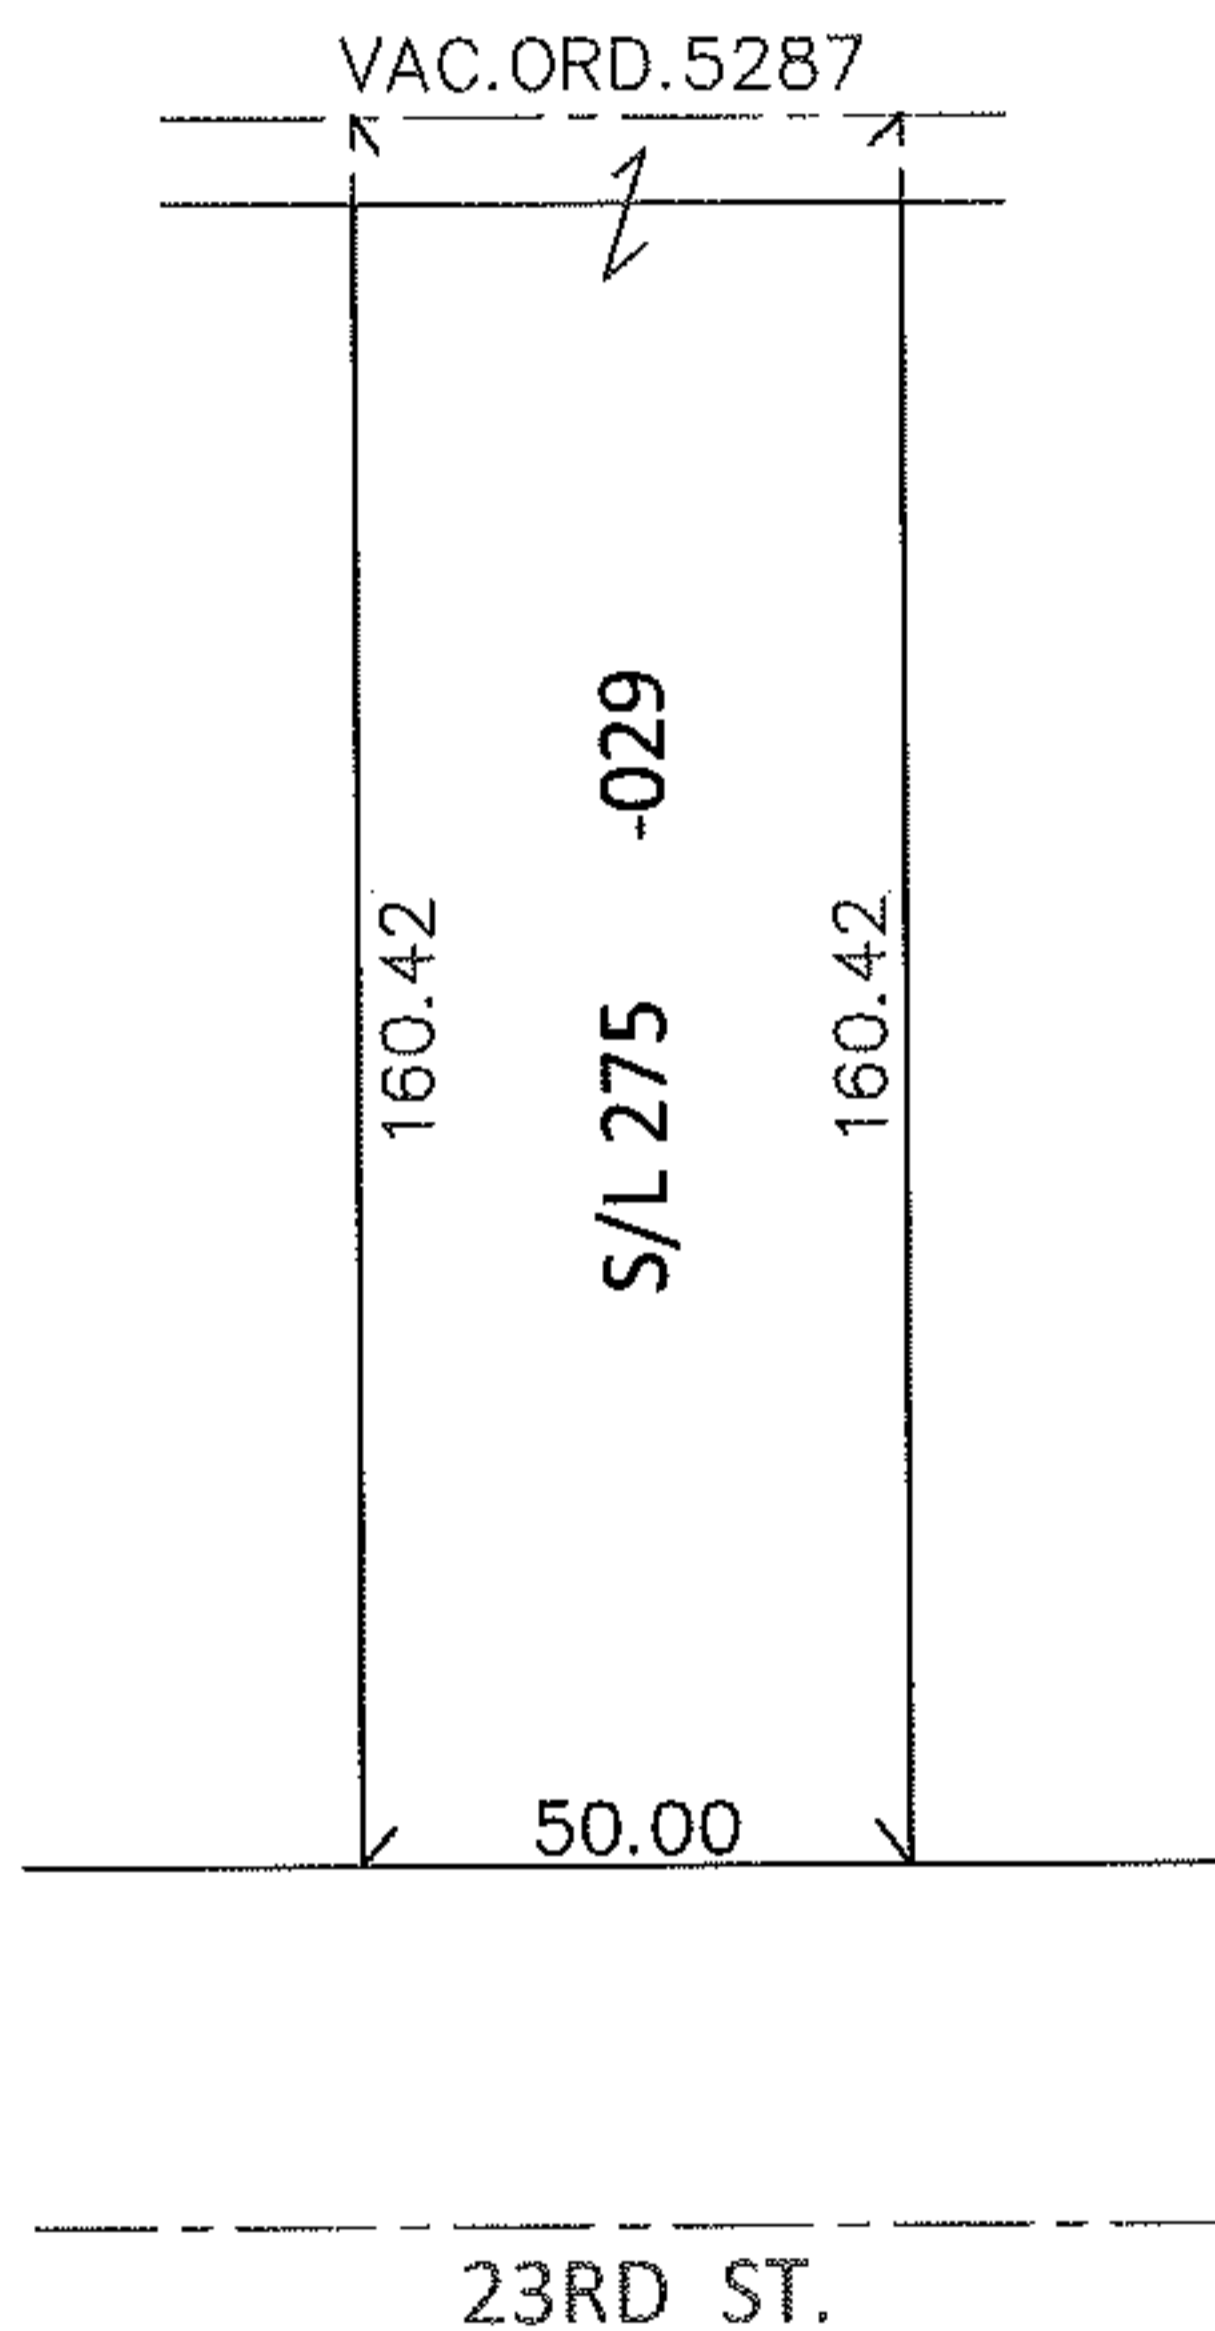


PARENT PARCEL: 02-01-006-152-029

CHILD PARCEL: _____

STARTING POINT: S/L 275 IN STANG'S 2ND SUB.(VOL.4 PG.18)

13-02696-C

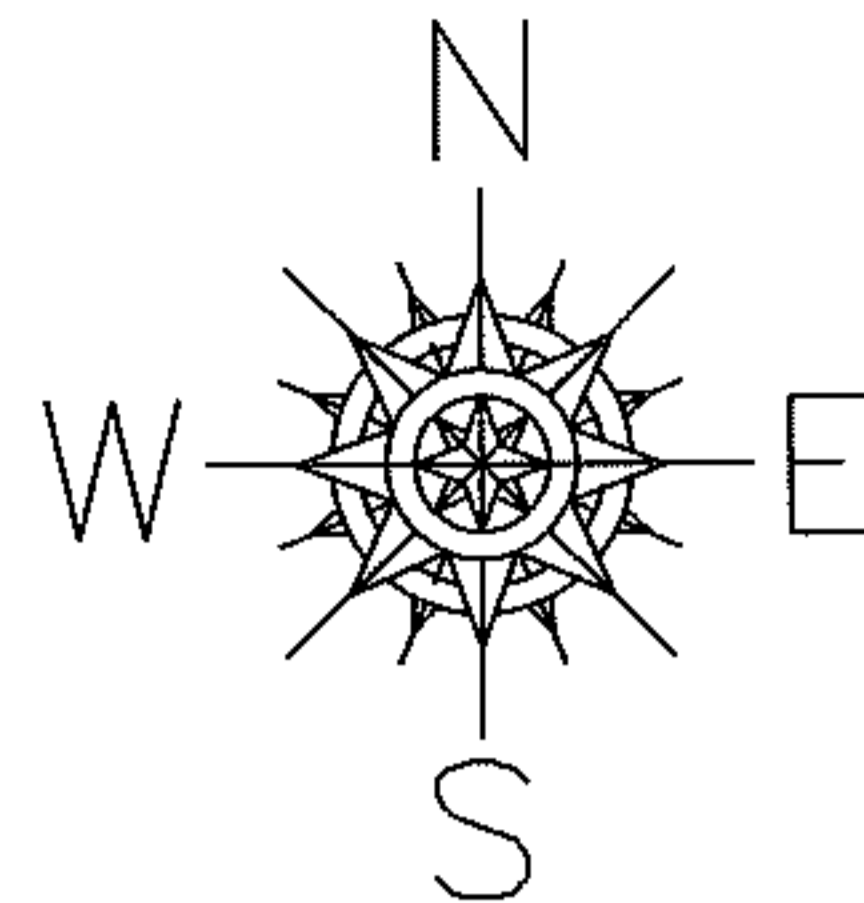


DEPTH CORRECTION

02-01-006-152-029

160.42

50 X ~~152~~

PER PRIOR DEEDS & VAC. ORD. 5287

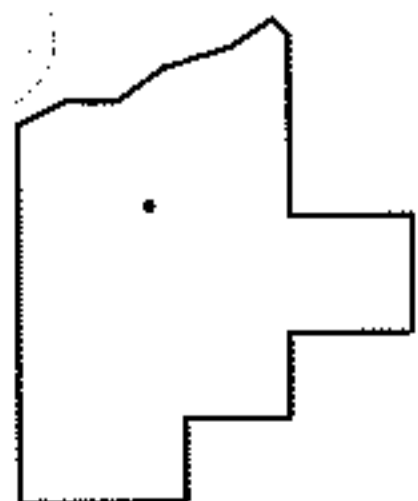

SPLITS/DEEDS PROCESSED

LORAIN COUNTY TAX MAP DEPARTMENT
226 MIDDLE AVE. ELYRIA, OHIO

SURVEYED BY: N/A

CLOSURE: N/A

MAP PAGE(S): 2-01-006-E

APPROVED BY: RRM DATE: 3-22-13

SCALE: 1"= 50' PRIOR INST.: 20040018614