



RASTER

PARENT PARCEL: 04-00-028-101-086, -085, -084, -083

CHILD PARCEL: 04-00-028-101-092 THRU -094

STARTING POINT: CENTERLINE OF JUST IMAGINE DR & O.L. 28

09-02700

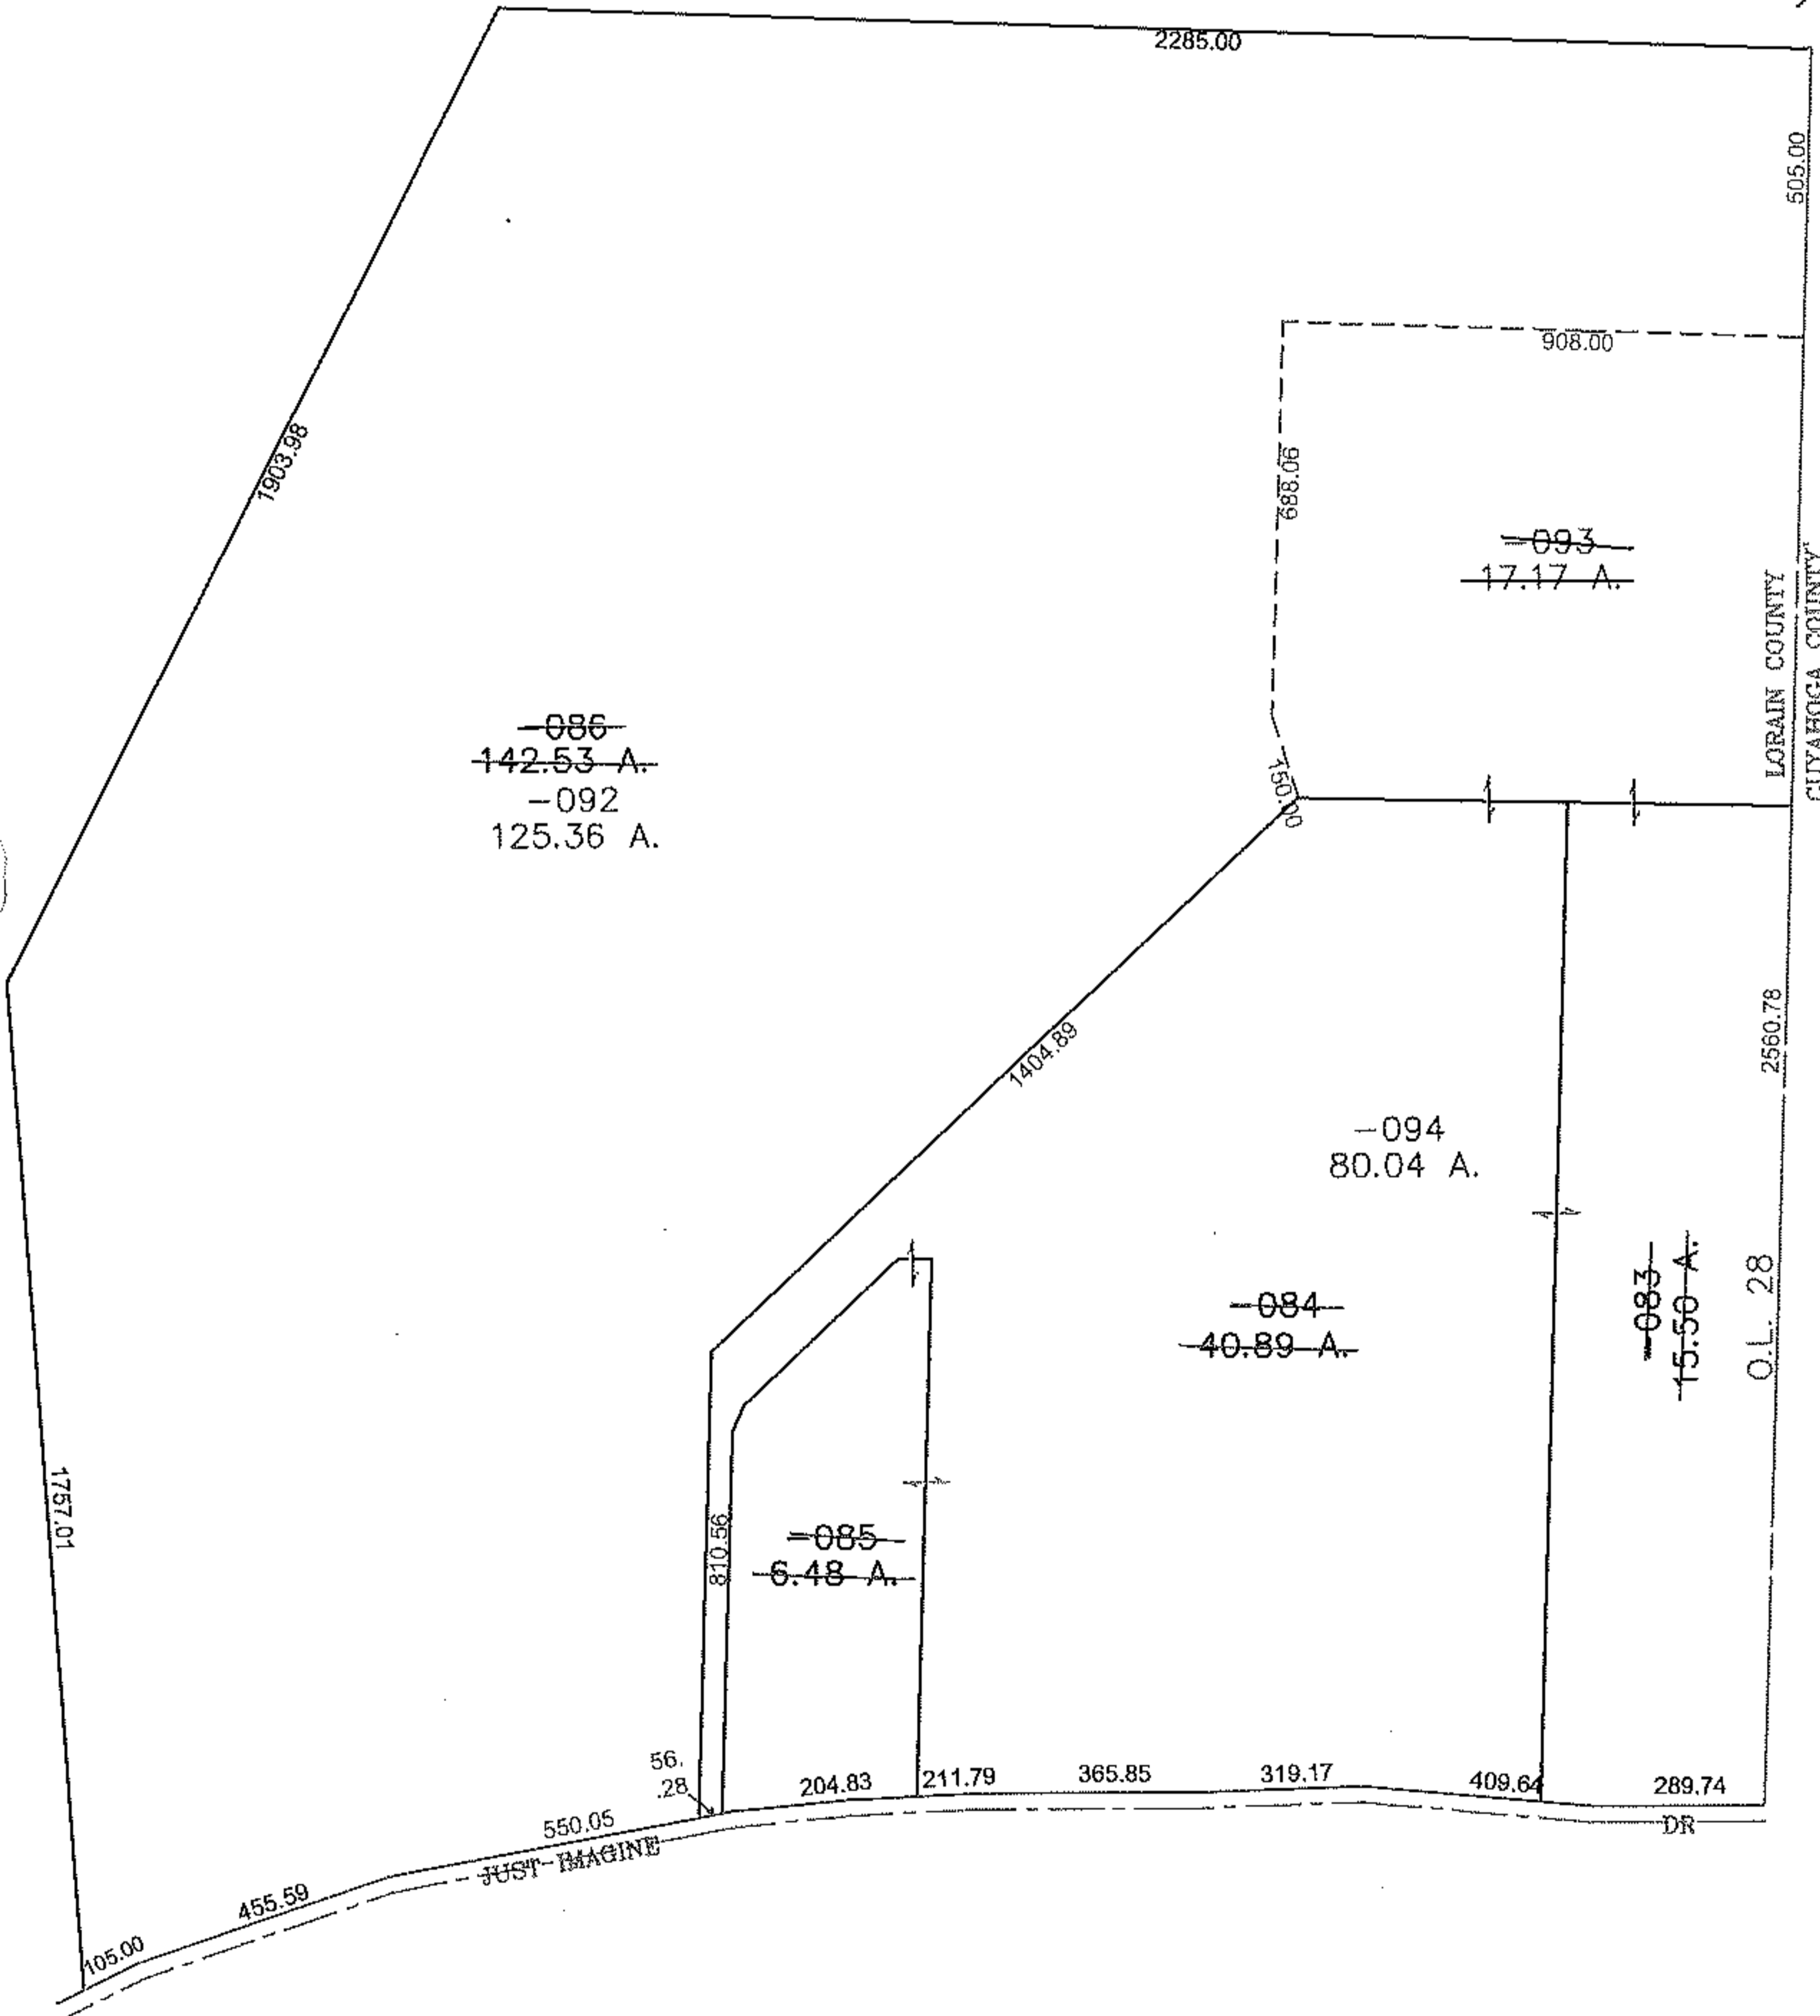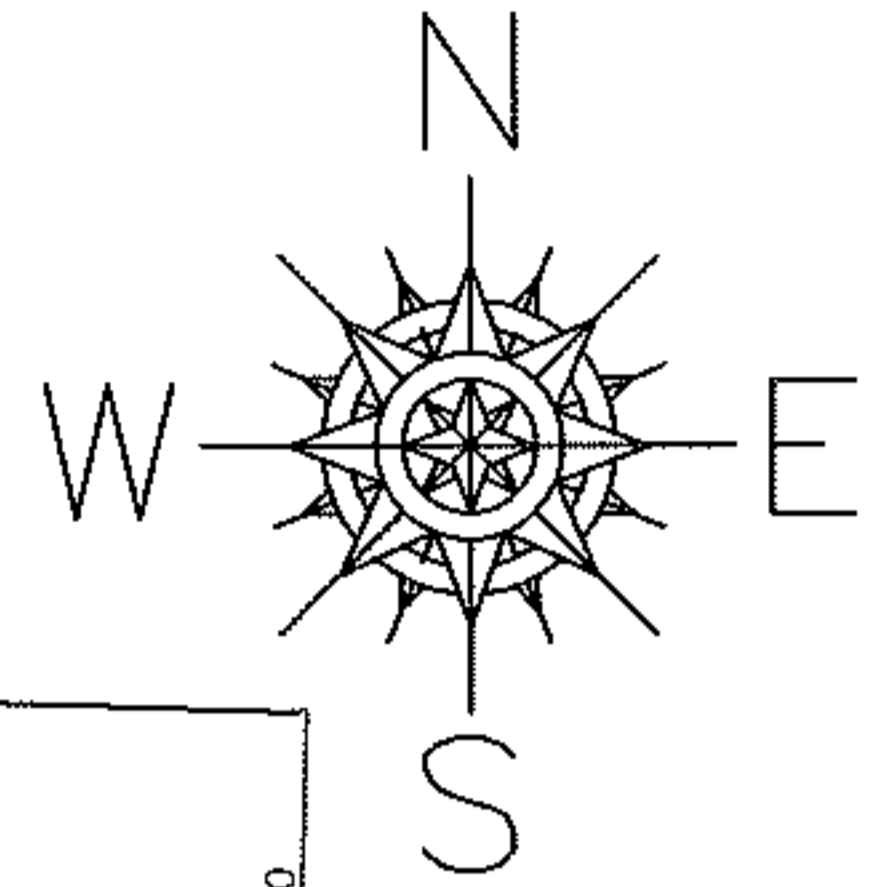

SPLITS/DEEDS PROCESSED

LORAIN COUNTY TAX MAP DEPARTMENT
226 MIDDLE AVE. ELYRIA, OHIO

SURVEYED BY: DAVID J KUETHE

CLOSURE: 0.00 : 10.000

MAP PAGE(S): 04-00-028-C, D

APPROVED BY: JAH DATE: 5-18-09

SCALE: 1" = 500 PRIOR INSTRUMENT: 20060132446