
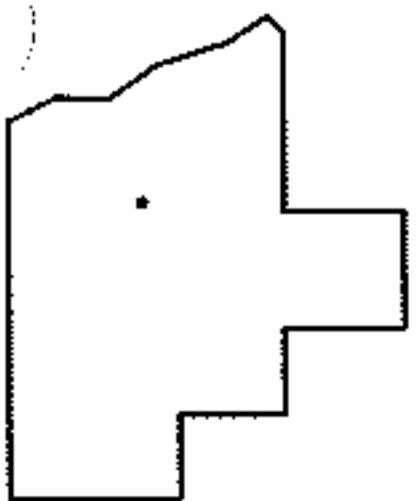
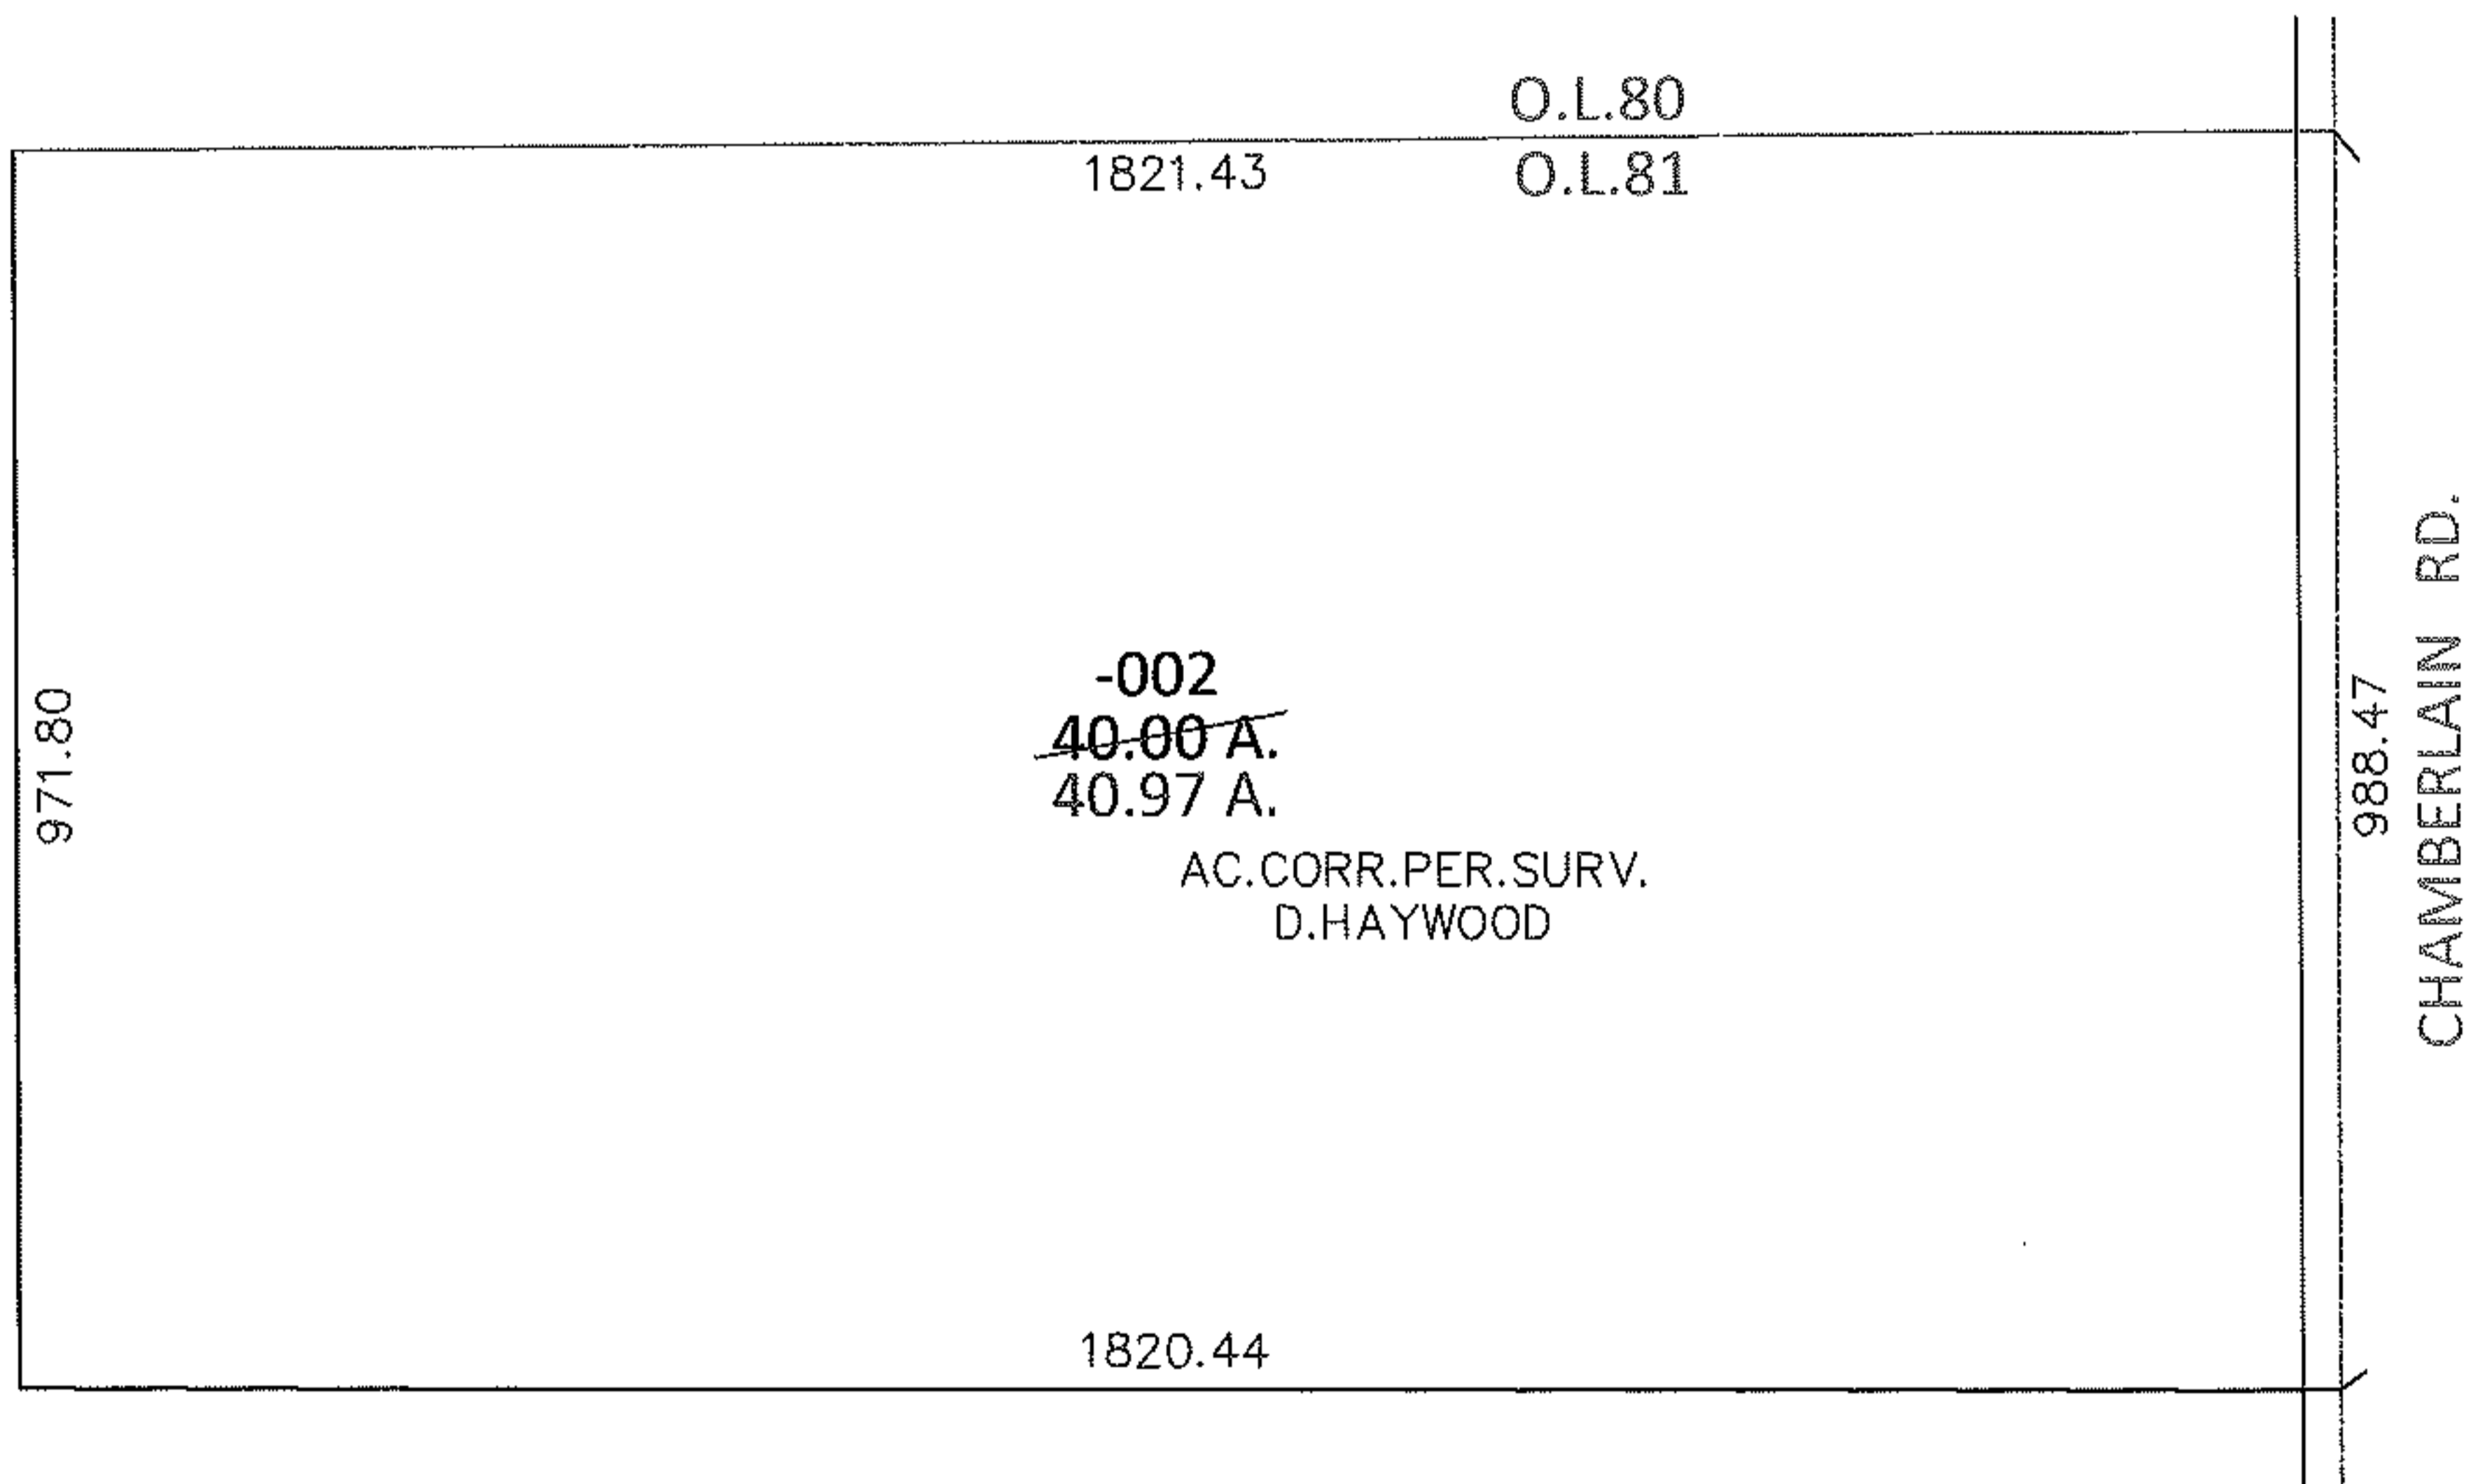


PARENT PARCEL: 16-00-081-000-002

CHILD PARCEL:

13-02701-A

STARTING POINT: NORTHEAST CORNER OF O.L.81

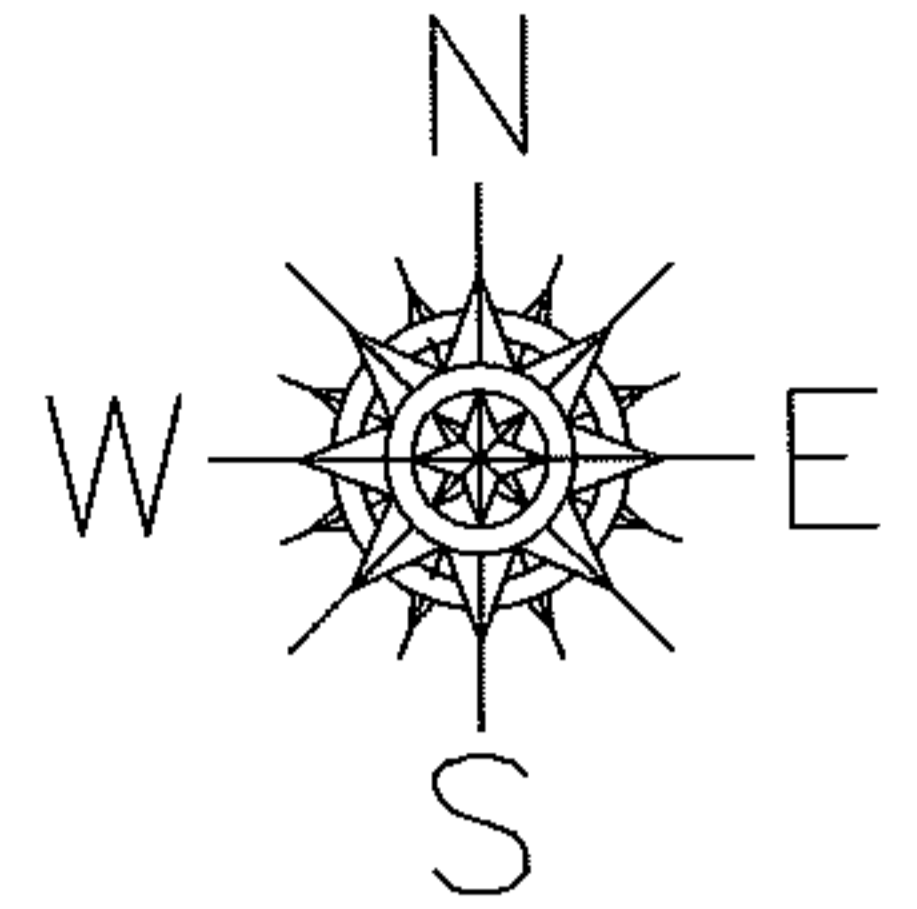

SPLITS/DEEDS PROCESSED

LORAIN COUNTY TAX MAP DEPARTMENT
226 MIDDLE AVE. ELYRIA, OHIO

SURVEYED BY: DALE R. HAYWOOD

CLOSURE: .01:10,000

MAP PAGE(S): 16-E

APPROVED BY: RRM DATE: 3-29-13

SCALE: 1"= 300 PRIOR INST.: 20120404703