
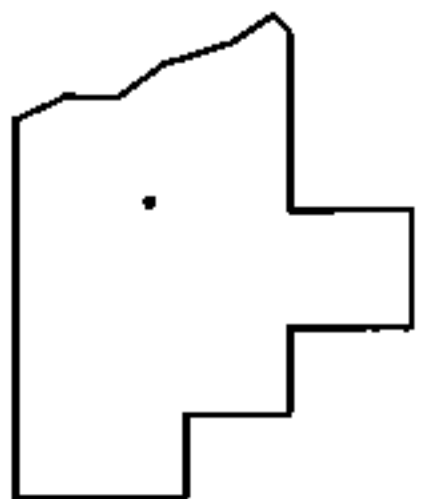
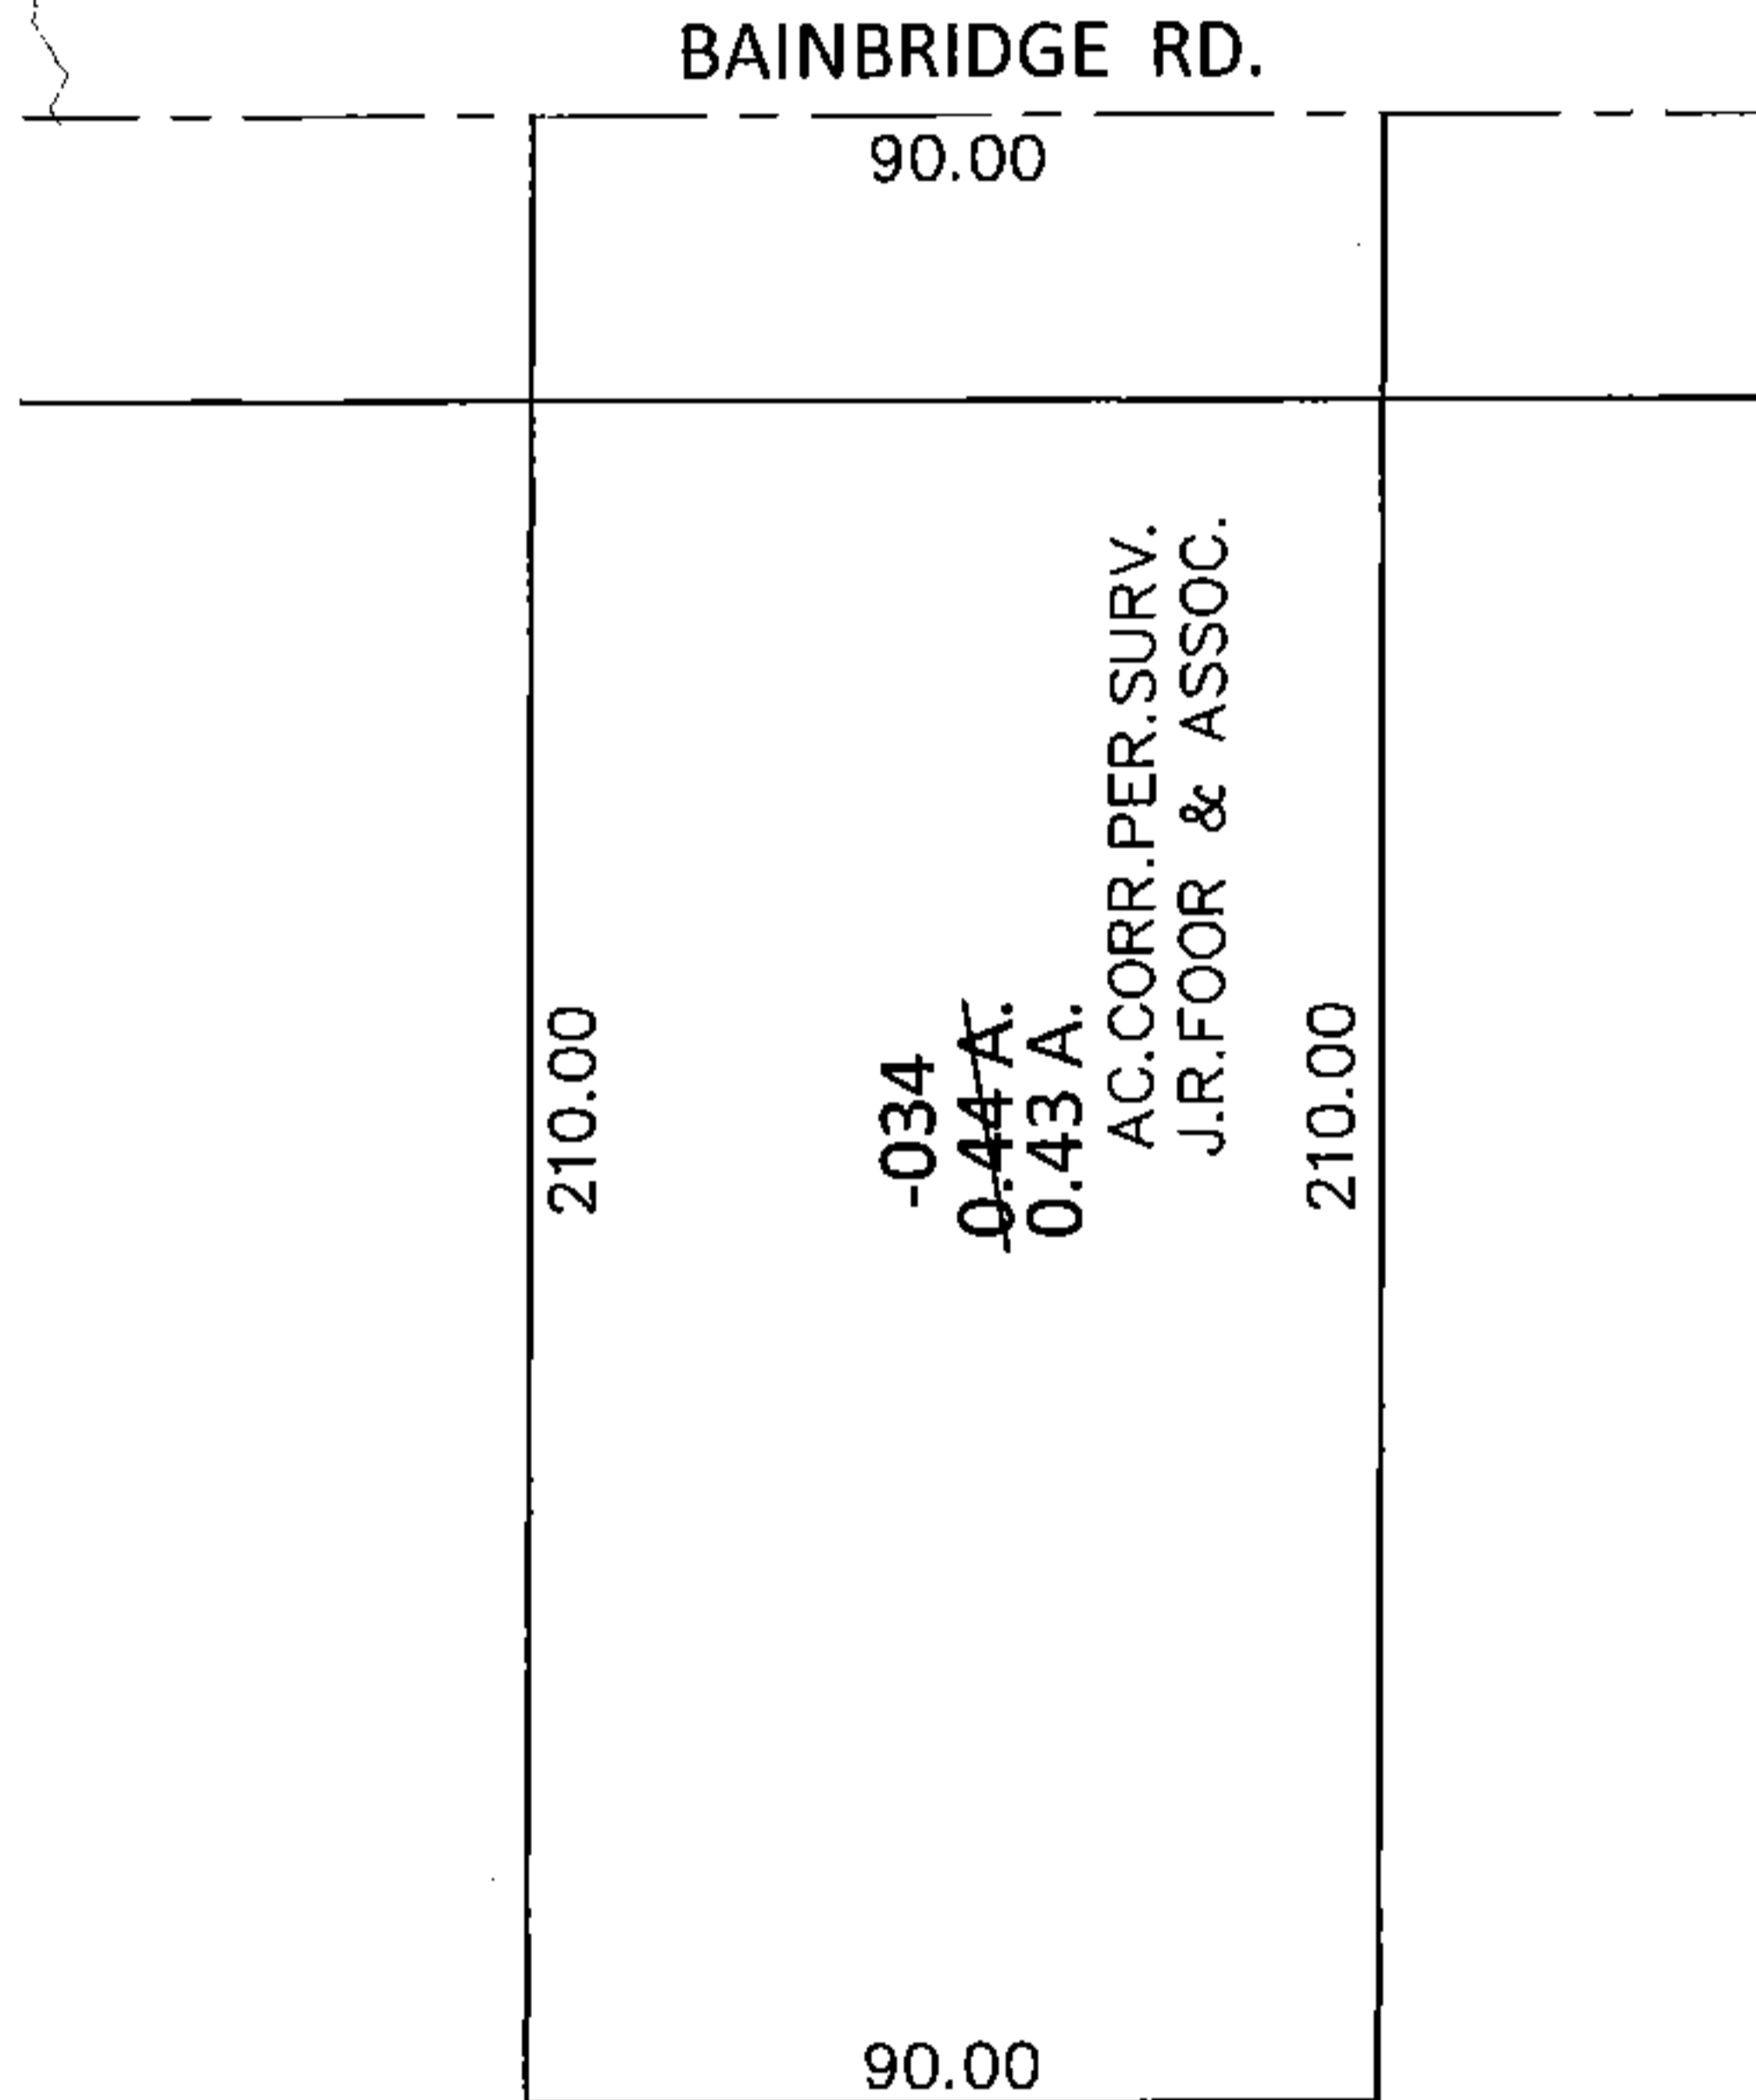


PARENT PARCEL: 07-00-015-104-034

CHILD PARCEL: _____

STARTING POINT: NORTHEAST CORNER OF LAND CONVEYED TO IRELAND & BETTY MARCUM (DV 1045/212)

13-02702-A

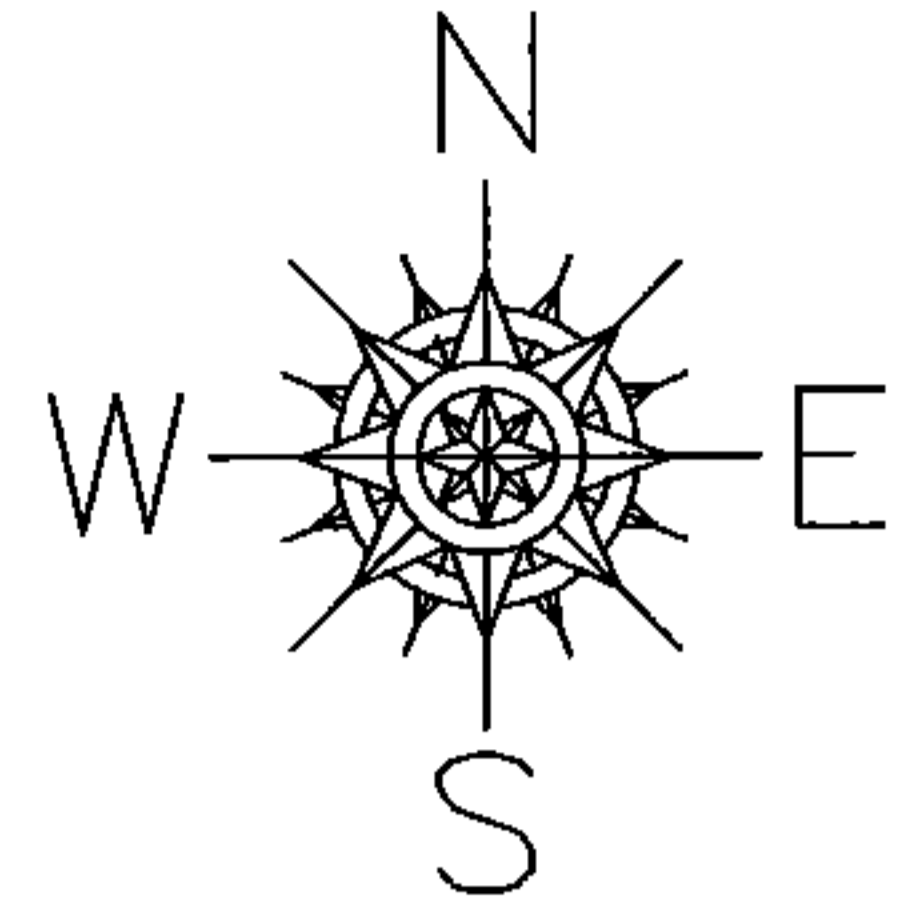

SPLITS/DEEDS PROCESSED

LORAIN COUNTY TAX MAP DEPARTMENT
226 MIDDLE AVE. ELYRIA, OHIO

SURVEYED BY: J.R. FOOR & ASSOC.

CLOSURE: .00:10,000

MAP PAGE(S): 7-00-015-A

APPROVED BY: RRM DATE: 4-4-13

SCALE: 1"= 50' PRIOR INST.: DV 1181/225