
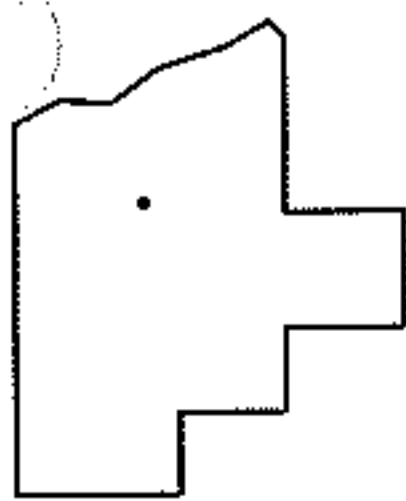
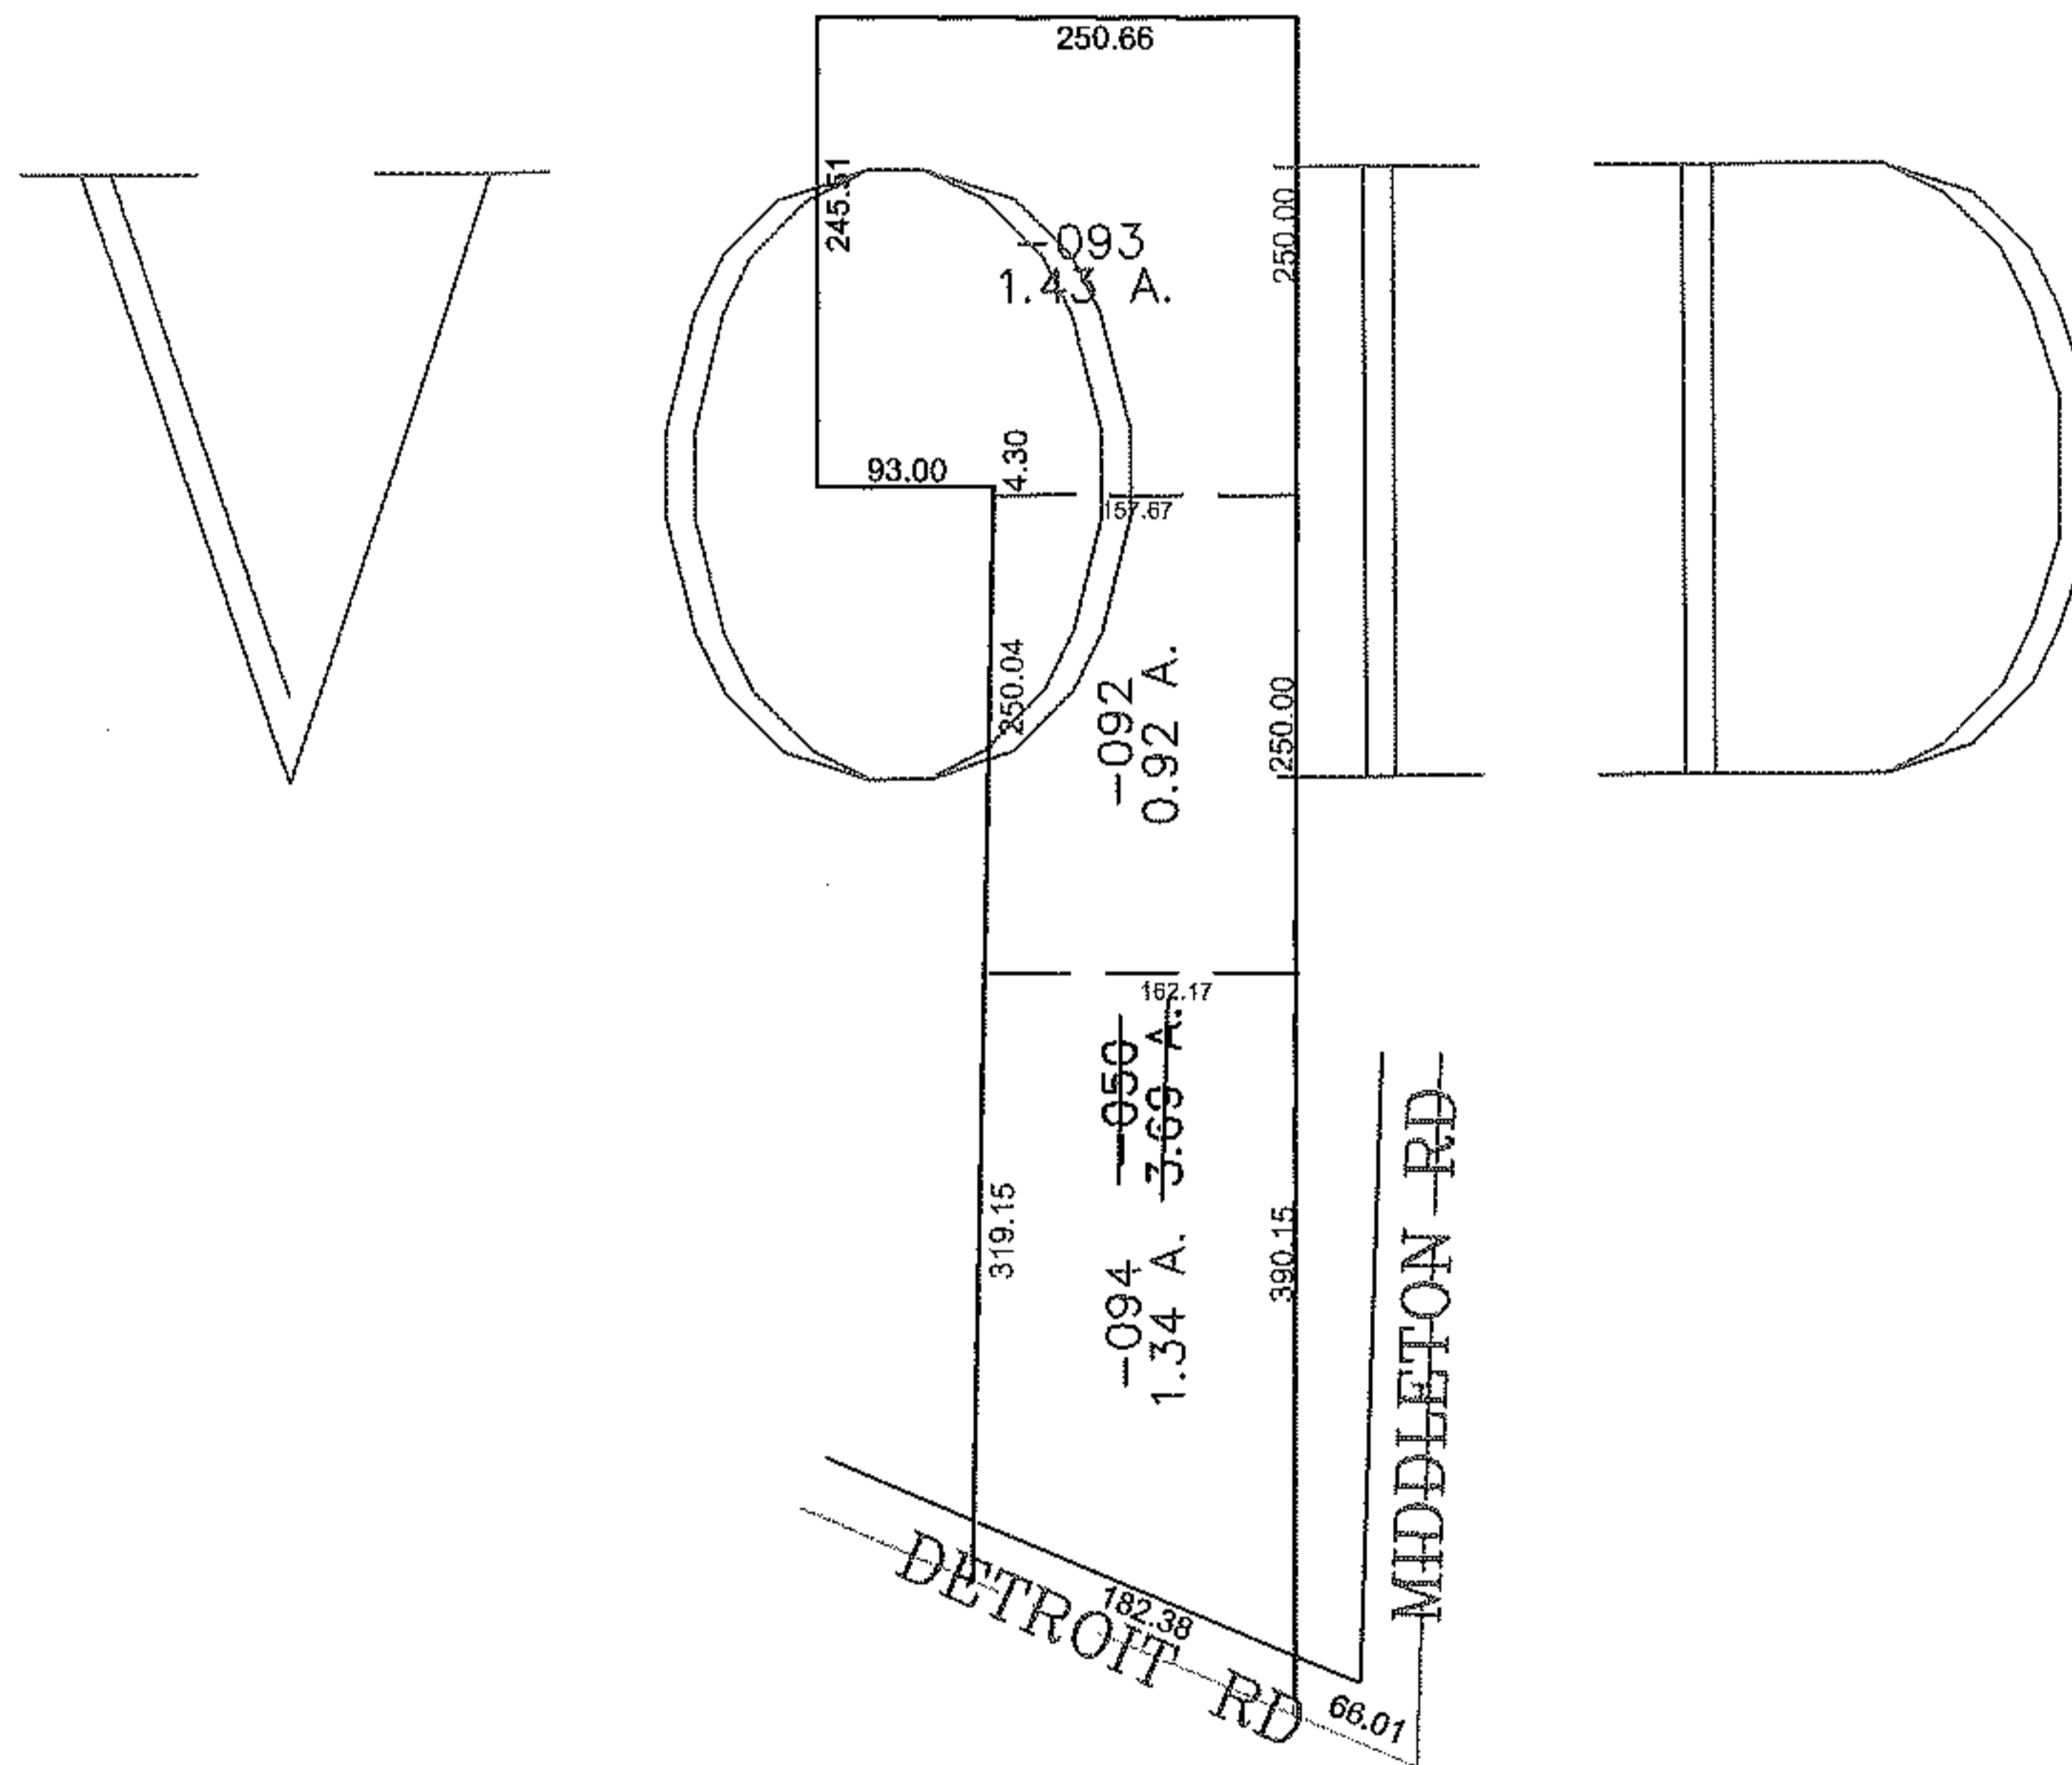


PARENT PARCEL: 04-00-015-103-050

CHILD PARCEL: 04-00-015-103-092 THRU -094

STARTING POINT: CENTERLINE OF DETROIT RD % MIDDLETON RD

09-02706

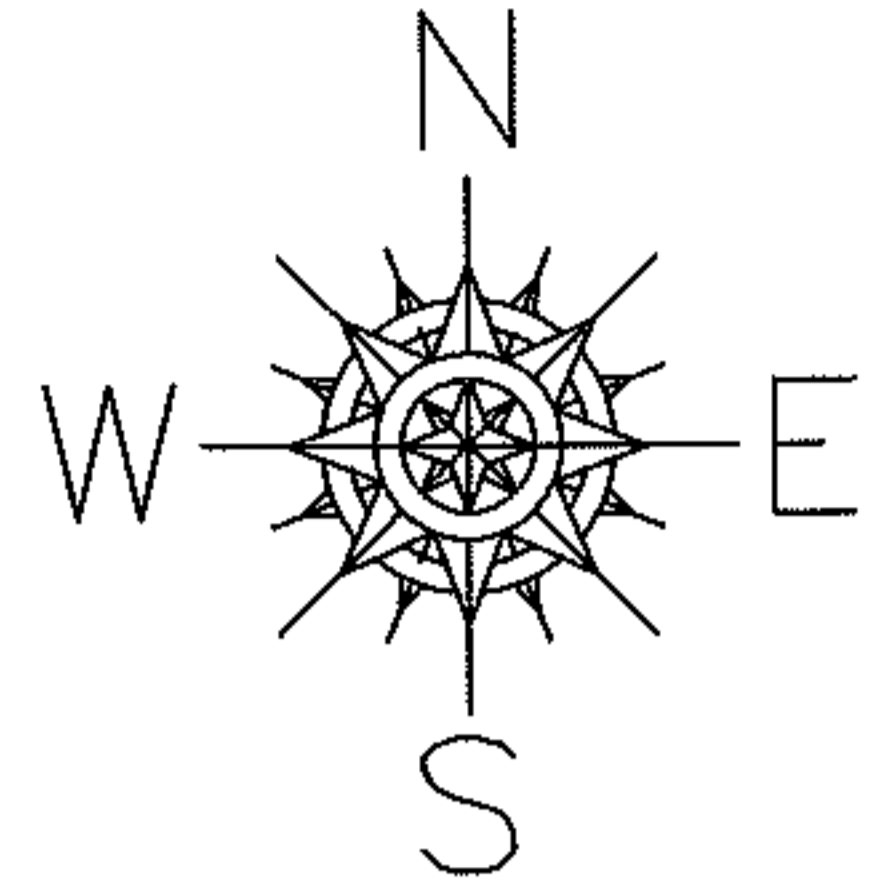

**SPLITS/DEEDS PROCESSED**  
**LORAIN COUNTY TAX MAP DEPARTMENT**  
**226 MIDDLE AVE. ELYRIA, OHIO**

SURVEYED BY: MICHAEL SPELLACY  
 CLOSURE: 0.00 : 10.000  
 MAP PAGE(S): 04-00-015-D  
 APPROVED BY: JAH DATE: 6-08-09  
 SCALE: 1" = 200 PRIOR INSTRUMENT: 20080262049