



RASTER

PARENT PARCEL: 06-24-036-106-004, -007

CHILD PARCEL: 06-24-036-106-008 THRU -010

STARTING POINT: CENTERLINE OF LAKE AVE & O.L. 36

09-02707

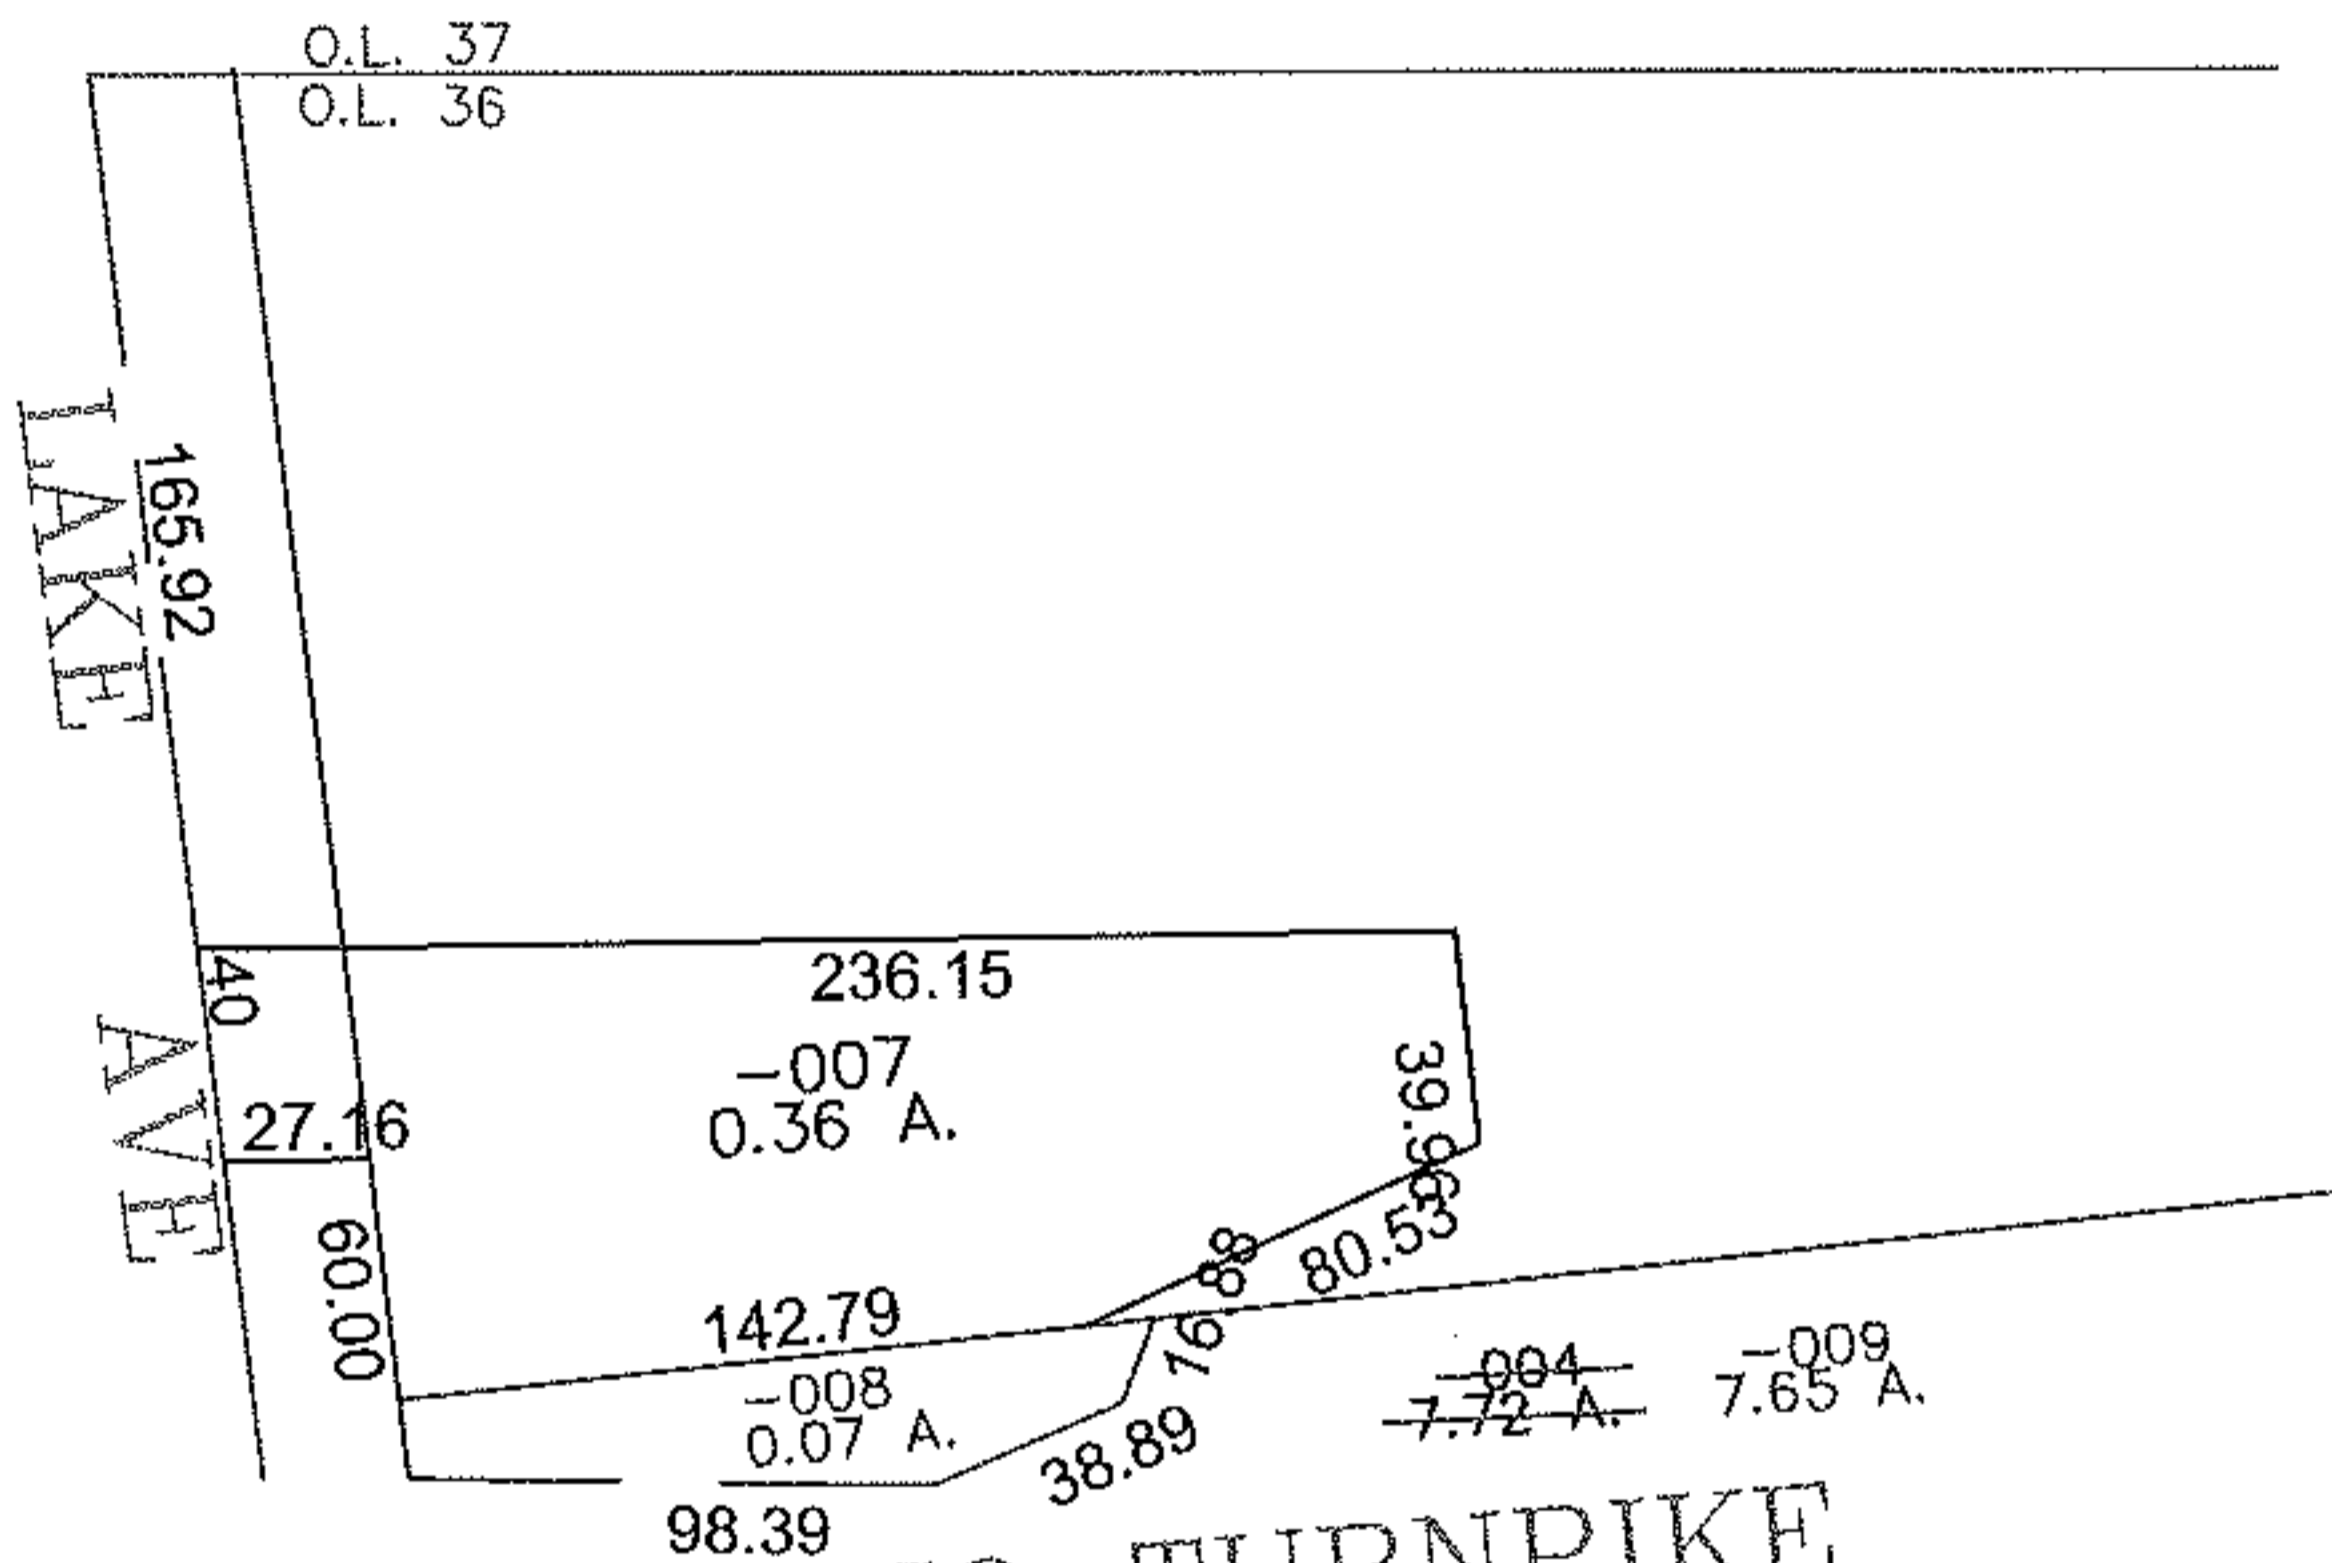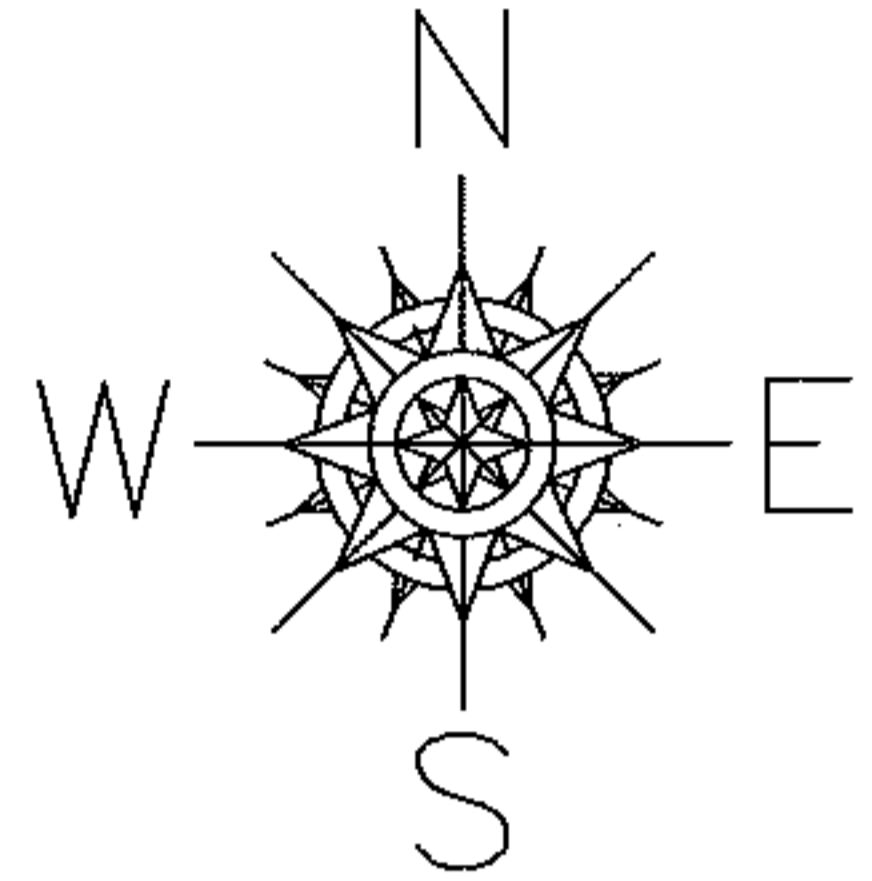

OHIO TURNPIKE  
REMAINDER NOT SURVEY CONSIDERED ROAD TAKE  
PER MARK STEWART

SPLITS/DEEDS PROCESSED

LORAIN COUNTY TAX MAP DEPARTMENT  
226 MIDDLE AVE. ELYRIA, OHIO

SURVEYED BY: DALE HAYWOOD

CLOSURE: 0.00 : 10,000

MAP PAGE(S): 6-61

APPROVED BY: JAH DATE: 6-15-09

SCALE: 1" = 100 PRIOR INSTRUMENT: DV 17/79