




RASTER

PARENT PARCEL: 15-00-028-000-021

CHILD PARCEL: 15-00-028-000-022, -023

STARTING POINT: CENTERLINE OF WHEELER RD & BIGGS RD

09-02710

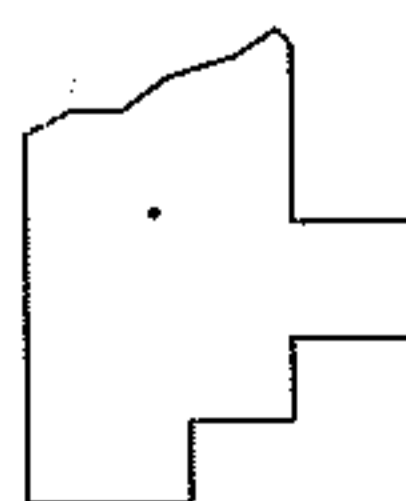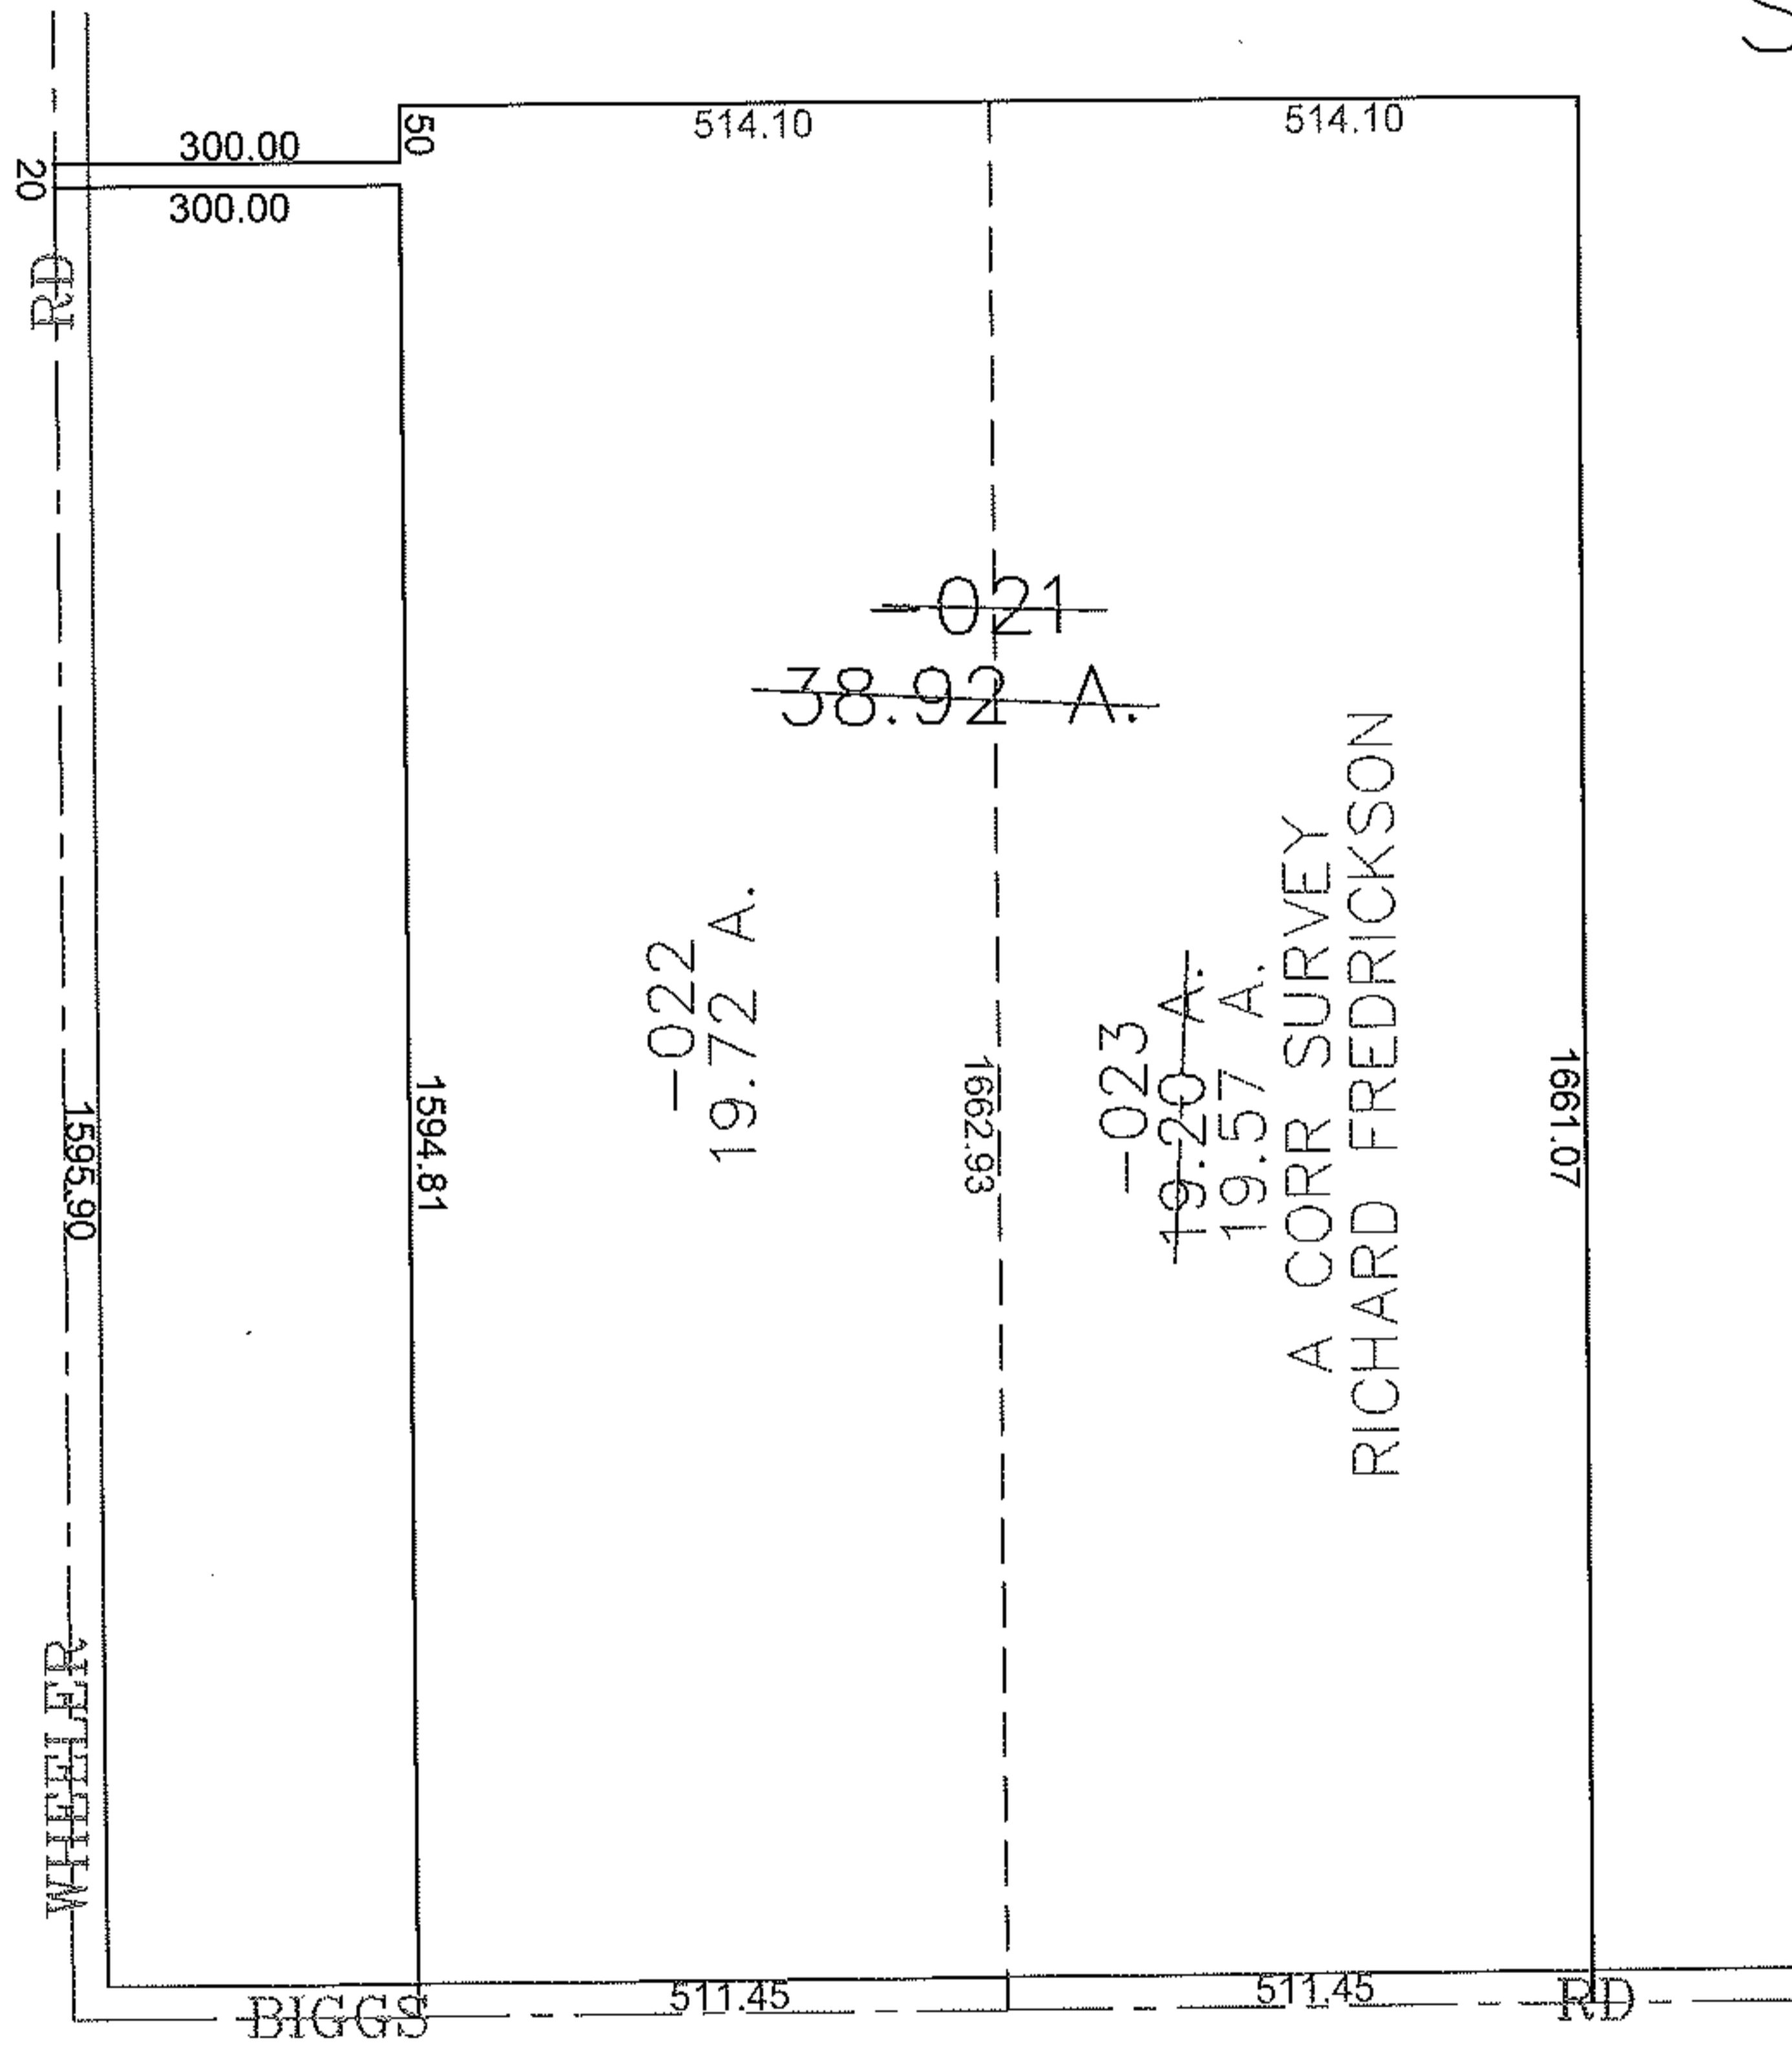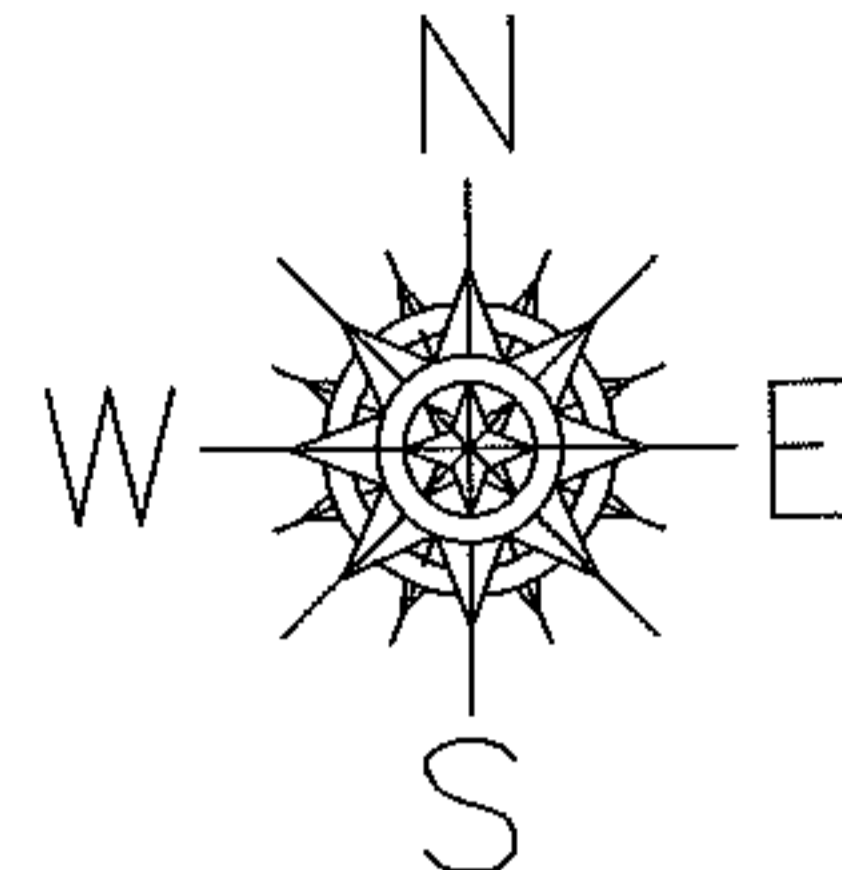

SPLITS/DEEDS PROCESSED
 LORAIN COUNTY TAX MAP DEPARTMENT
 226 MIDDLE AVE. ELYRIA, OHIO

SURVEYED BY: RICHARD FREDRICKSON
 CLOSURE: 0.00 : 10.000
 MAP PAGE(S): 15-00-028-A
 APPROVED BY: JAH DATE: 6-17-09
 SCALE: 1" = 300 PRIOR INSTRUMENT: DV 1395/769