

PARENT PARCEL: 16-00-001-112-030




CHILD PARCEL:

STARTING POINT:

13-02712-C

MAP CORRECTION ONLY

16-00-001-112-030
WAS MAPPED INCORRECTLY

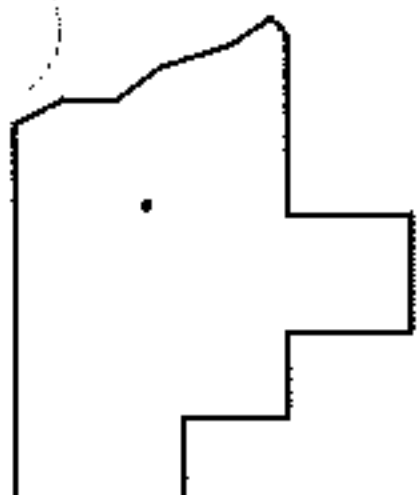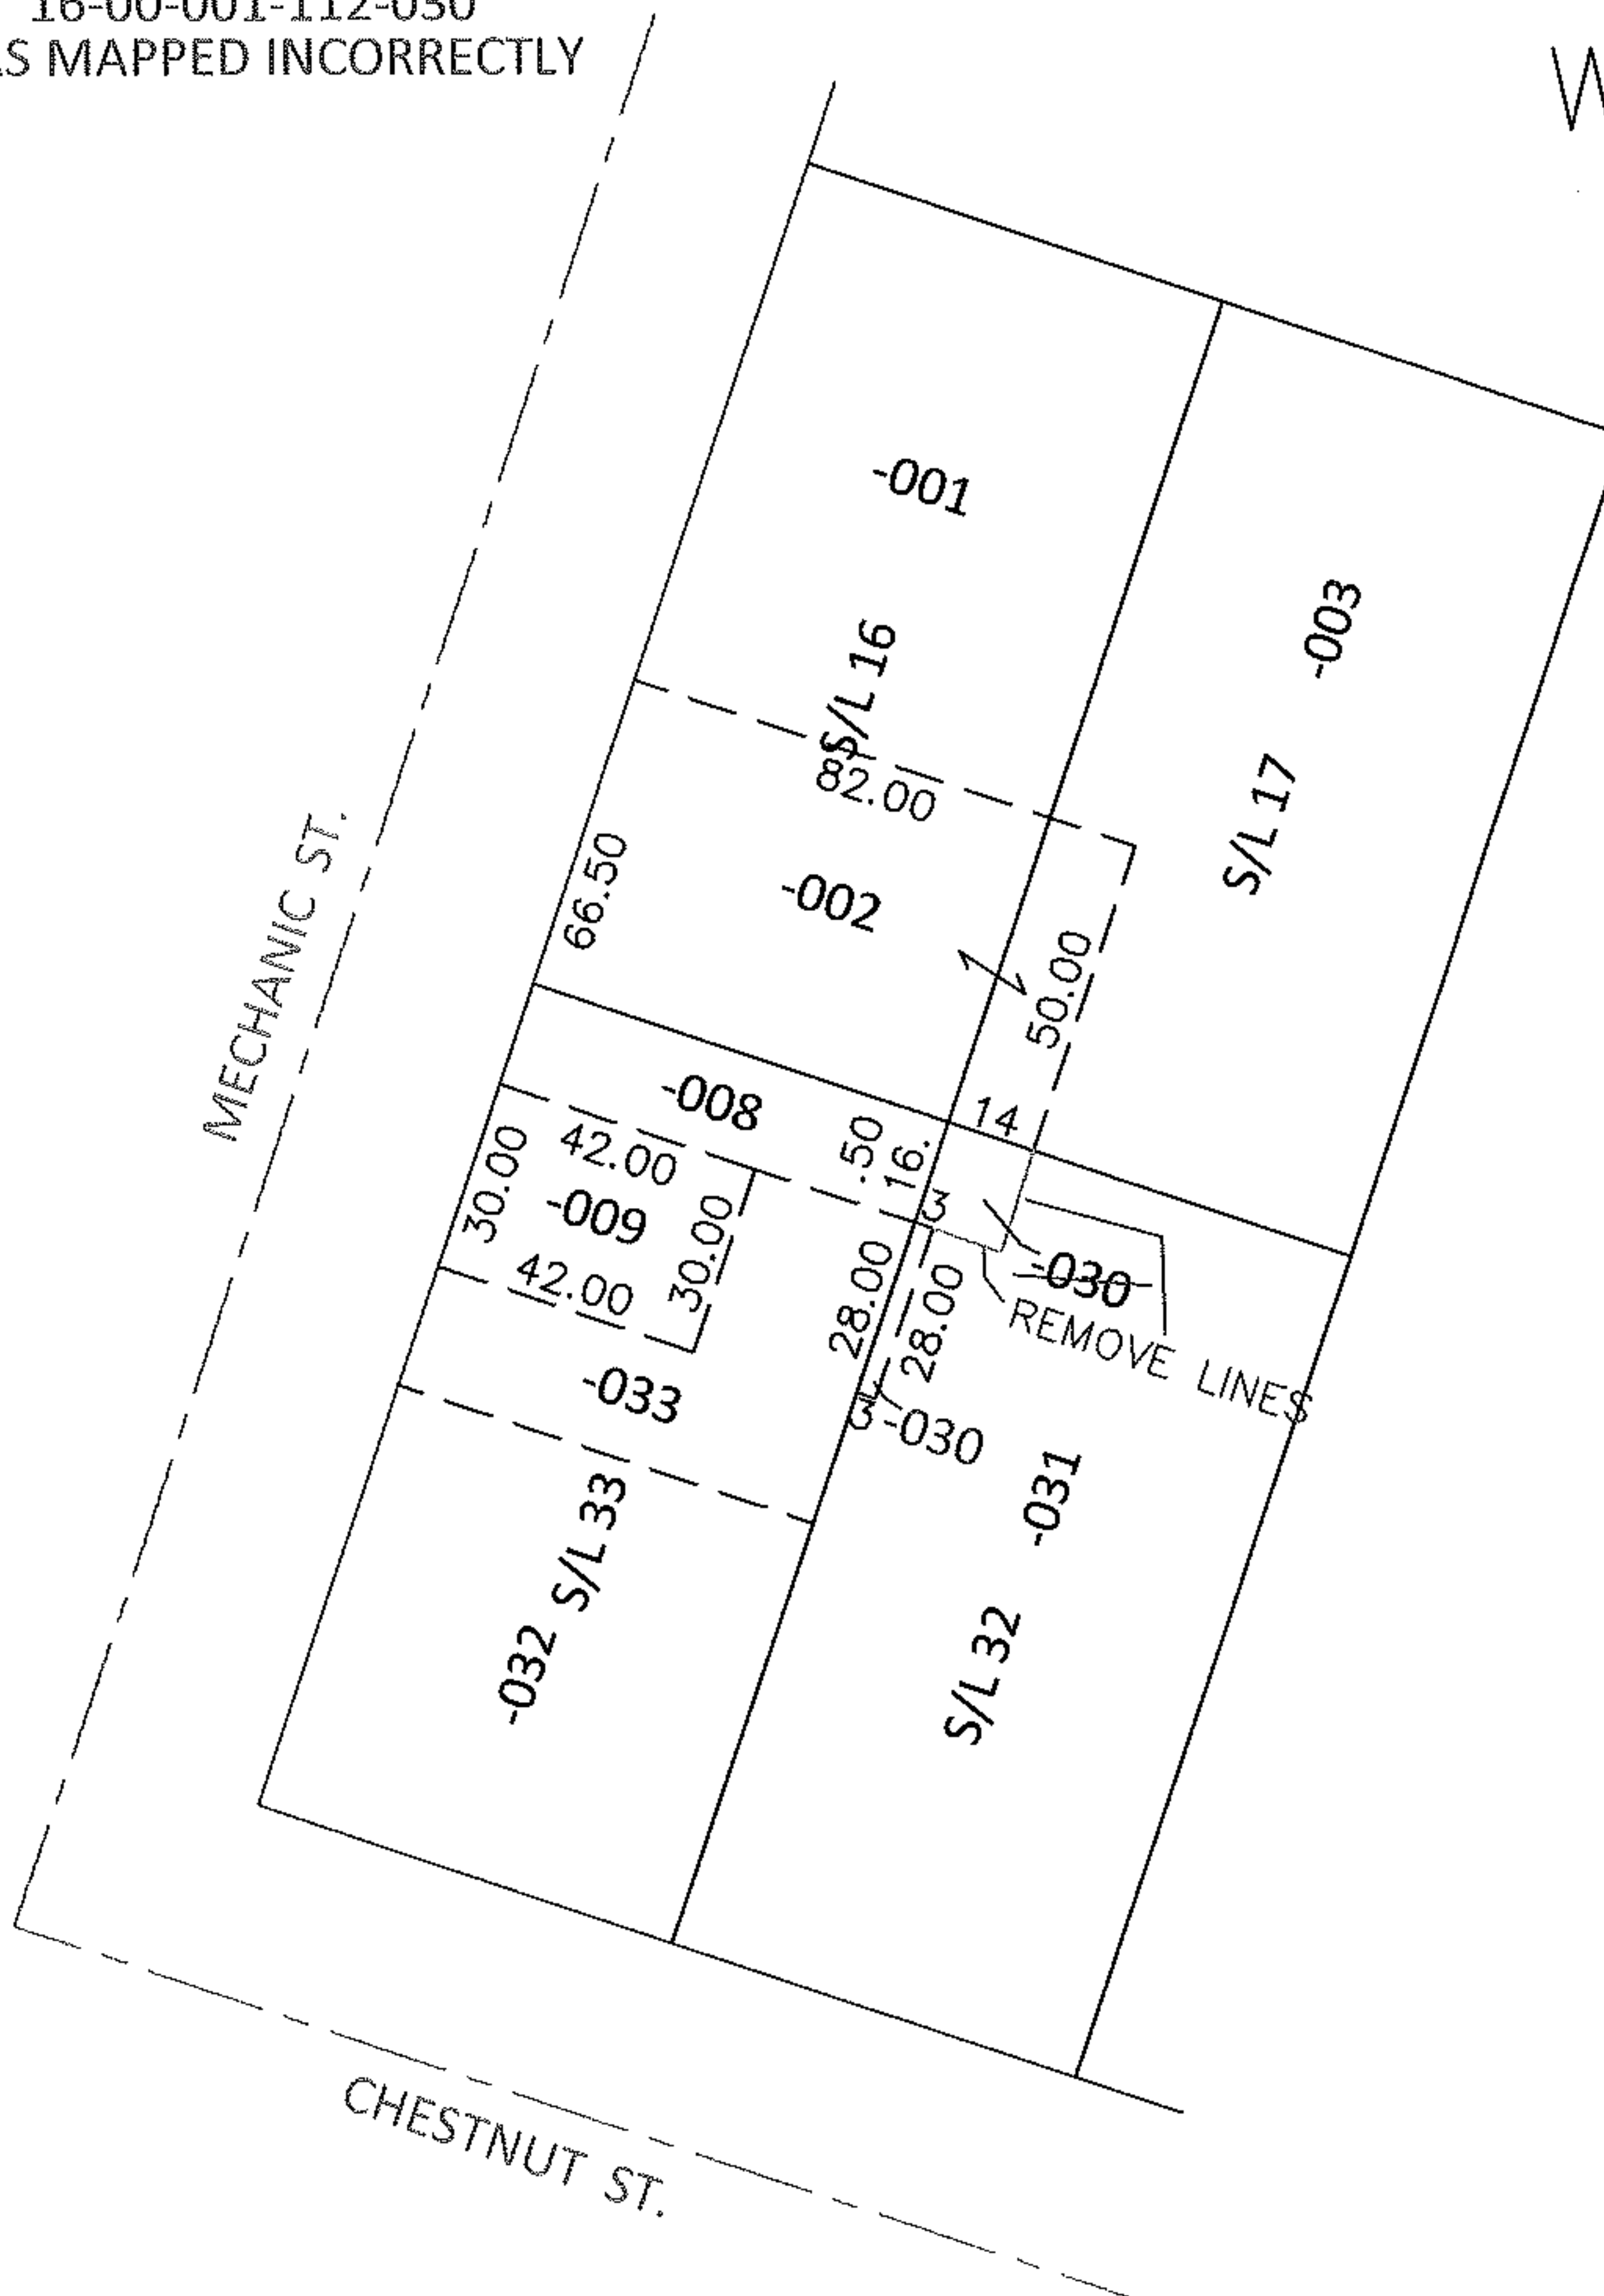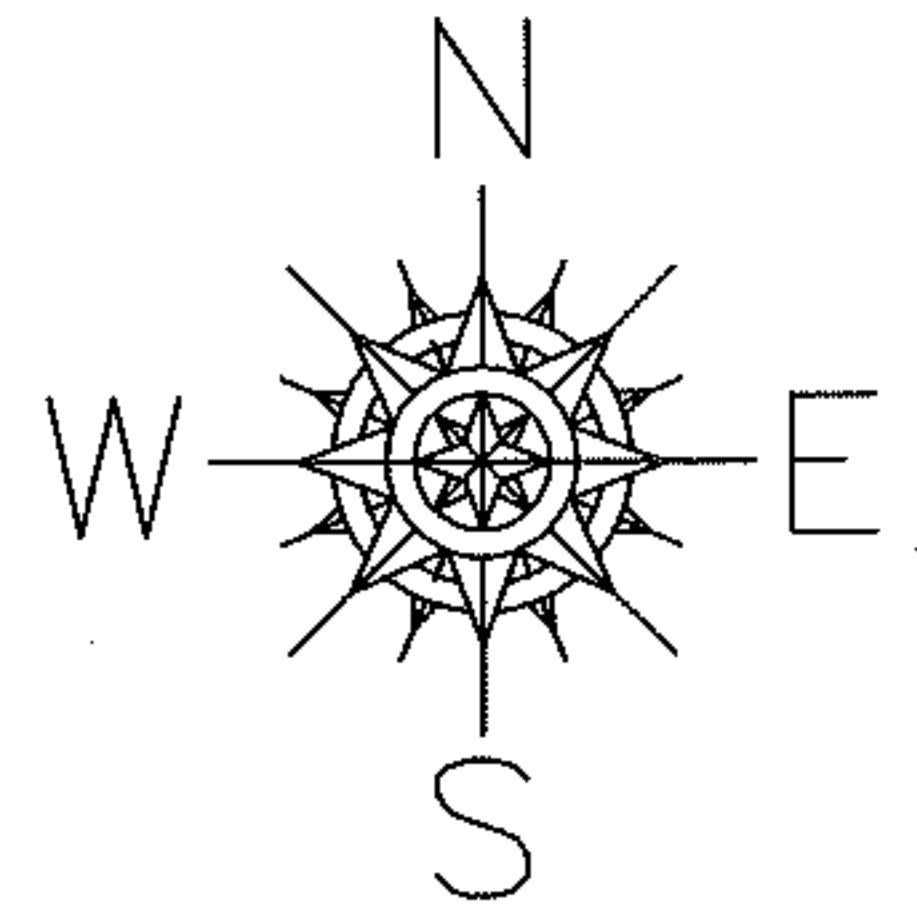

SPLITS/DEEDS PROCESSED

LORAIN COUNTY TAX MAP DEPARTMENT
226 MIDDLE AVE. ELYRIA, OHIO

SURVEYED BY: N/A

CLOSURE: N/A

MAP PAGE(S): 16-00-001-D

APPROVED BY: RRM DATE: 4-22-13

SCALE: 1" = 50' PRIOR INST.: 20030921317