


PARENT PARCEL: 06-26-008-103-016

CHILD PARCEL: XX-XX-XXX-XXX-XXX

STARTING POINT: XXXXXX

13-02713-C

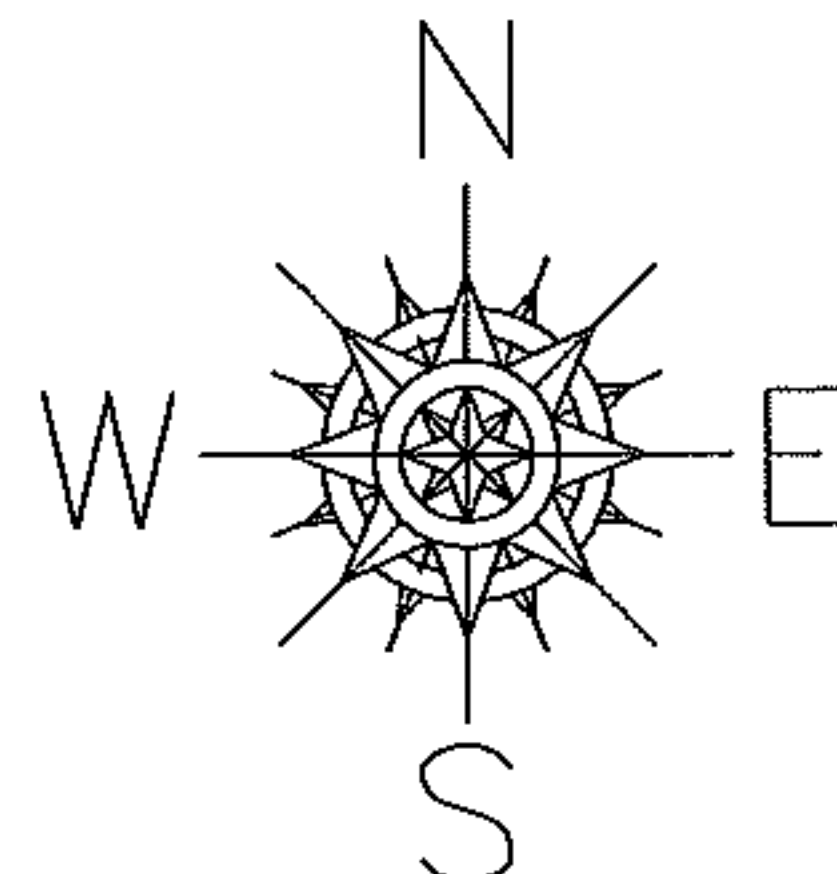

FRONTAGE CORRECTION

06-26-008-103-016

~~64.38 X 132~~


64.68 X 132

0.98 CH. X 2 CH.

CORR. PER PLAT

P.V. 2 PG. 19

13 TH. ST. 52'

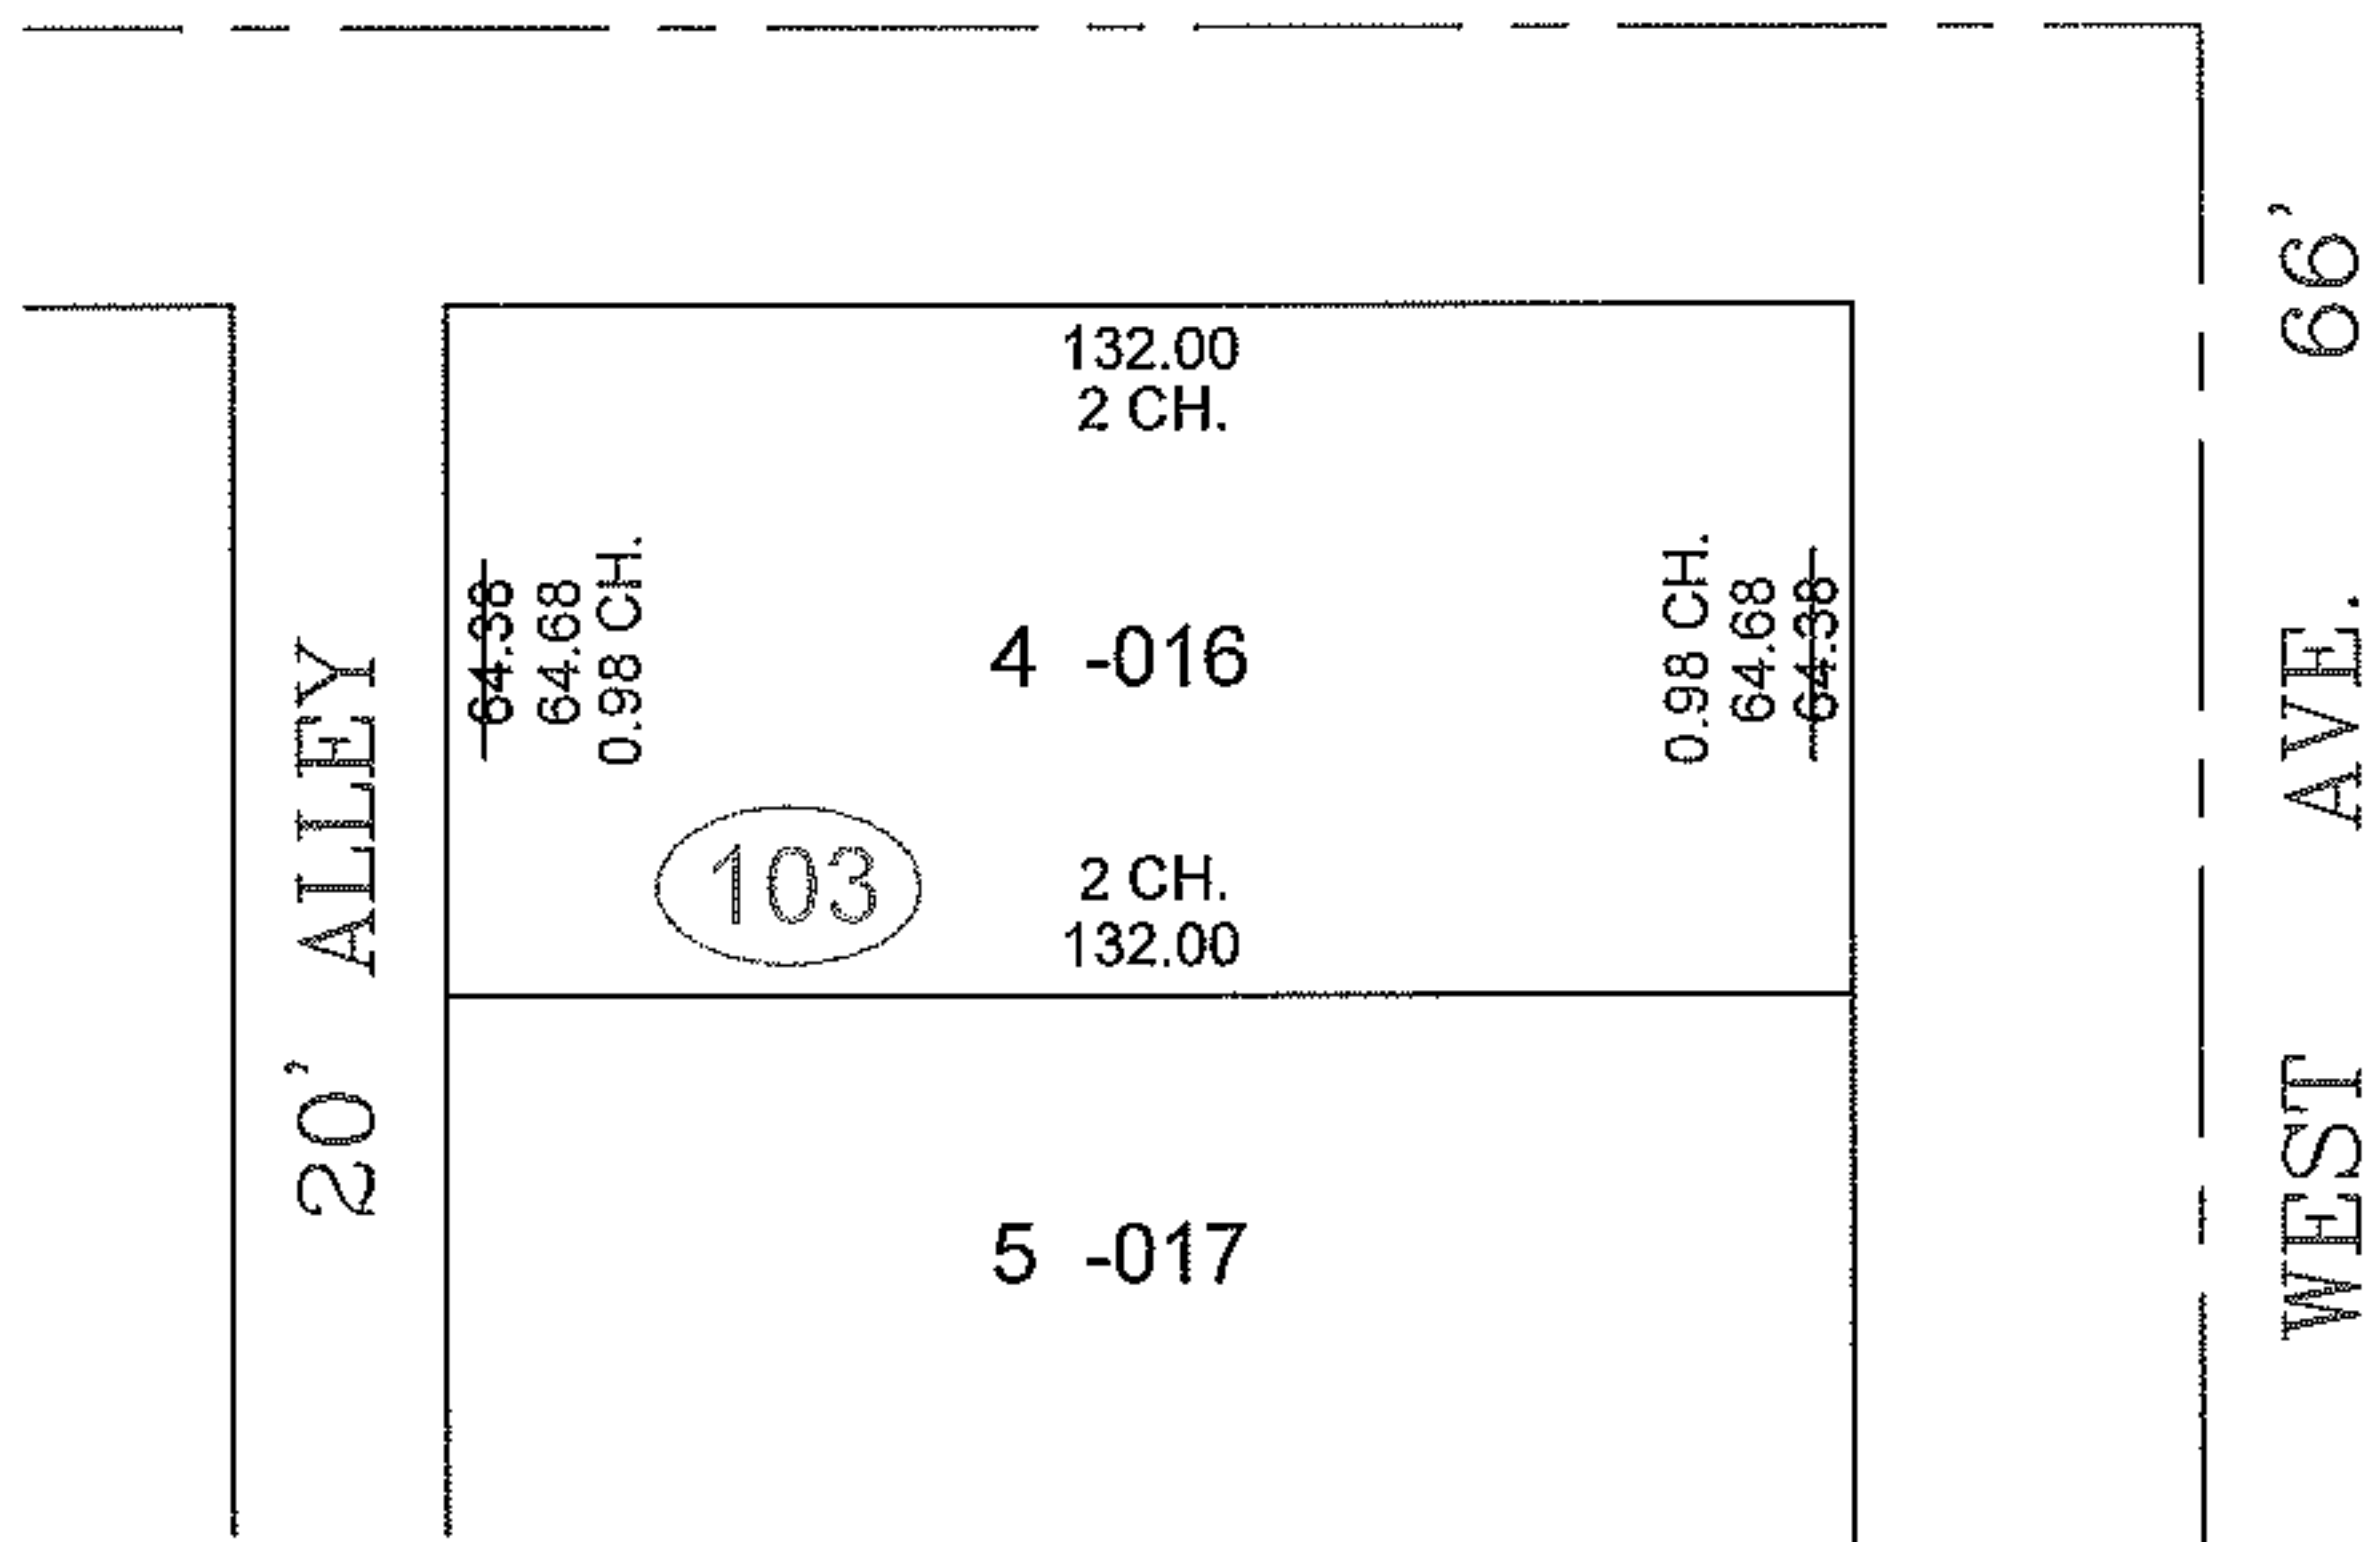

SPLITS/DEEDS PROCESSED

LORAIN COUNTY TAX MAP DEPARTMENT
226 MIDDLE AVE. ELYRIA, OHIO

SURVEYED BY: P.V. 2 PG. 19

CLOSURE: 0.00 : 10,000

MAP PAGE(S): 6-137

APPROVED BY: TJS DATE: 4/24/13

SCALE: 1"= 50' PRIOR INST.: DV XXXX/XXX