


PARENT PARCEL: 21-01-011-000-003 & -004

CHILD PARCEL: XX-XX-XXX-XXX-XXX

13-02714-A

STARTING POINT: 3/4" I.P. FD., CL OF CLARK RD. & THE SOUTH LINE OF LORAIN COUNTY, TRACT 1 O.L. 11

MAG. NAIL SET NEW LONDON EASTERN RD. 60' MAG. NAIL SET

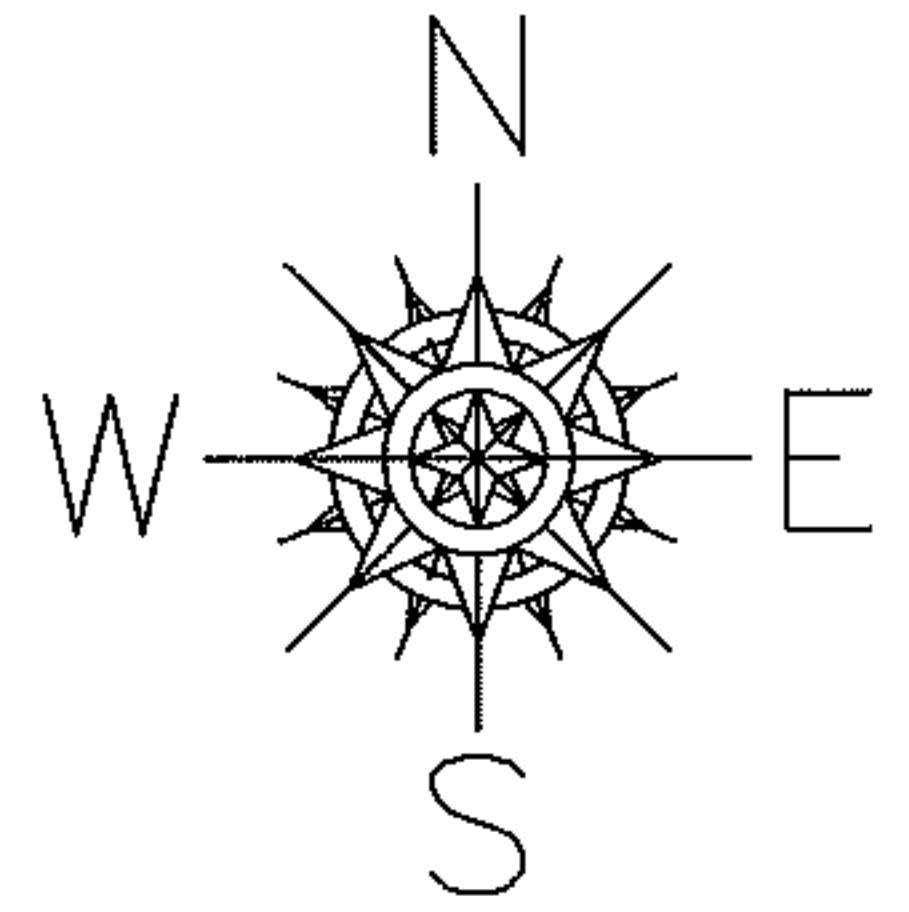

1167.64

CLARK RD. 60'

2090.44

-004  
~~54.47 A.~~  
56.02 A.  
AC. CORR. PER SURV.  
THOMAS M. SNEZEK

2082.70

MAG. NAIL SET

1171.46

~~4205-~~  
1171.46

-003

~~5.53 A.~~  
5.38 A.

AC. CORR. PER SURV.  
THOMAS M. SNEZEK

200.00

3/4" I.P. FD.

200.00  
1/2" I.P. FD.  
20.07' OFF CL

LORAIN COUNTY  
ASHLAND COUNTY

1171.83  
~~4205-~~

TRACT 1, O.L. 11

PRIOR INST.: 20120427519

PRIOR INST.: DV 1172/943

SPLITS/DEEDS PROCESSED

LORAIN COUNTY TAX MAP DEPARTMENT  
226 MIDDLE AVE. ELYRIA, OHIO

SURVEYED BY: THOMAS M. SNEZEK

CLOSURE: 0.01 : 10,000

MAP PAGE(S): 21-F

APPROVED BY: TJS DATE: 4/25/13

SCALE: 1" = 300