
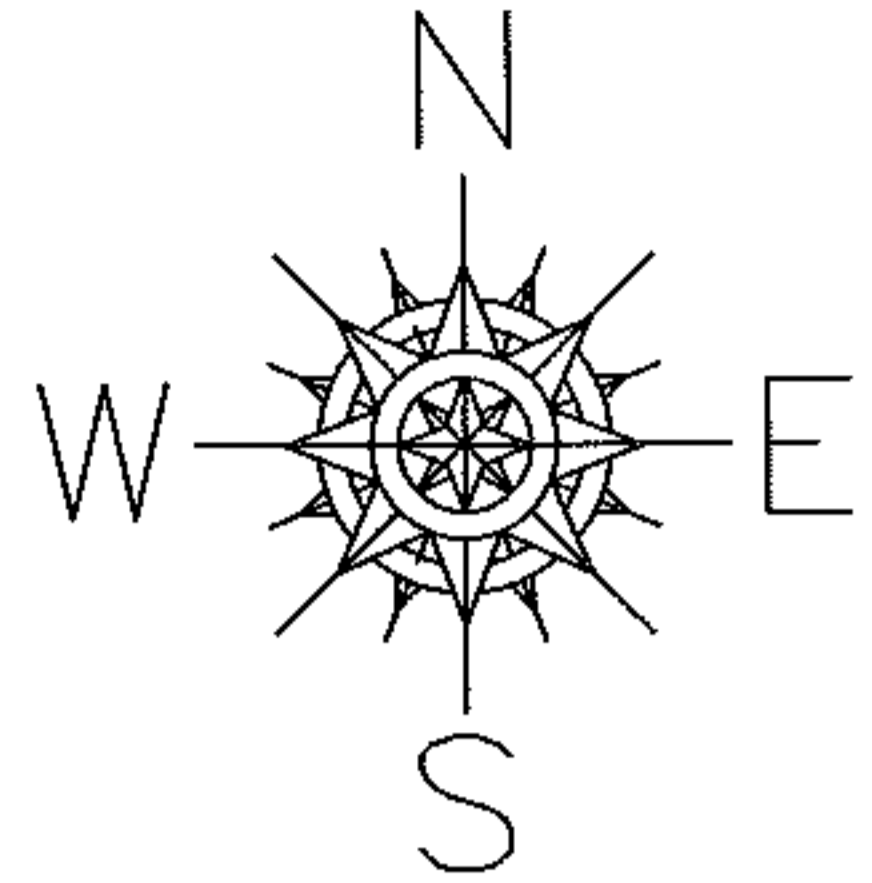


PARENT PARCEL: 07-00-033-101-010, 07-00-028-101-088 (ST)

CHILD PARCEL: 07-00-033-101-020, -021

STARTING POINT: CENTERLINE OF CENTER RIDGE RD & STONEY RIDGE RD

09-02714

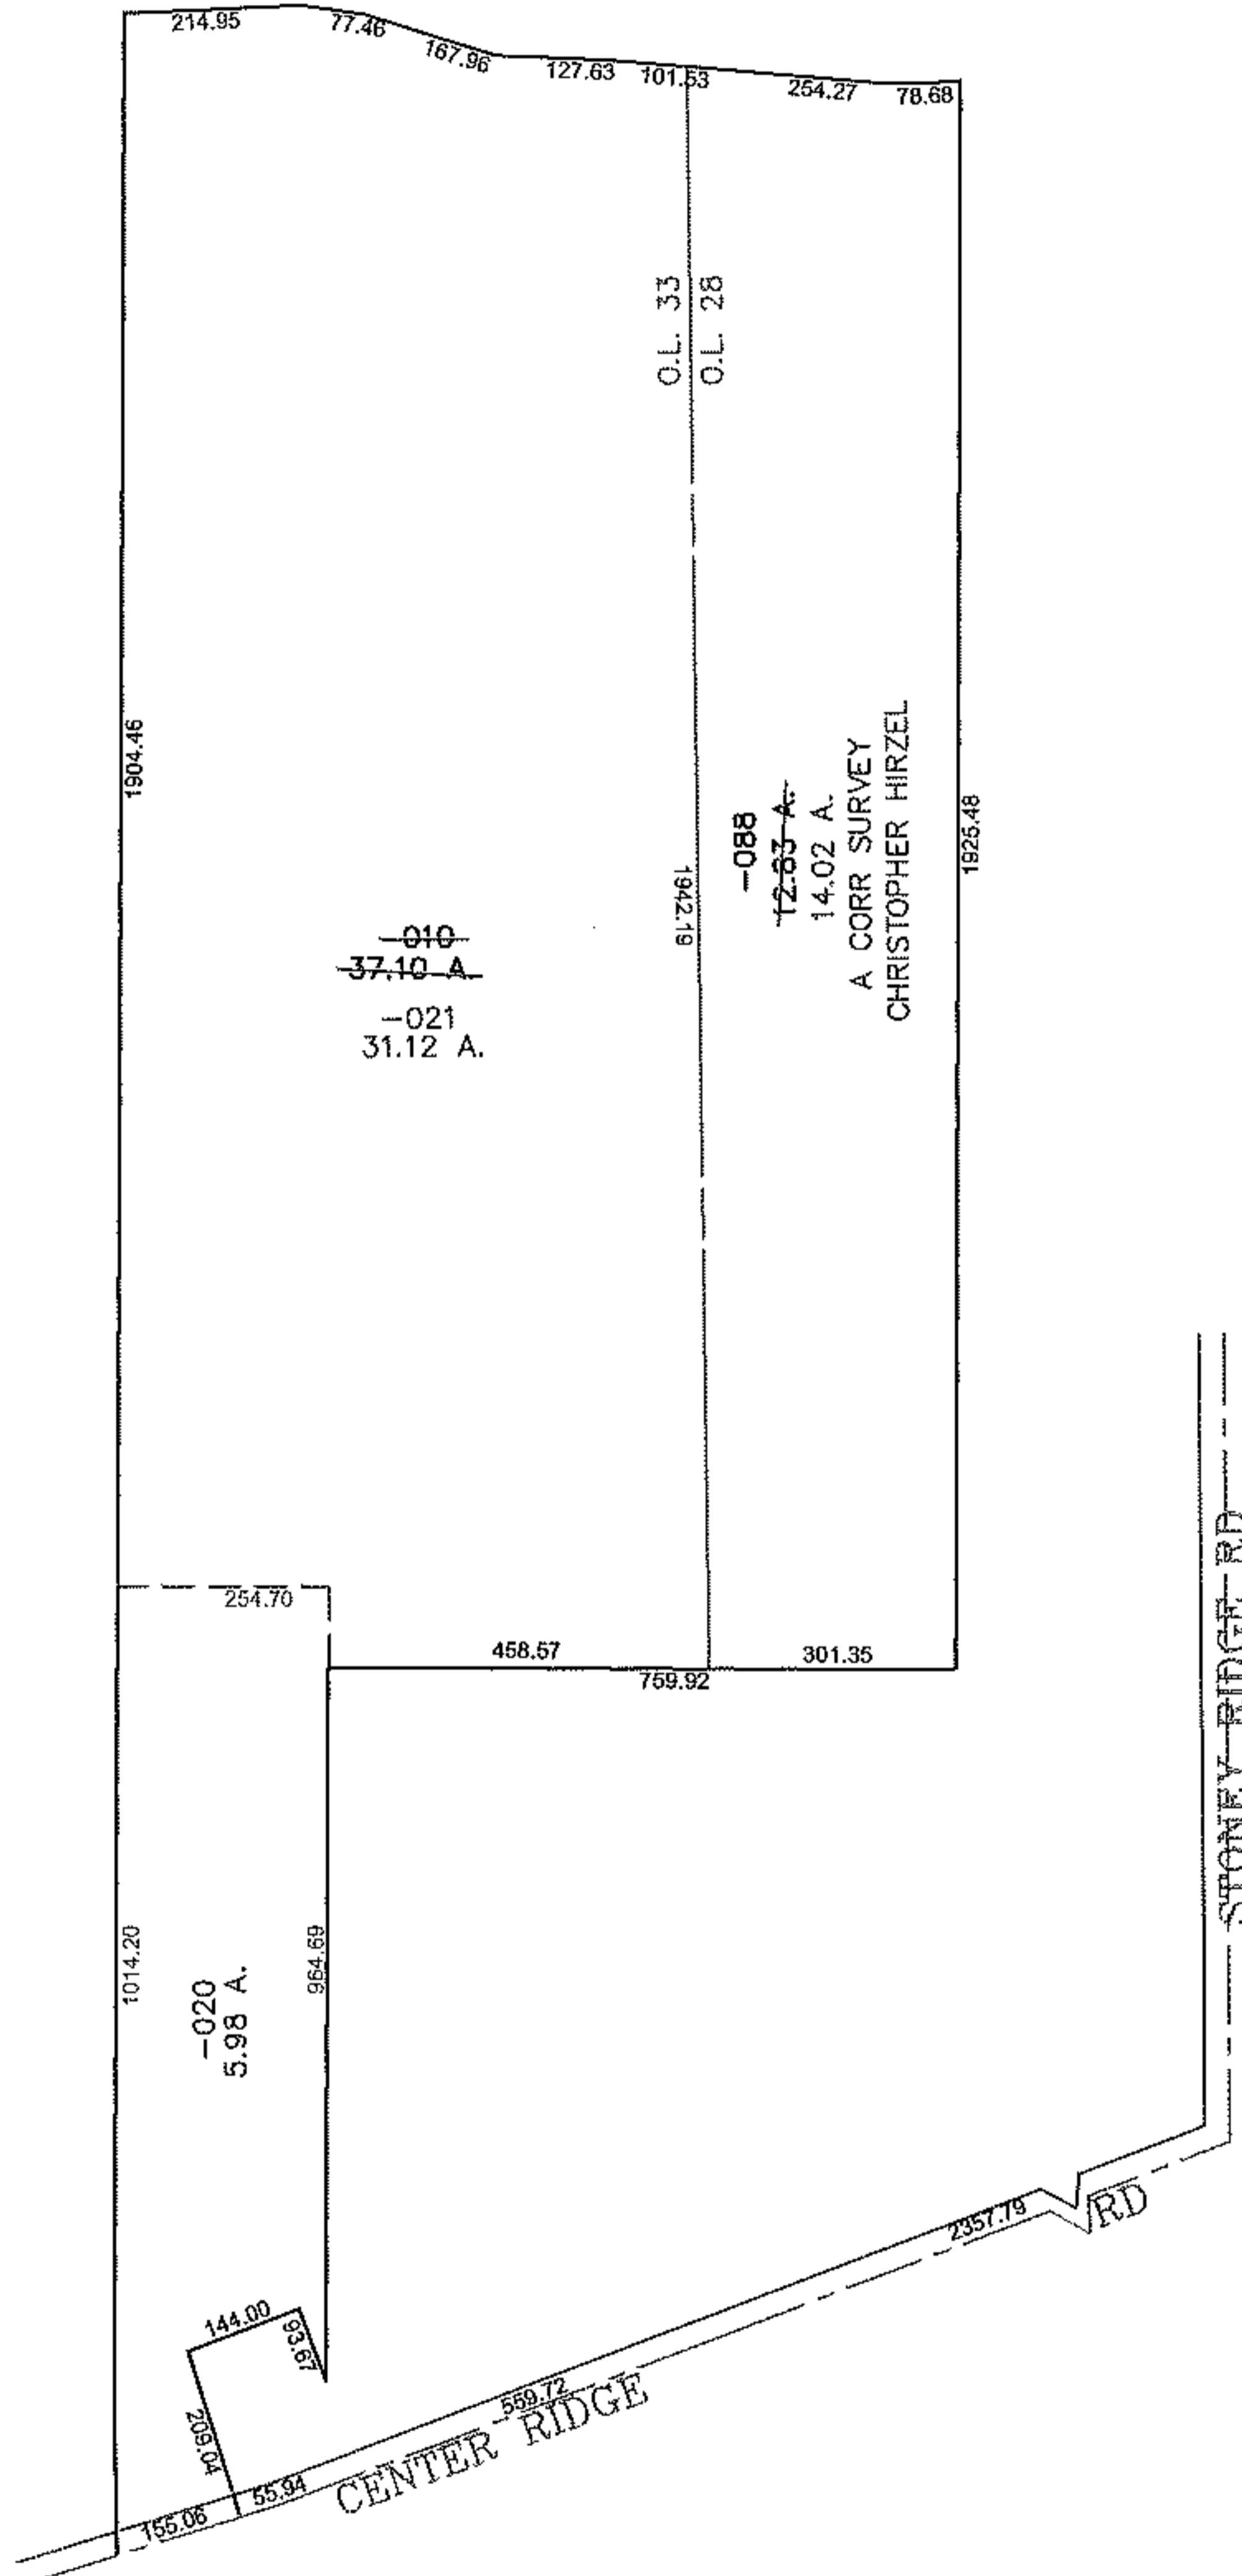

**SPLITS/DEEDS PROCESSED**

LORAIN COUNTY TAX MAP DEPARTMENT  
226 MIDDLE AVE. ELYRIA, OHIO

SURVEYED BY: CHRISTOPHER HIRZEL

CLOSURE: 0.00 : 10.000

MAP PAGE(S): 7-B

APPROVED BY: JAH DATE: 06-29-09

SCALE: 1" = 400 PRIOR INSTRUMENT: 20070236217